
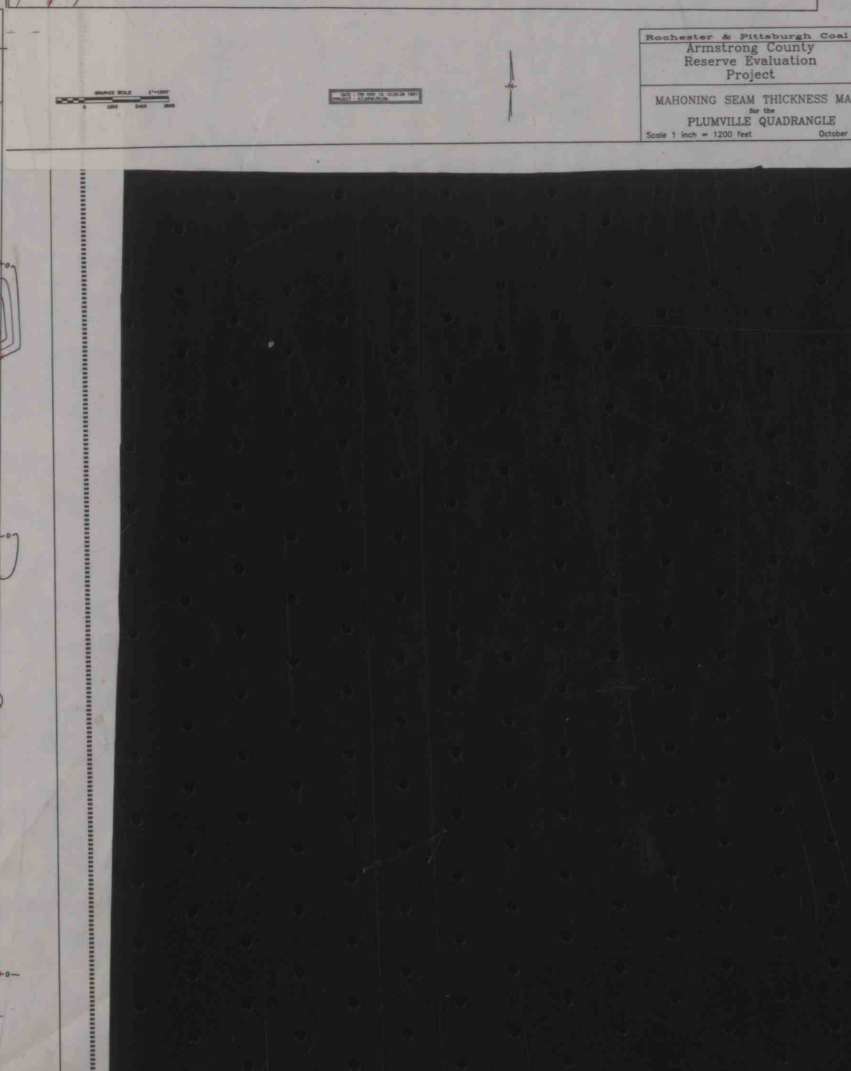
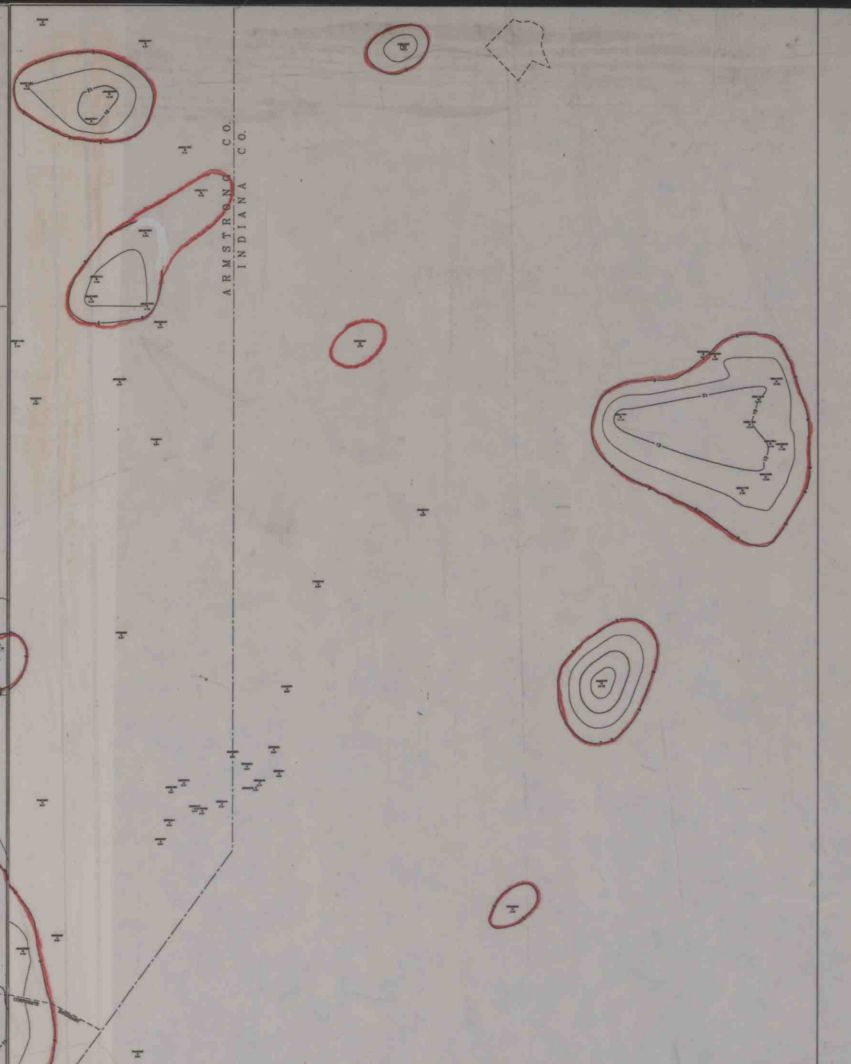
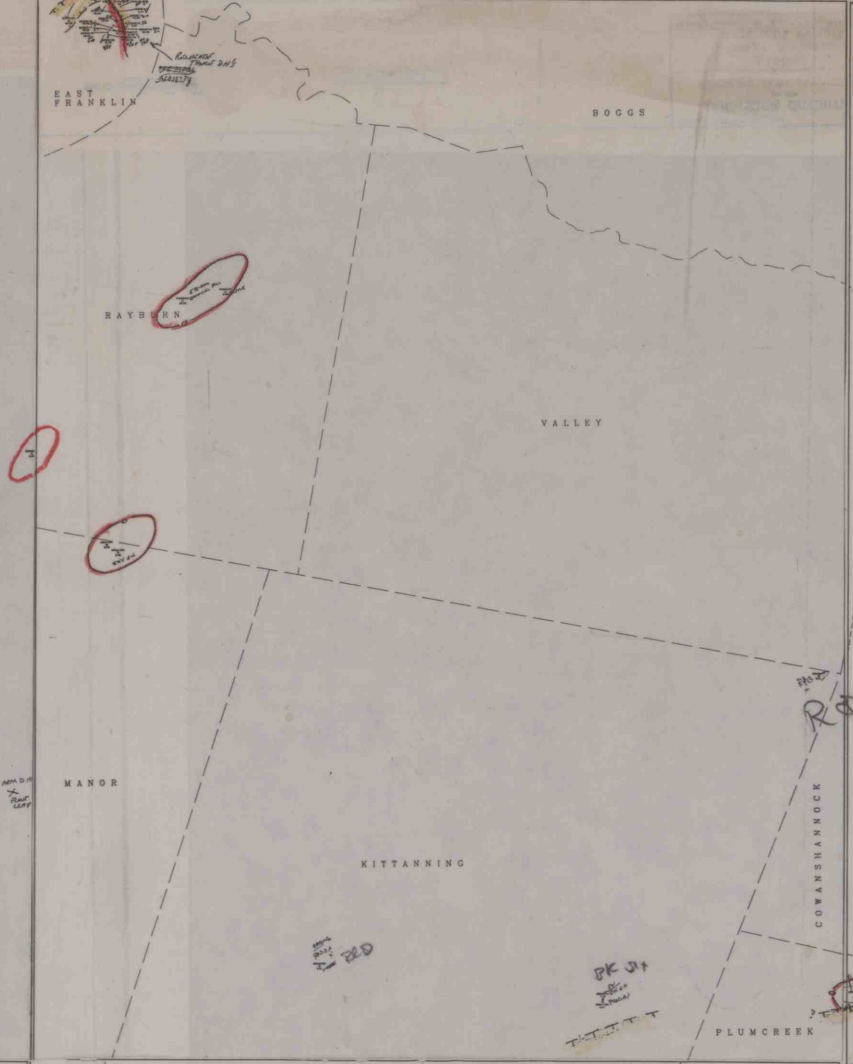
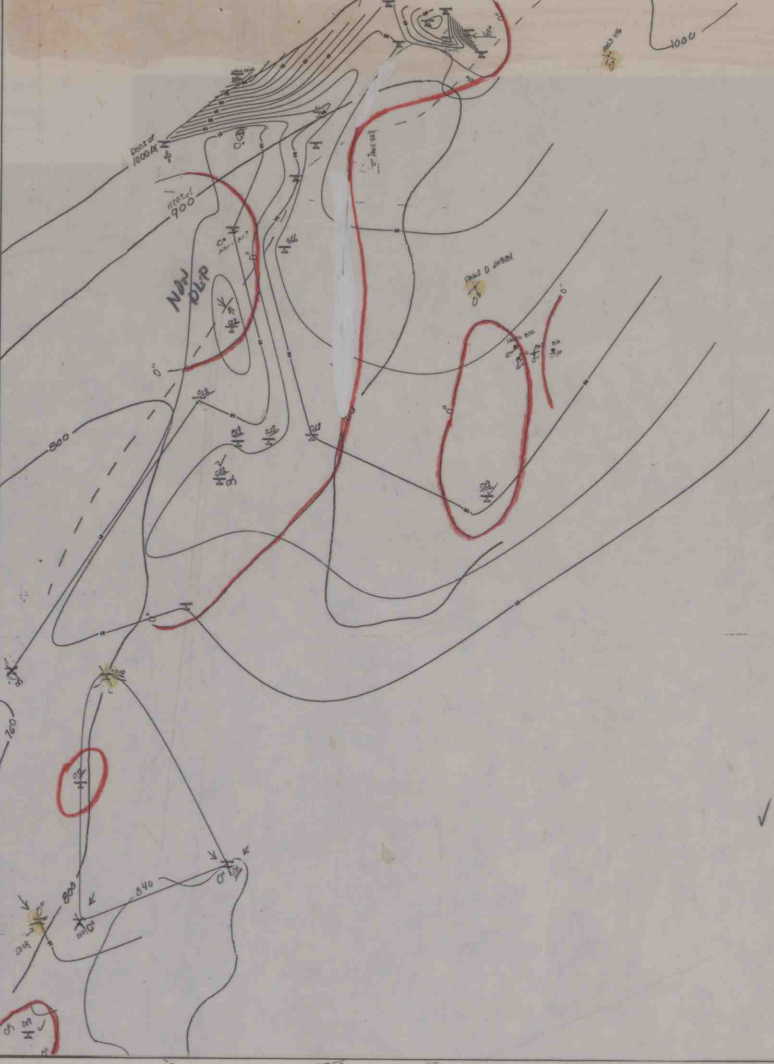


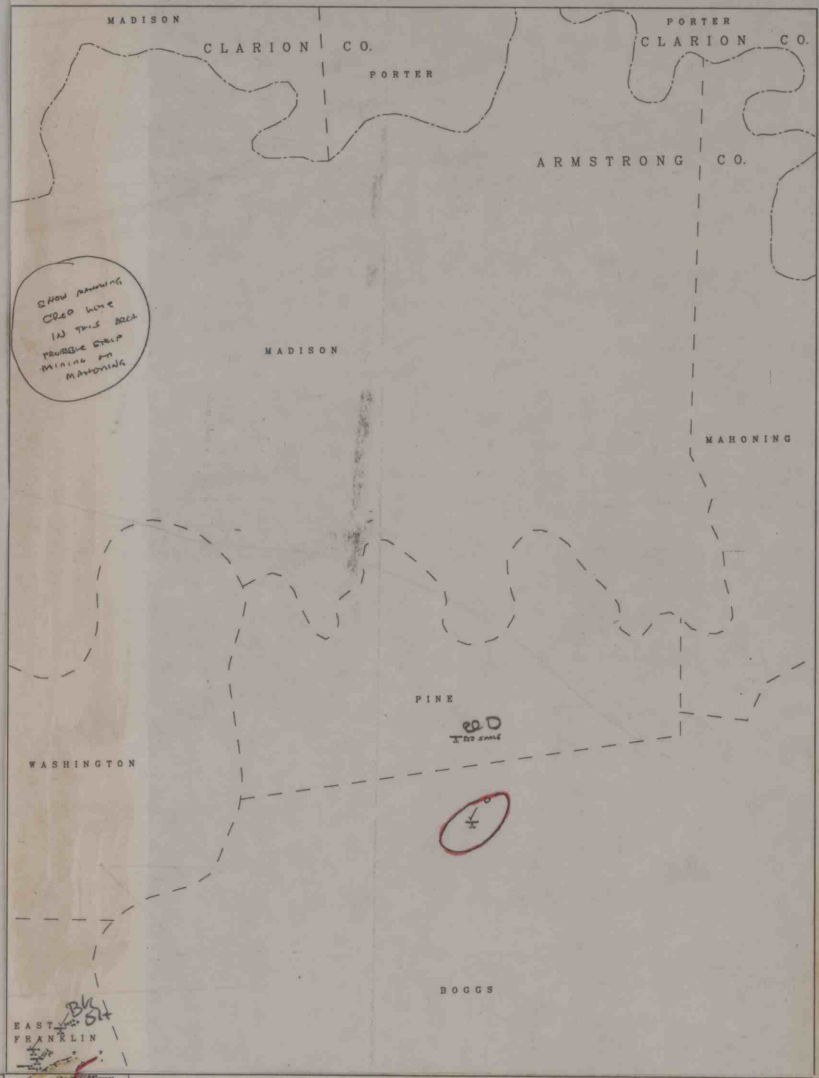

IMAP# 18573

Armstrong County
Reserve Evaluation
Project
MAHONING SEAM THICKNESS MAP

Armstrong County
Reserve Evaluation
Project
MAHONING SEAM THICKNESS MAP
WHITESBURG QUADRANGLE

Armstrong County
Reserve Evaluation
Project
MAHONING SEAM THICKNESS MAP
ELDERTON QUADRANGLE
