
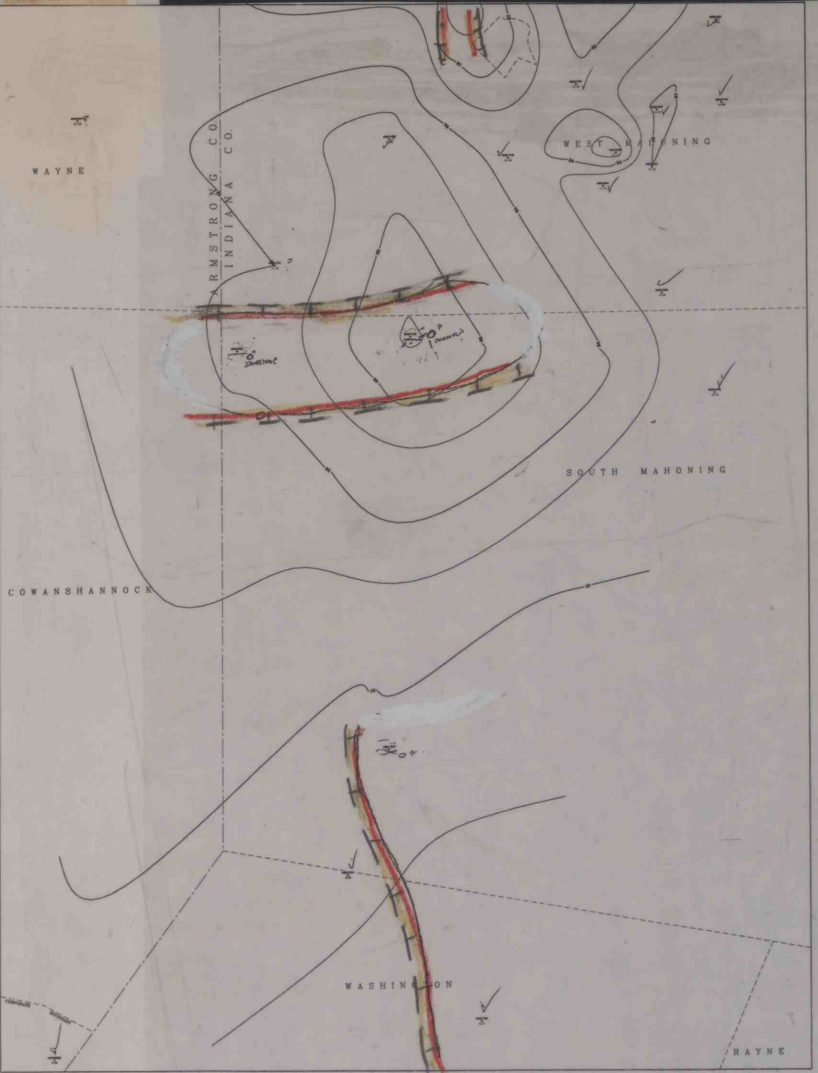
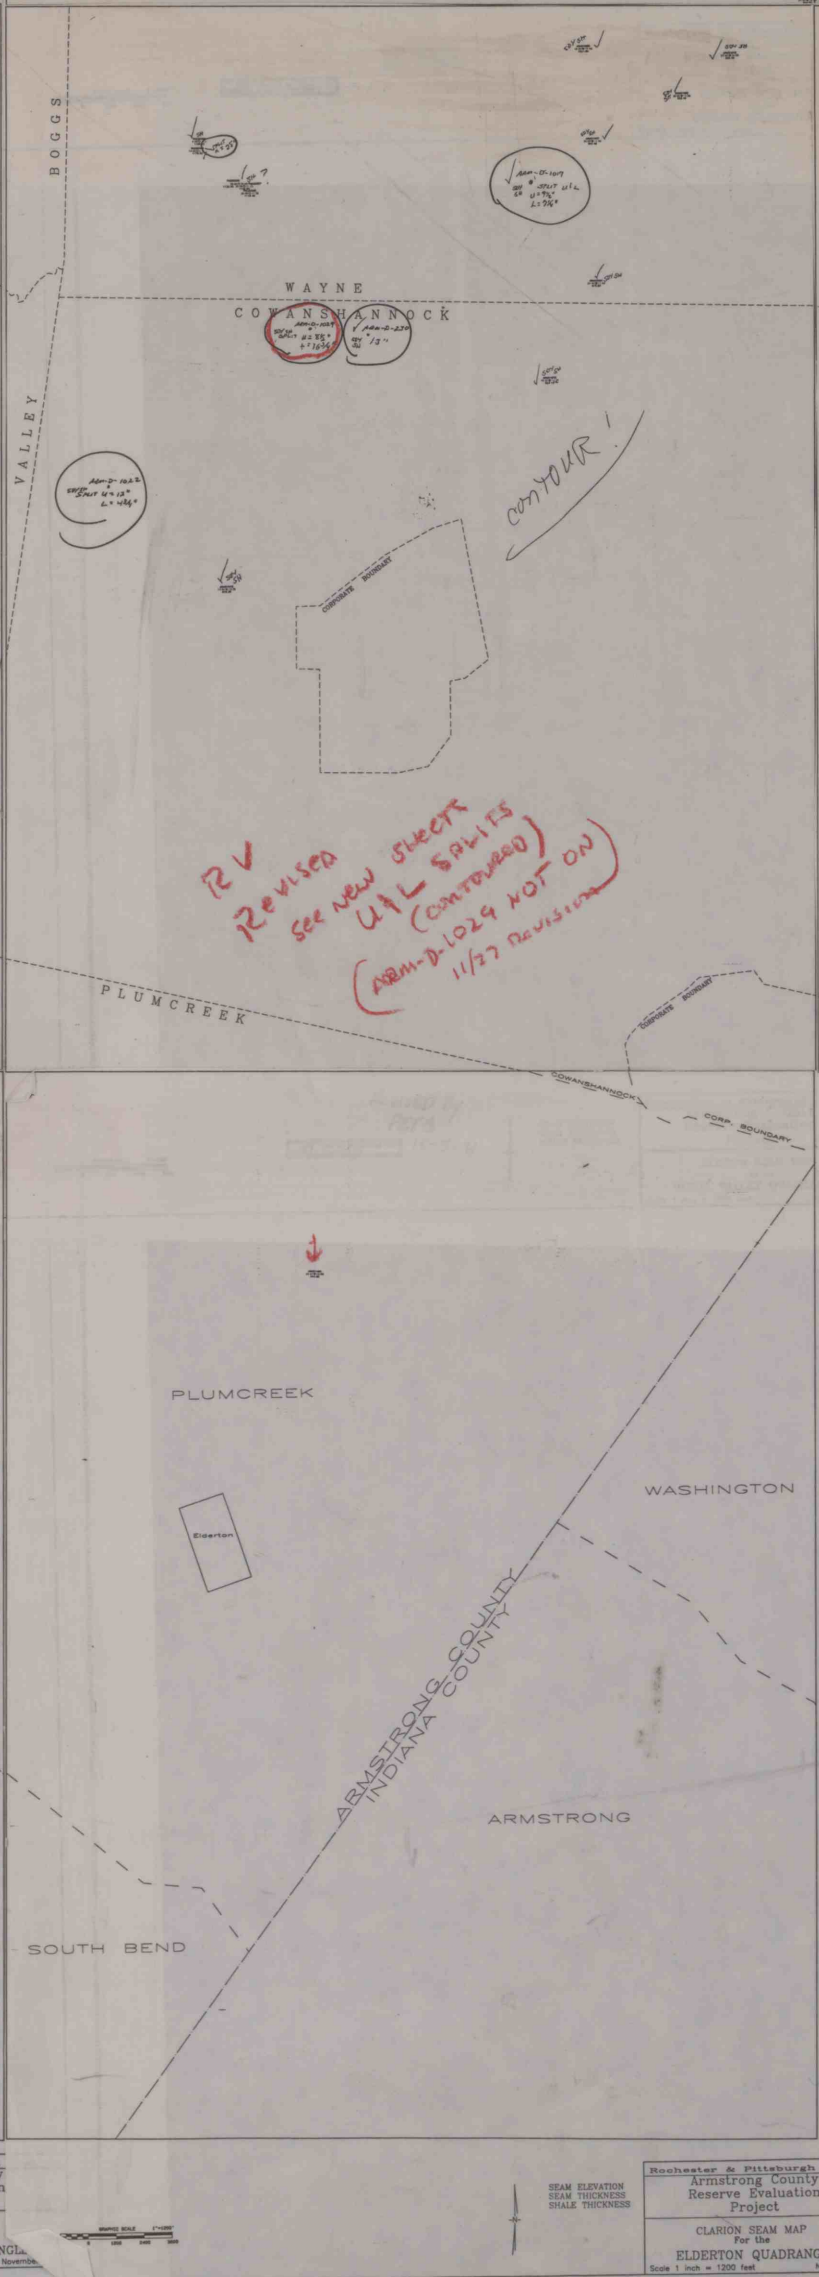


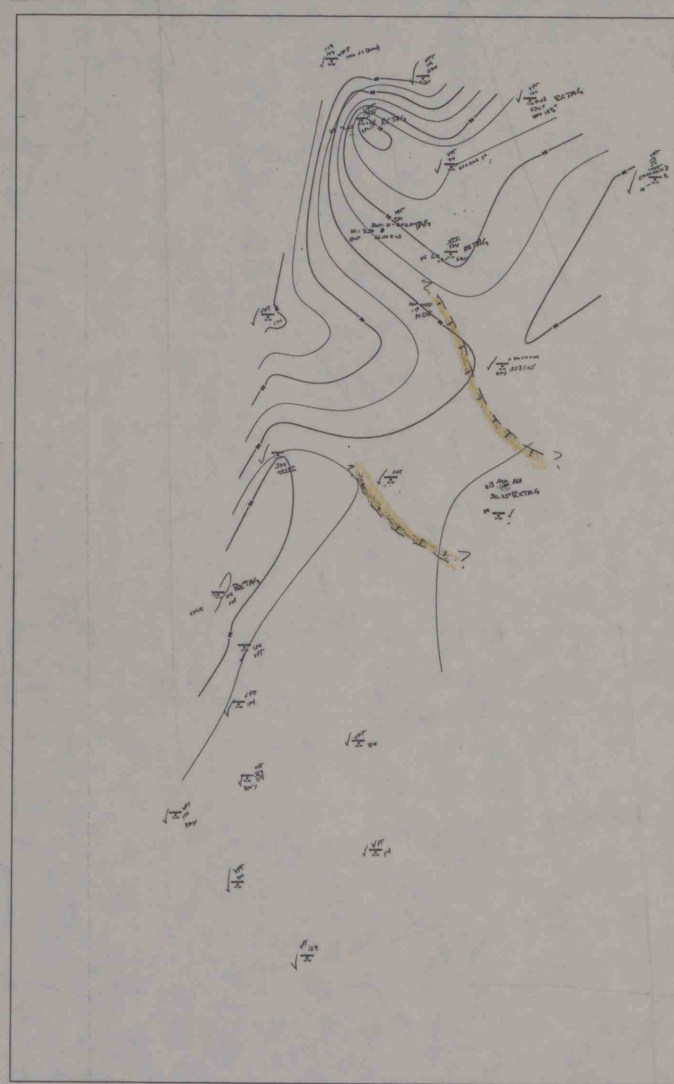

RV
Revised
see new sheets

Armstrong County
Reserve Evaluation
Project
CLARION SEAM THICKNESS
PLUMVILLE QUADRANGLE
Scale 1 inch = 1000 feet

Armstrong County
Reserve Evaluation
Project
CLARION SEAM MAP
LEITCHBURG QUADRANGLE
Scale 1 inch = 1000 feet

Armstrong County
Reserve Evaluation
Project
CLARION SEAM MAP
WHITESBURG QUADRANGLE
Scale 1 inch = 1000 feet

Armstrong County
Reserve Evaluation
Project
CLARION SEAM MAP

IMAPS# 18574