


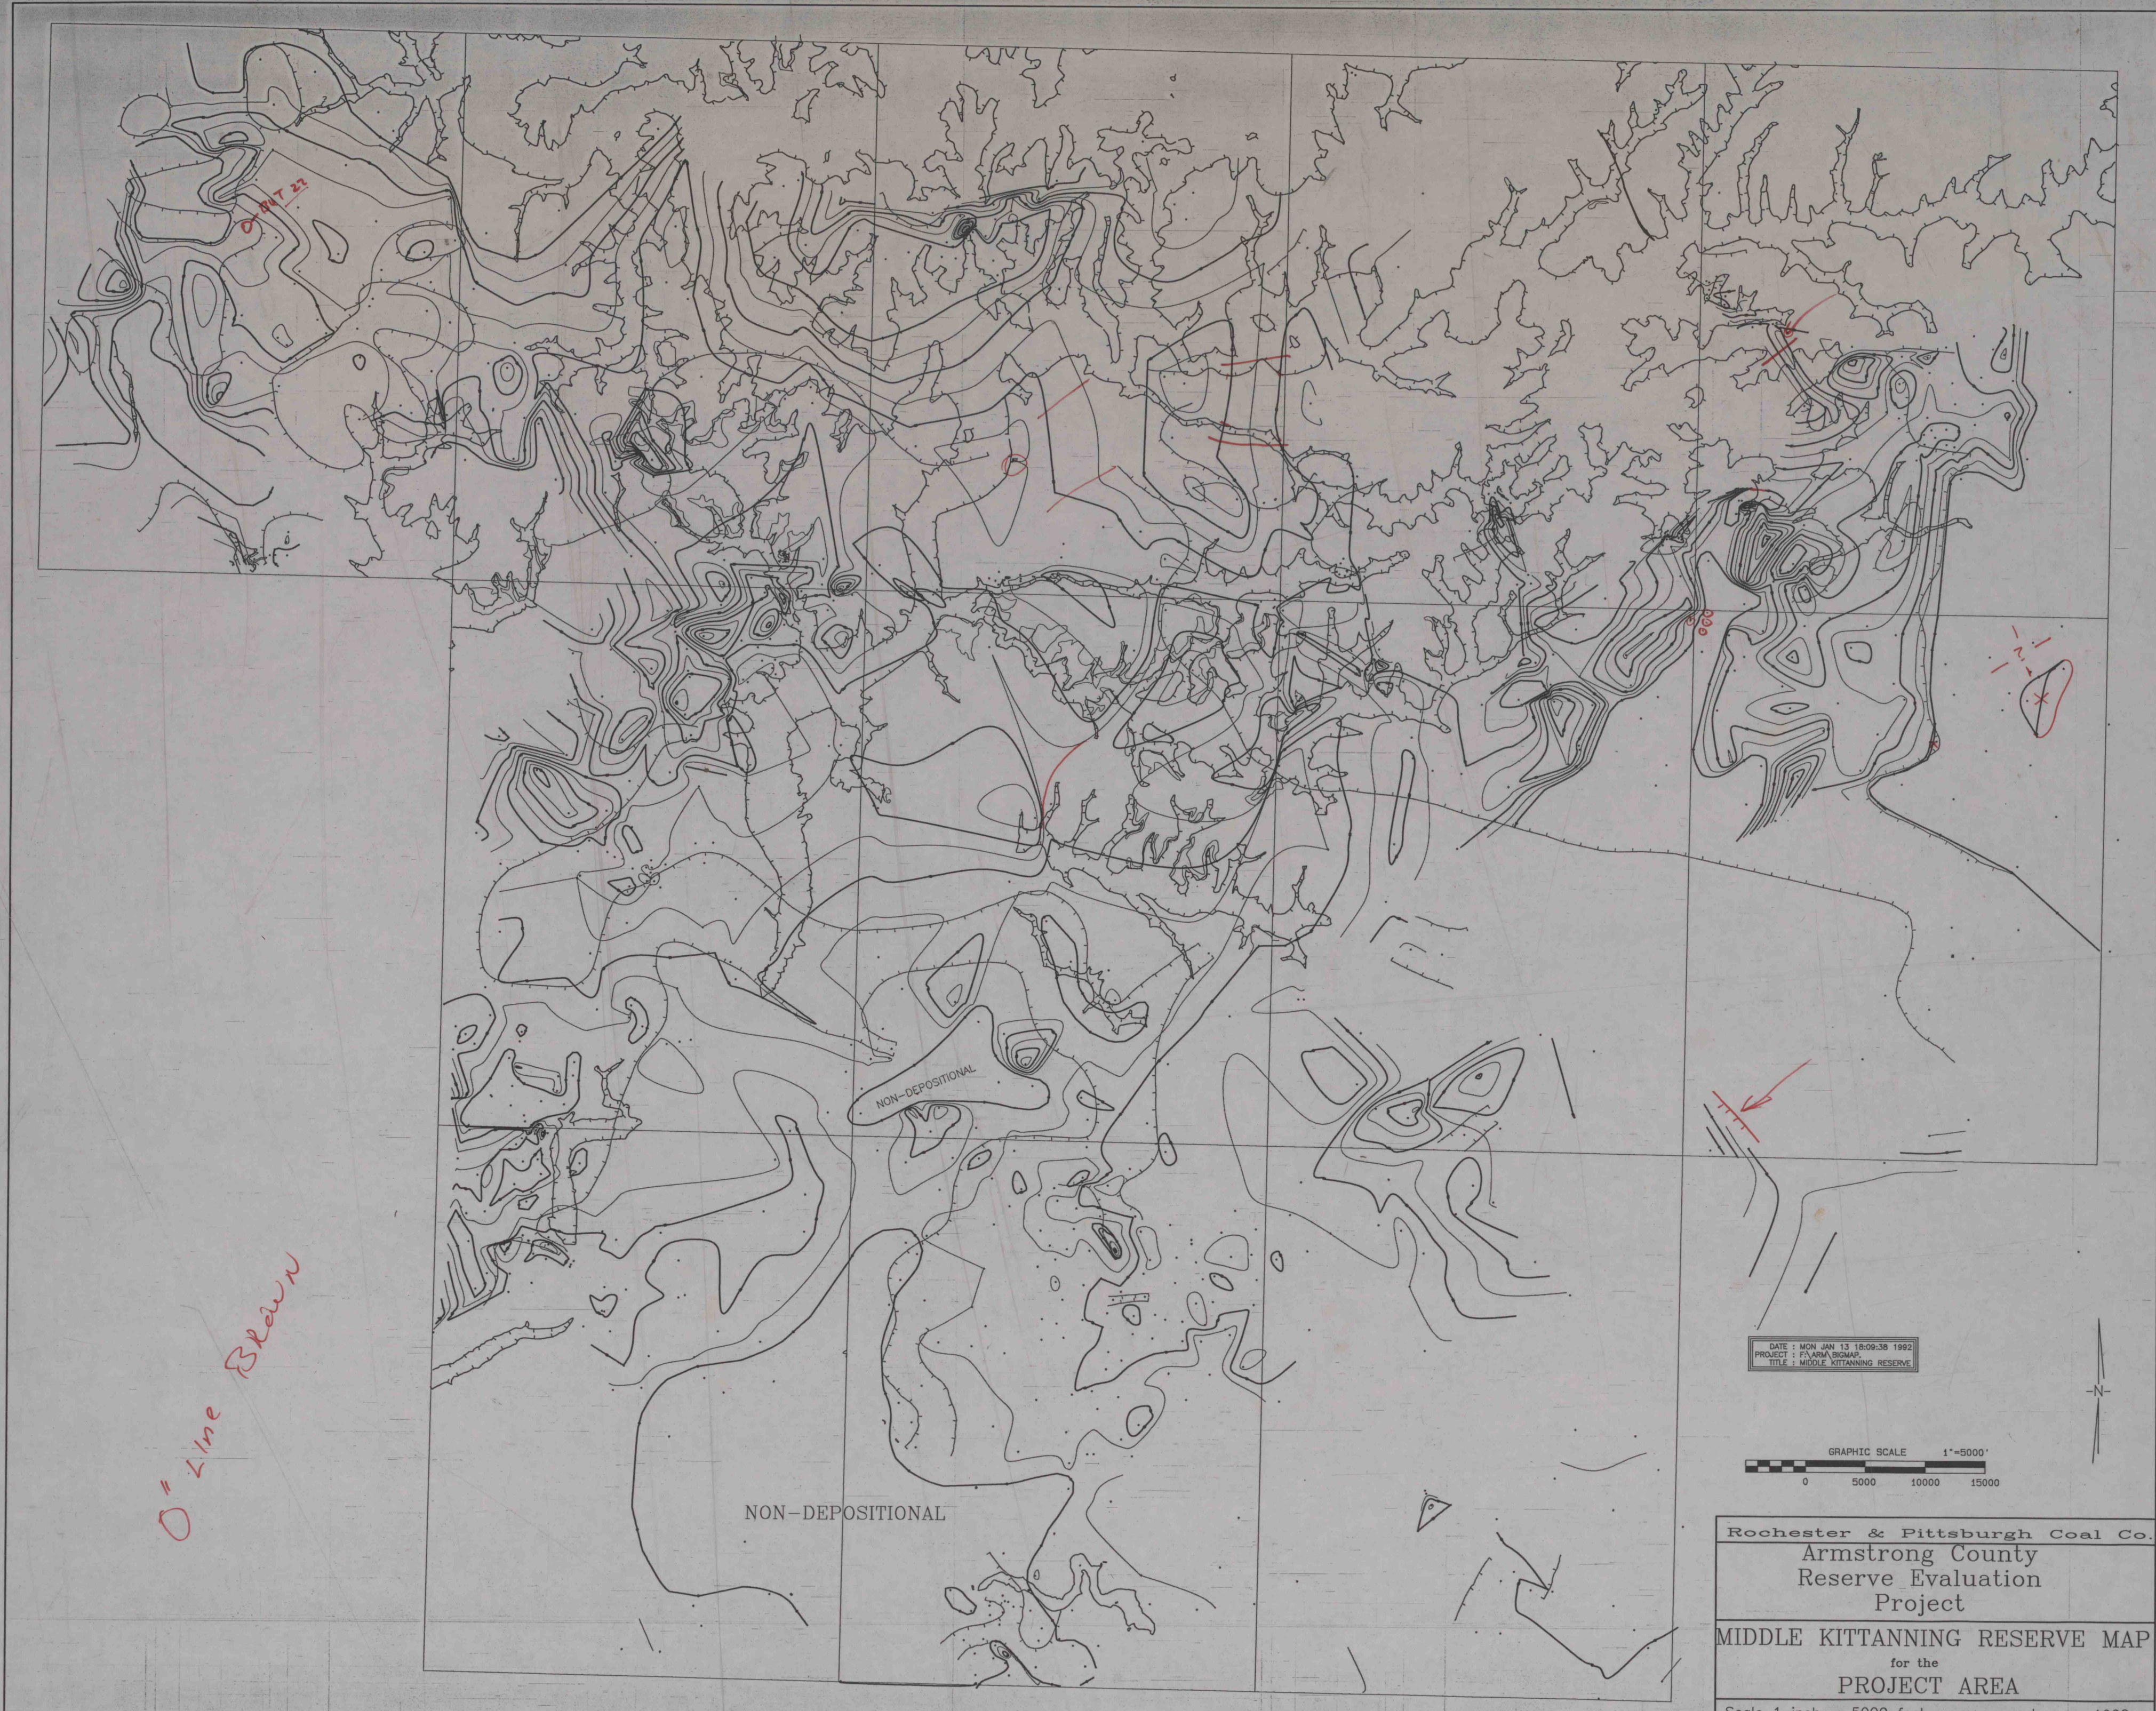

0" Line Brown

DATE : MON JAN 13 18:09:38 1992
TITLE : MIDDLE KITTANNING RESERVE

GRAPHIC SCALE 1"=5000'
0 5000 10000 15000

Rochester & Pittsburgh Coal Co.
Armstrong County
Reserve Evaluation
Project
MIDDLE KITTANNING RESERVE MAP
for the
PROJECT AREA
Scale 1 inch = 5000 feet January 1992