


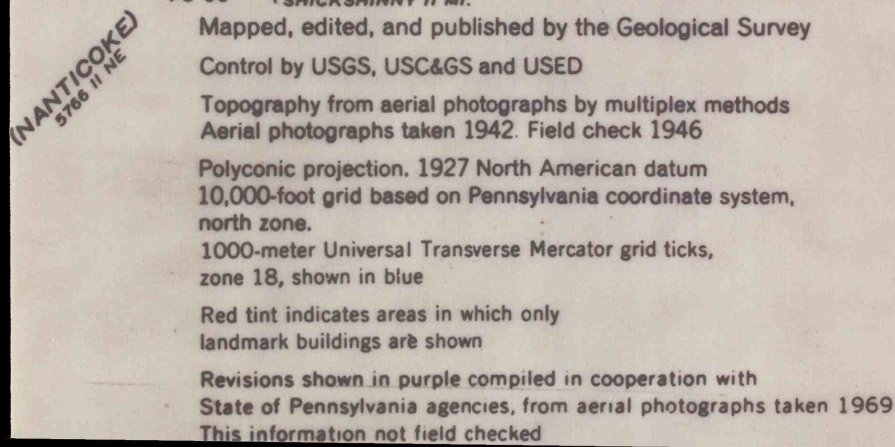

ROAD CLASSIFICATION

Heavy-duty		Light-duty	
Medium-duty		Unimproved dirt	

 U.S. Route  State Route

KINGSTON, PA.
N4115-W7552.5/7.5
1946
PHOTOREVISED 1969
AMS 5866 IV SW-SERIES V831

IMAPS # 18627