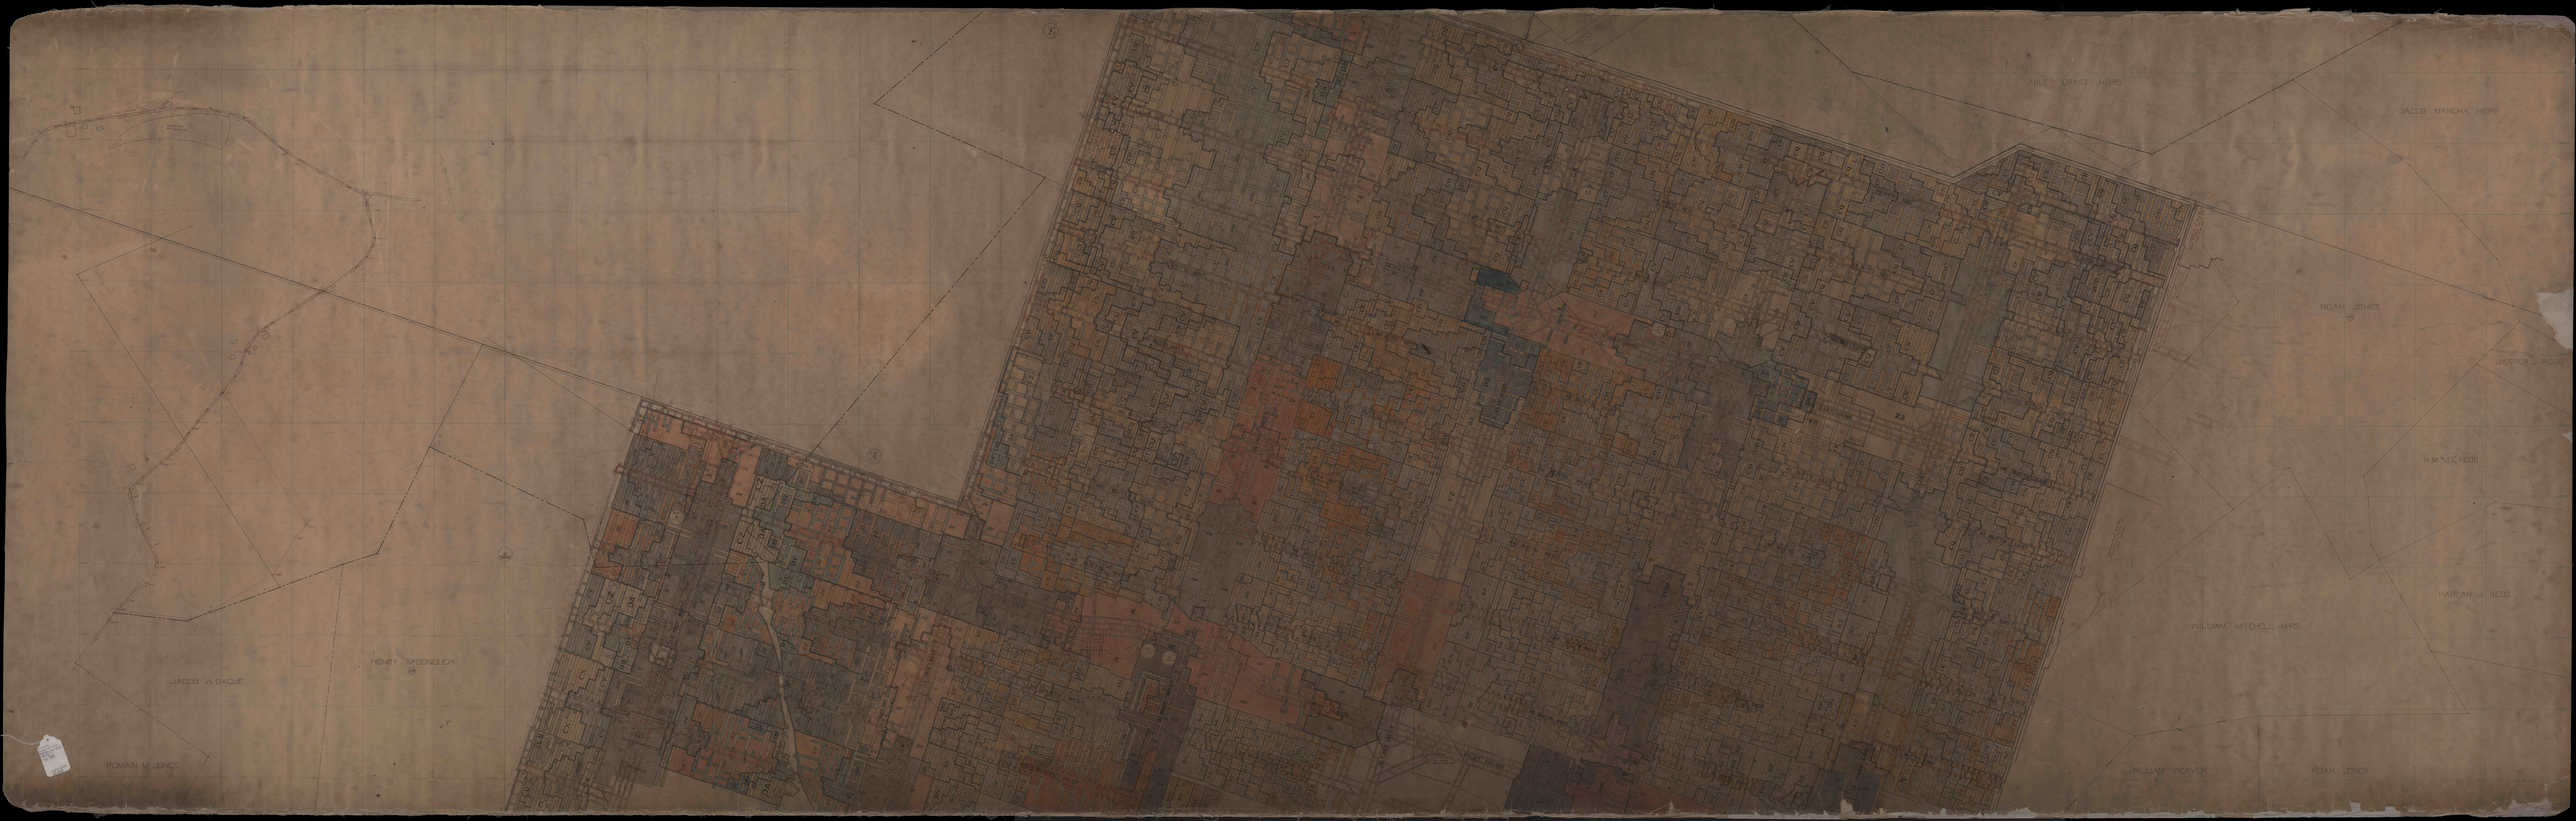

ABLE CRAFT HEIRS
JACOB MANCHA HEIRS
NOAH JONES
37
JASPER J. REDD
H. M. & J. E. REDD
HARLAN J. REDD
WILLIAM MITCHELL H'RS
WILLIAM WEAVER
NOAH JONES
W. W. MORTON
58
55 BUTTS EAST
53 BUTTS EAST
51 BUTTS EAST
49 BUTTS EAST
47 BUTTS EAST
45 BUTTS EAST
43 BUTTS EAST
41 BUTTS EAST
A FACE EAST
FRYE
HENRY McDONOUGH
28
JACOB W DAGUE
ROMAIN M JONES
10500 N
10000 N

mine 84
No 52 No 5 ELLS.
Hetherington Shaft
HB#5
1917-1983
Washington
X81-800