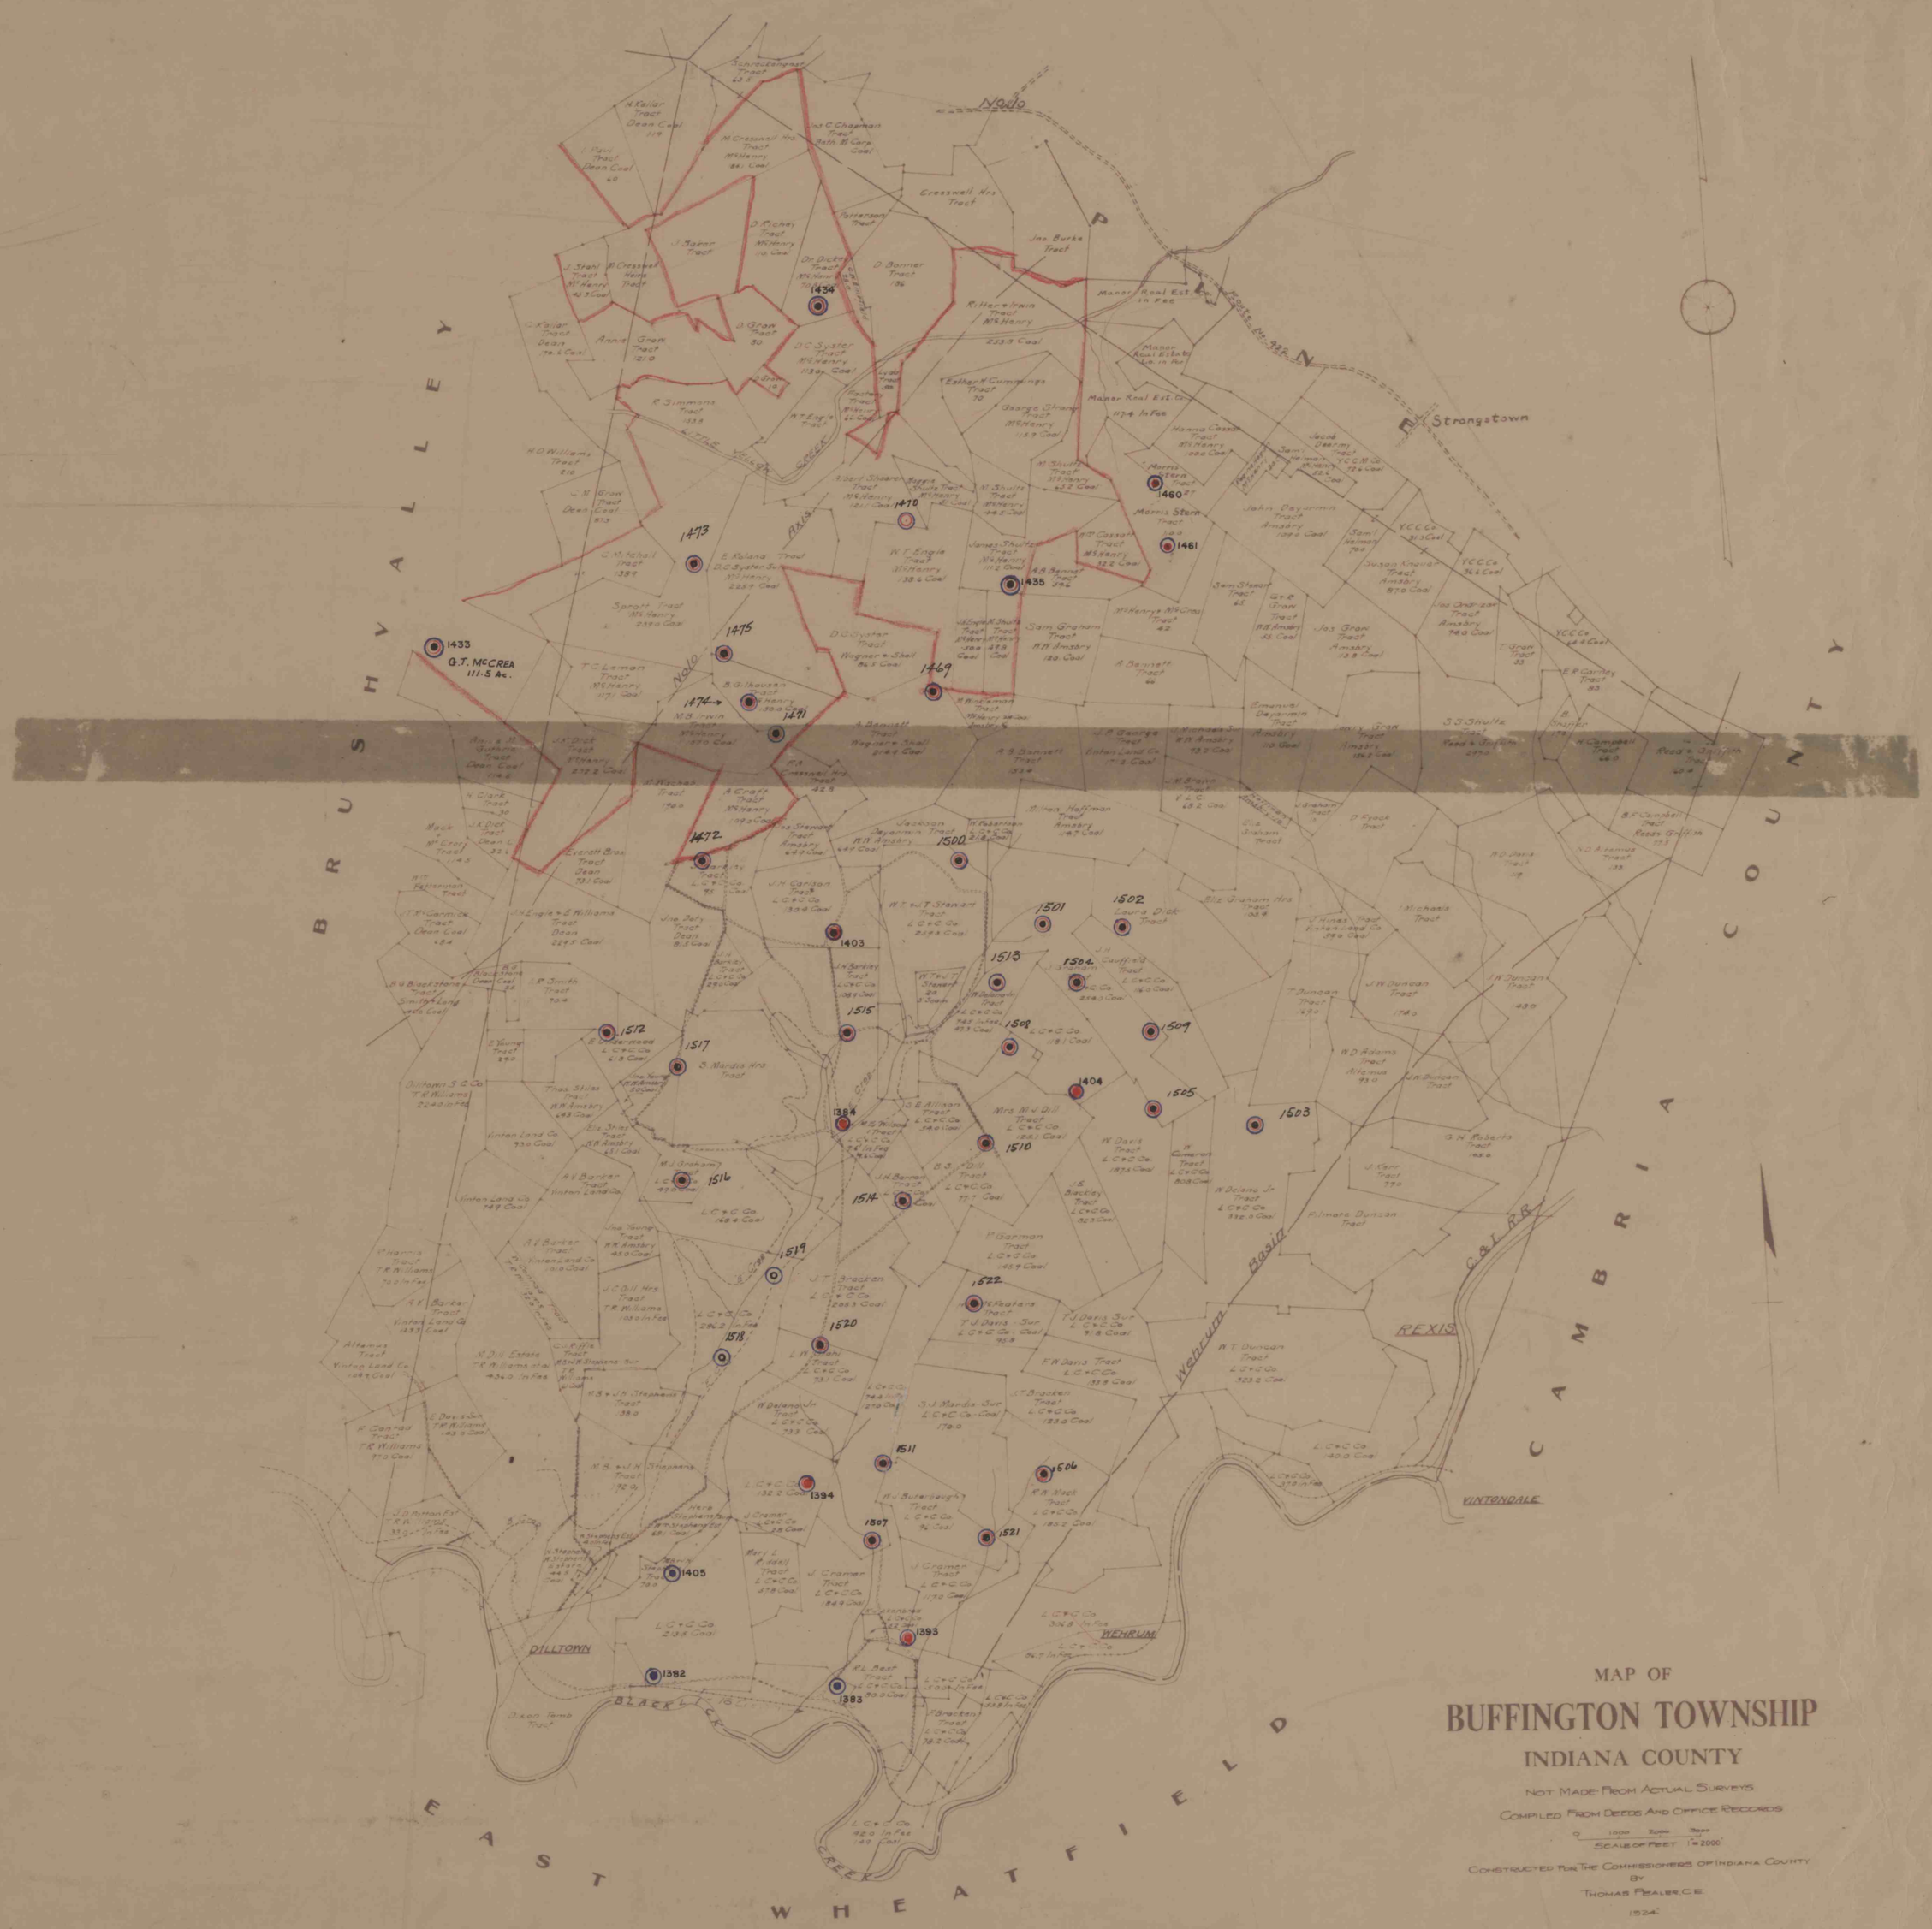

IMAPS #18822 10