



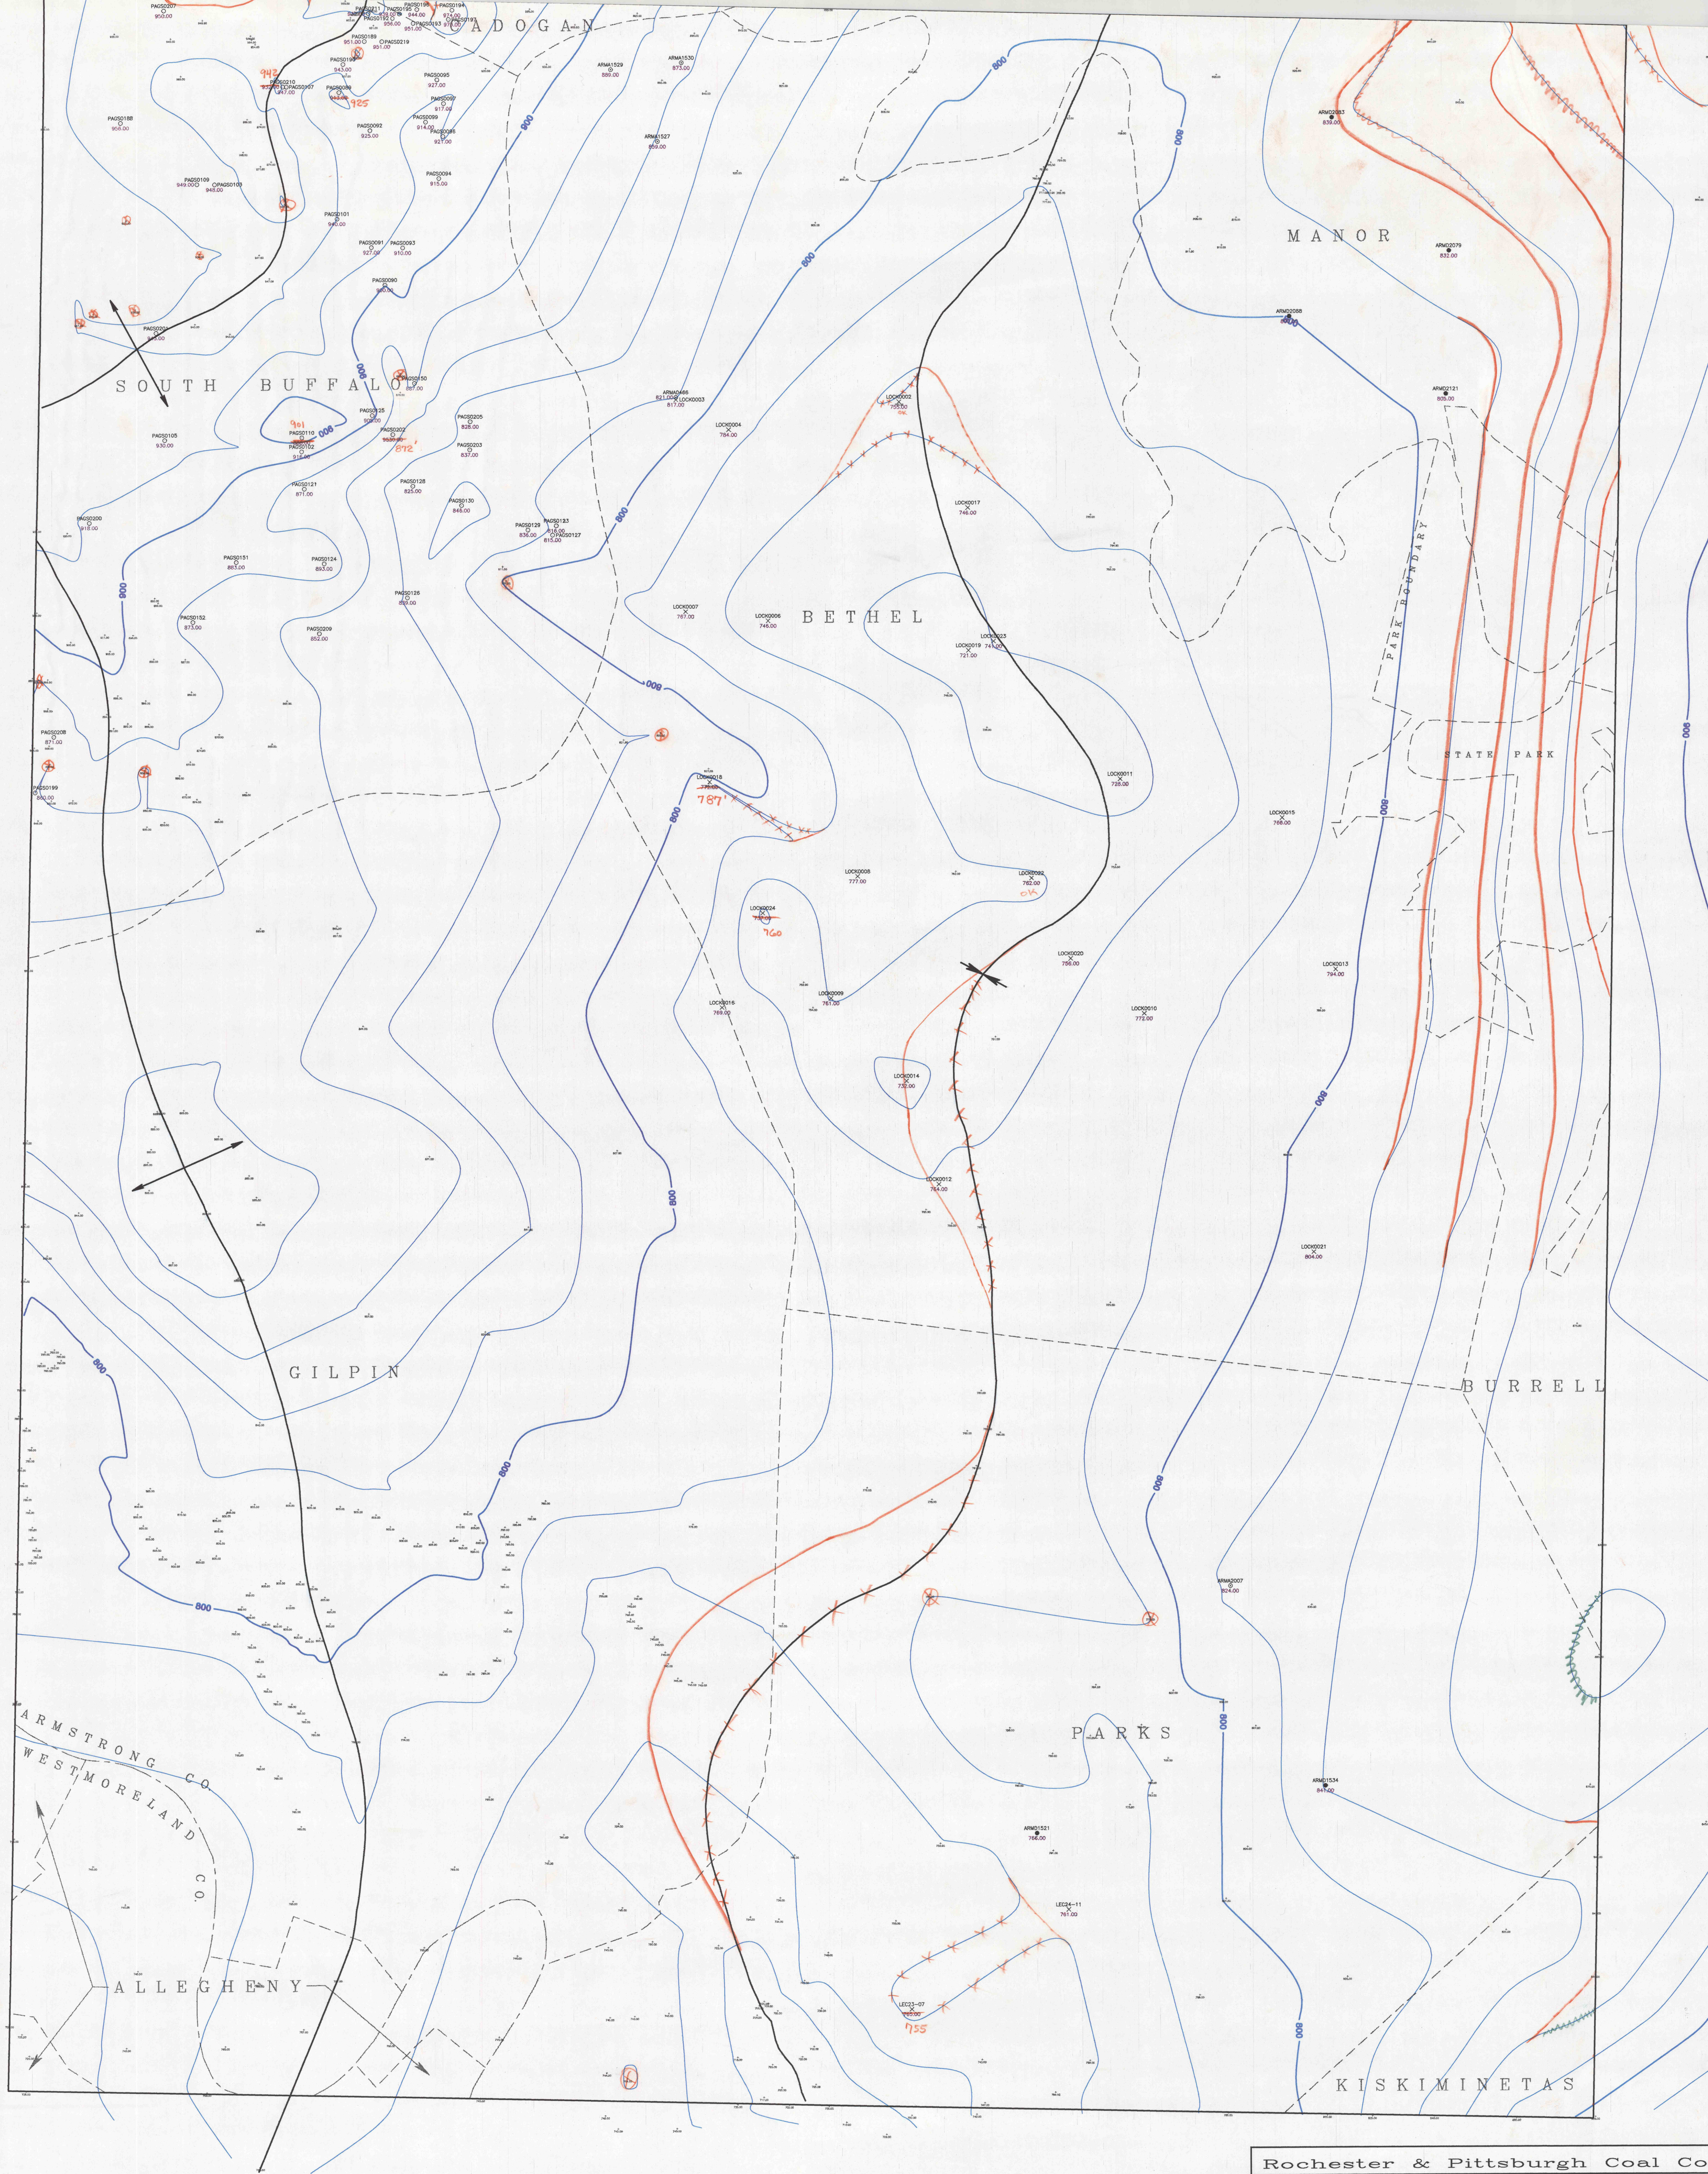

GRAPHIC SCALE 1"=1200'
0 1200 2400 3600

DATE : WED DEC 11 10:07:07 1991
PROJECT : K\ARM\LBRC.NEW

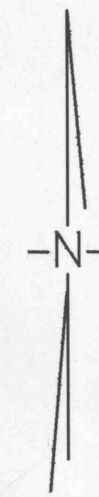

Rochester & Pittsburgh Coal Co.
Armstrong County
Reserve Evaluation
Project

UPPER KITTANNING STRUCTURE MAP
for the
LEECHBURG QUADRANGLE
Scale 1 inch = 1200 feet

December 1991

IMAPS#18835