
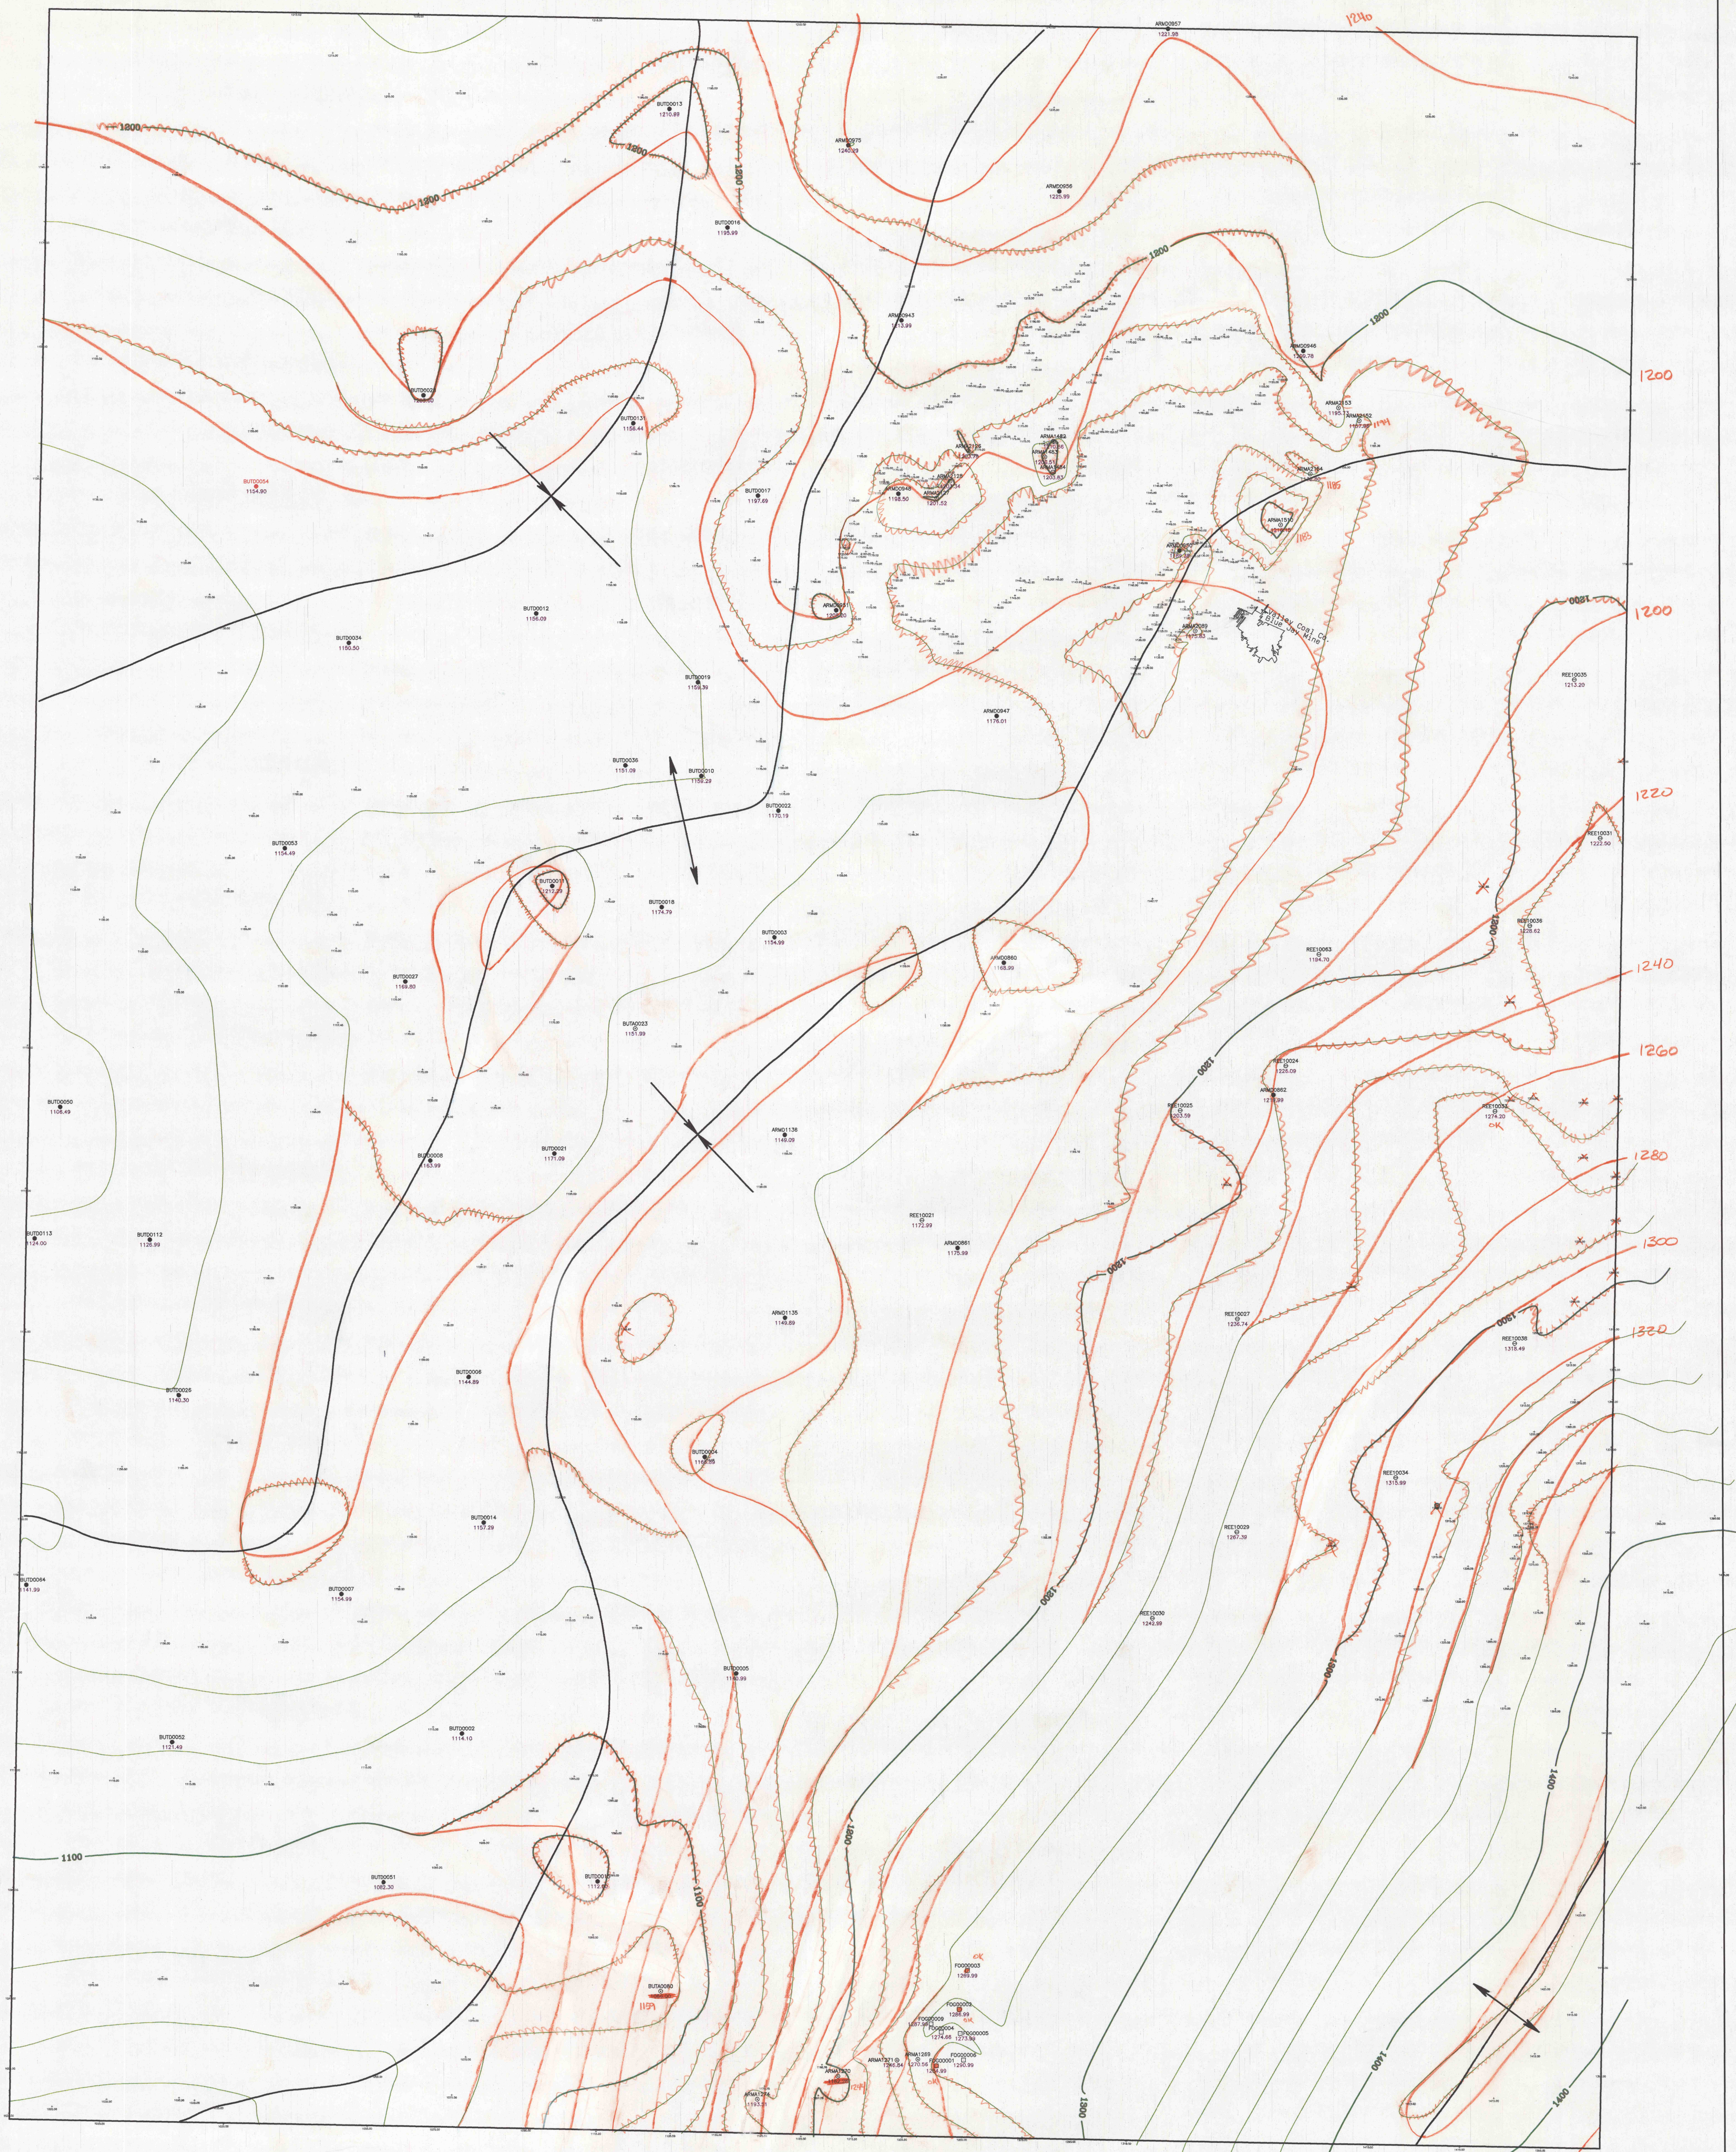


DATE : MON DEC 9 13:34:03 1991
PROJECT : K\ARM\CHICORA.NEW

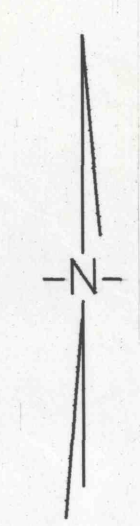

Rochester & Pittsburgh Coal Co.
Armstrong County
Reserve Evaluation
Project
UPPER KITTANNING STRUCTURE MAP
for the
CHICORA QUADRANGLE
Scale 1 inch = 1200 feet
December 1991

IMAPS#18836