
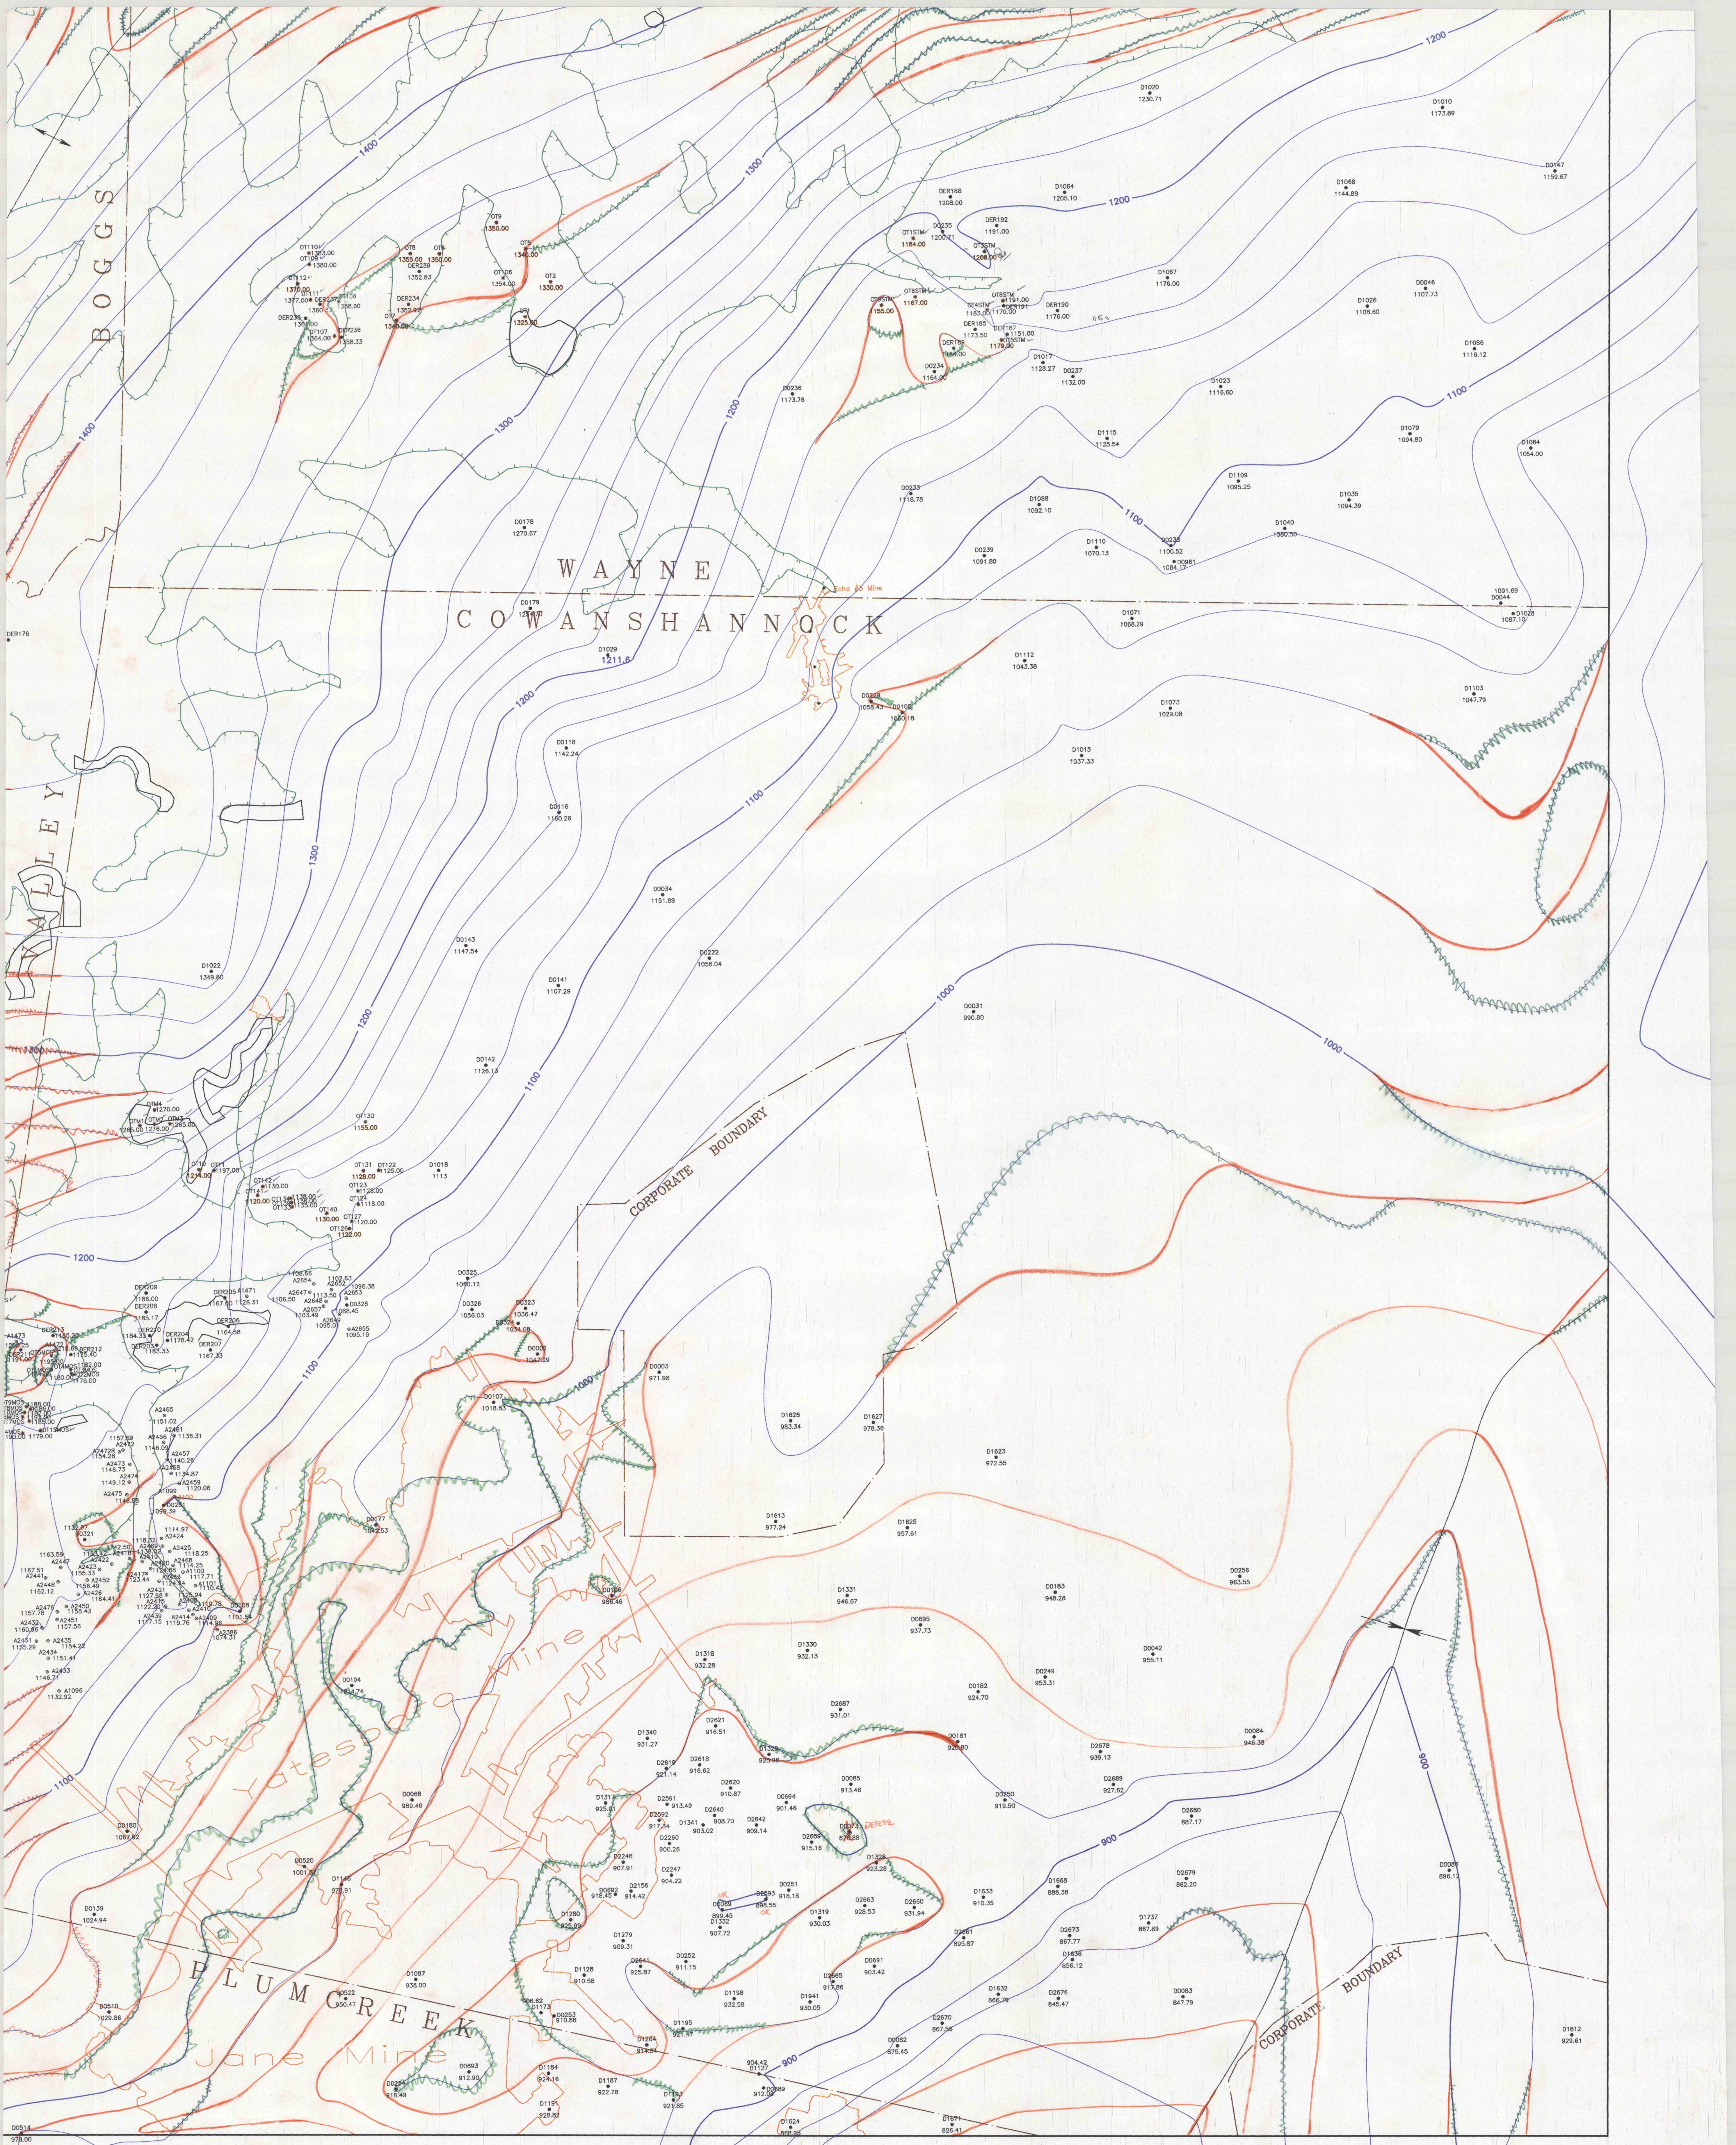


DATE : THU NOV 7 08:21:25 1991
PROJECT : F:\ARM.RV.STRC
TITLE : REVISED WITH NEW CROP

STRUCTURAL CONTIGUES
SHOULD NOT
CONTRADICT SEAM
BASE ELEV. FROM
MINE WORKS

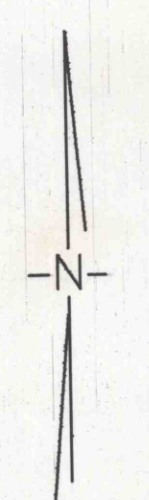

MK = UK = 70'
LF = UK = 40'

Rochester & Pittsburgh Coal Co.
Armstrong County
Reserve Evaluation
Project

UPPER KITTANNING STRUCTURE MAP
for the
RURAL VALLEY QUADRANGLE
Scale 1 inch = 1200 feet November 1991

IMAPS # 18638