


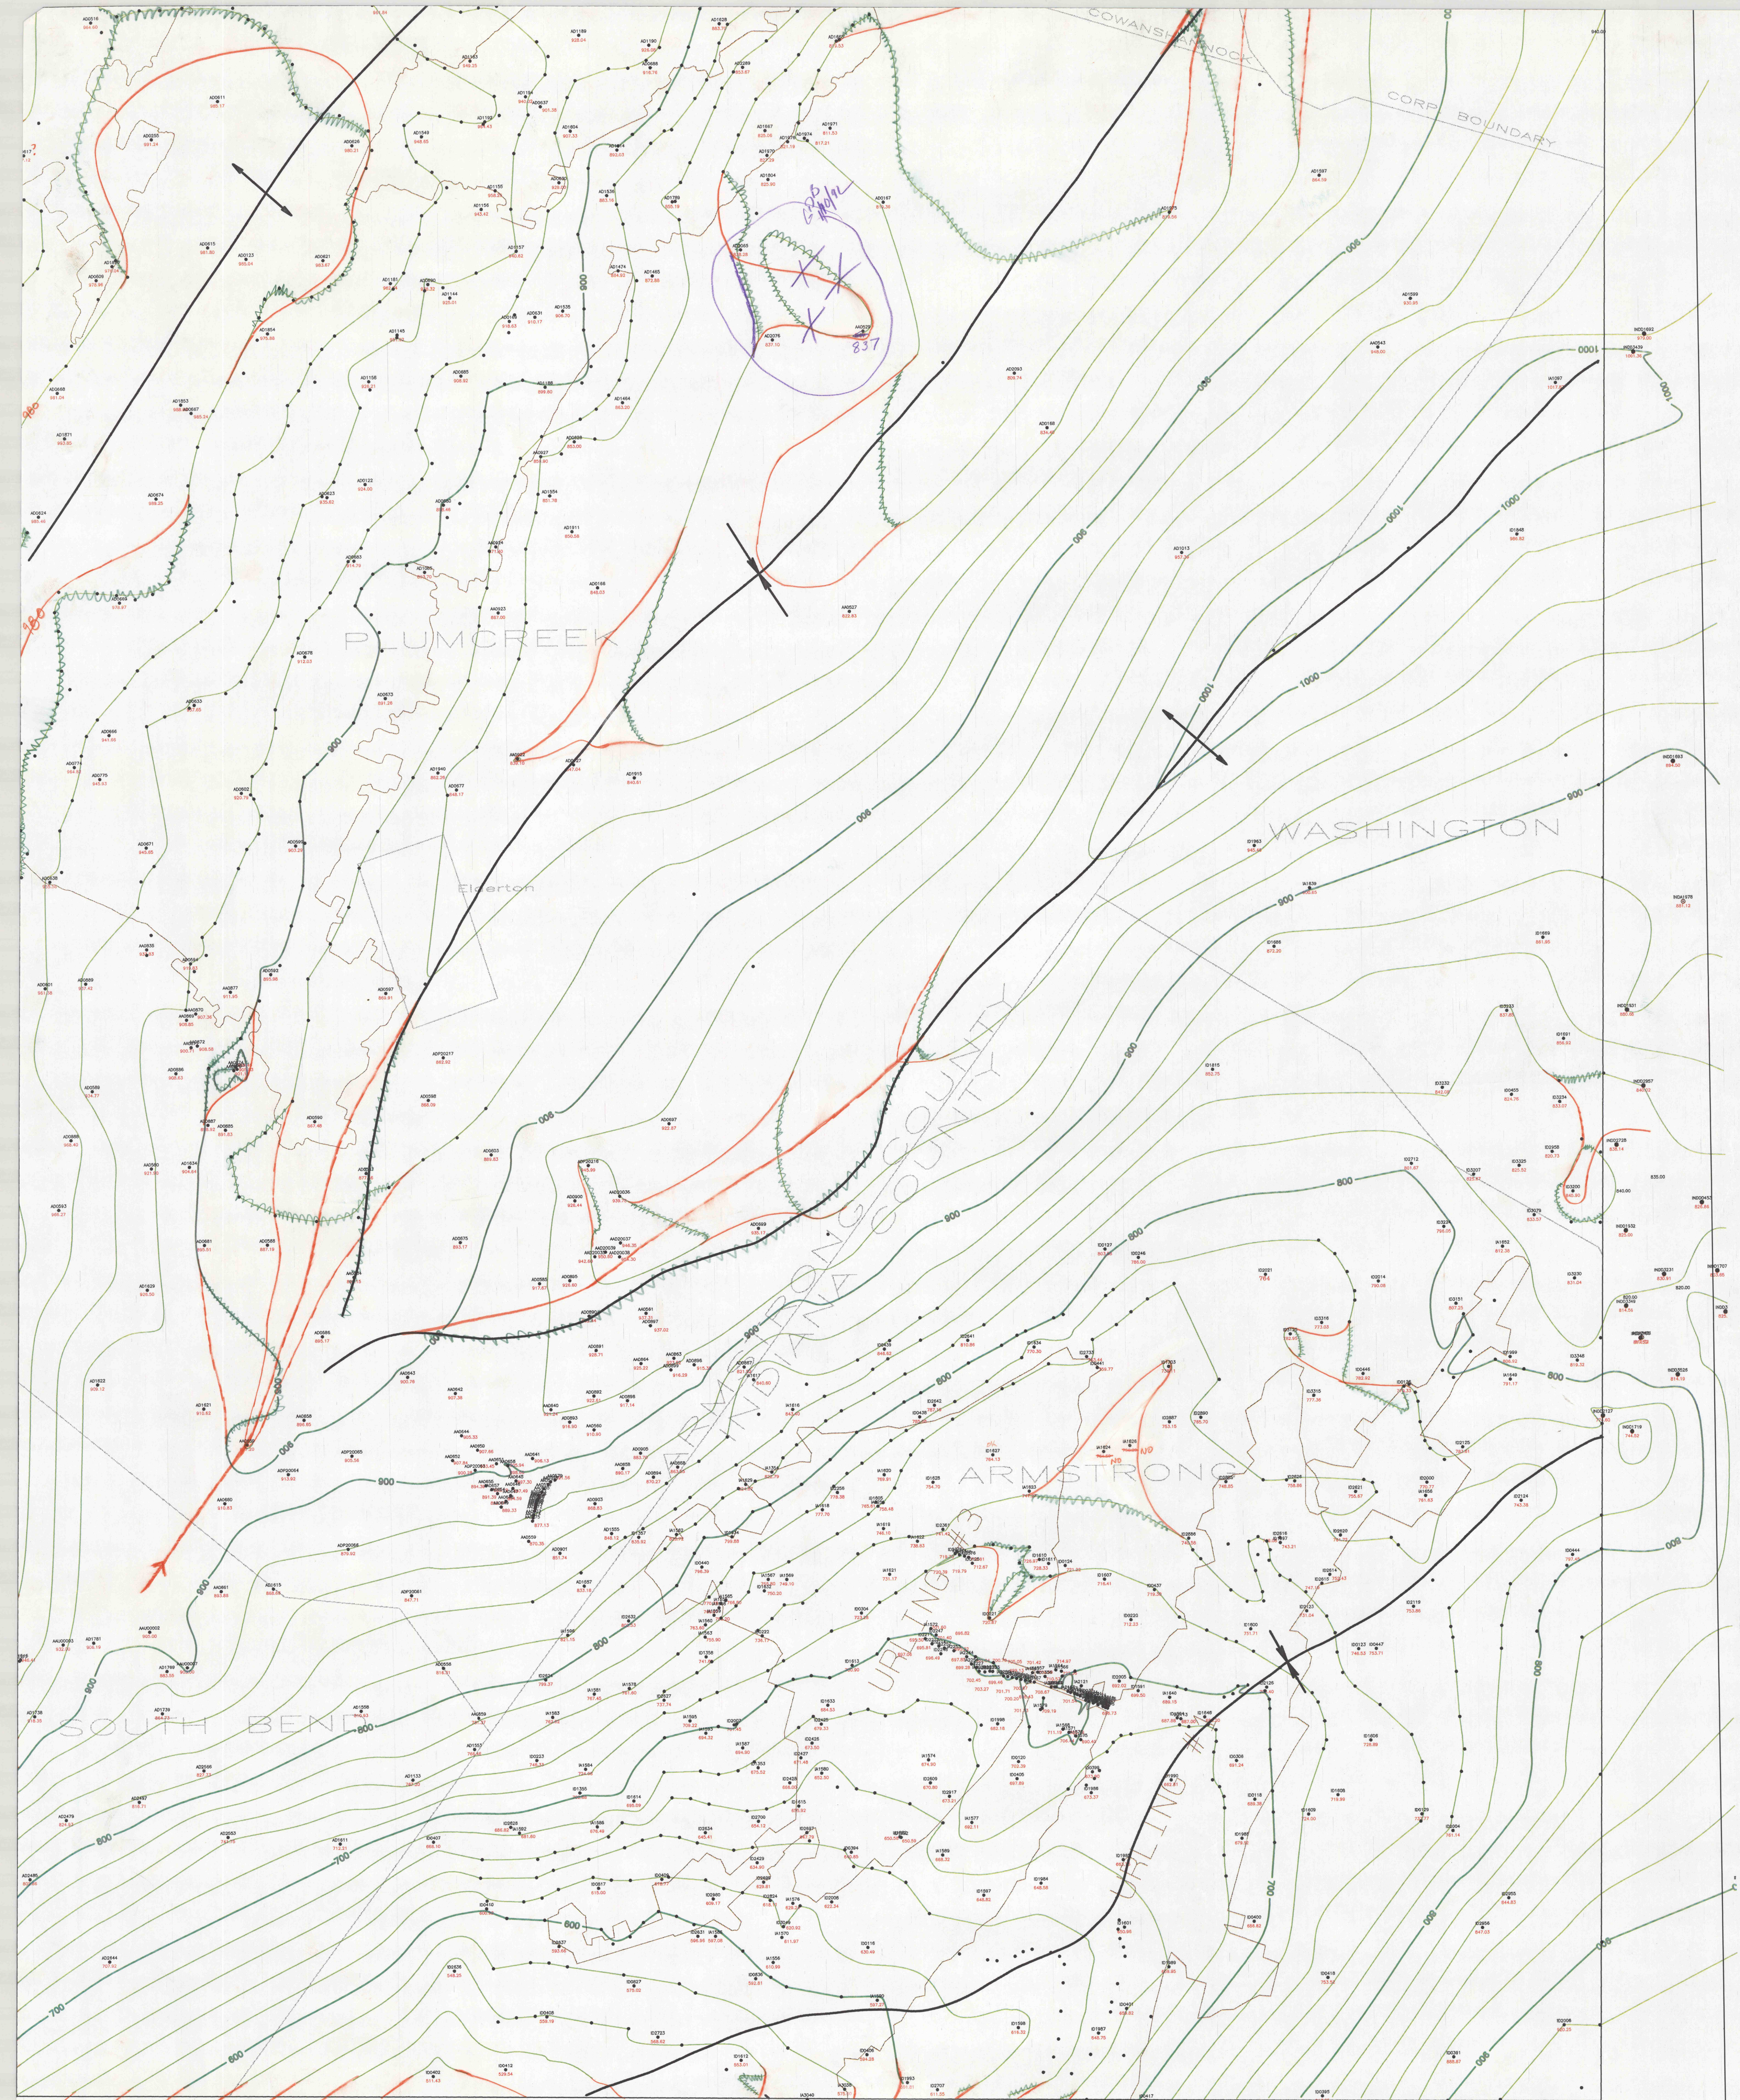

Rochester & Pittsburgh Coal Co.

Armstrong County
Reserve Evaluation
Project

UPPER KITTANNING STRUCTURE MAP
for the
ELDERTON QUADRANGLE

Scale 1 inch = 1200 feet

August 1991

GRAPHIC SCALE 1"=1200'
0 1200 2400 3600

DATE : SAT DEC 14 02:17:14 1991
PROJECT : F:\PETE\ELDERTON\EL022ST
TITLE : ELDERTON UPPER KITTANNING STRUCTURE

T MAPS # 18841