


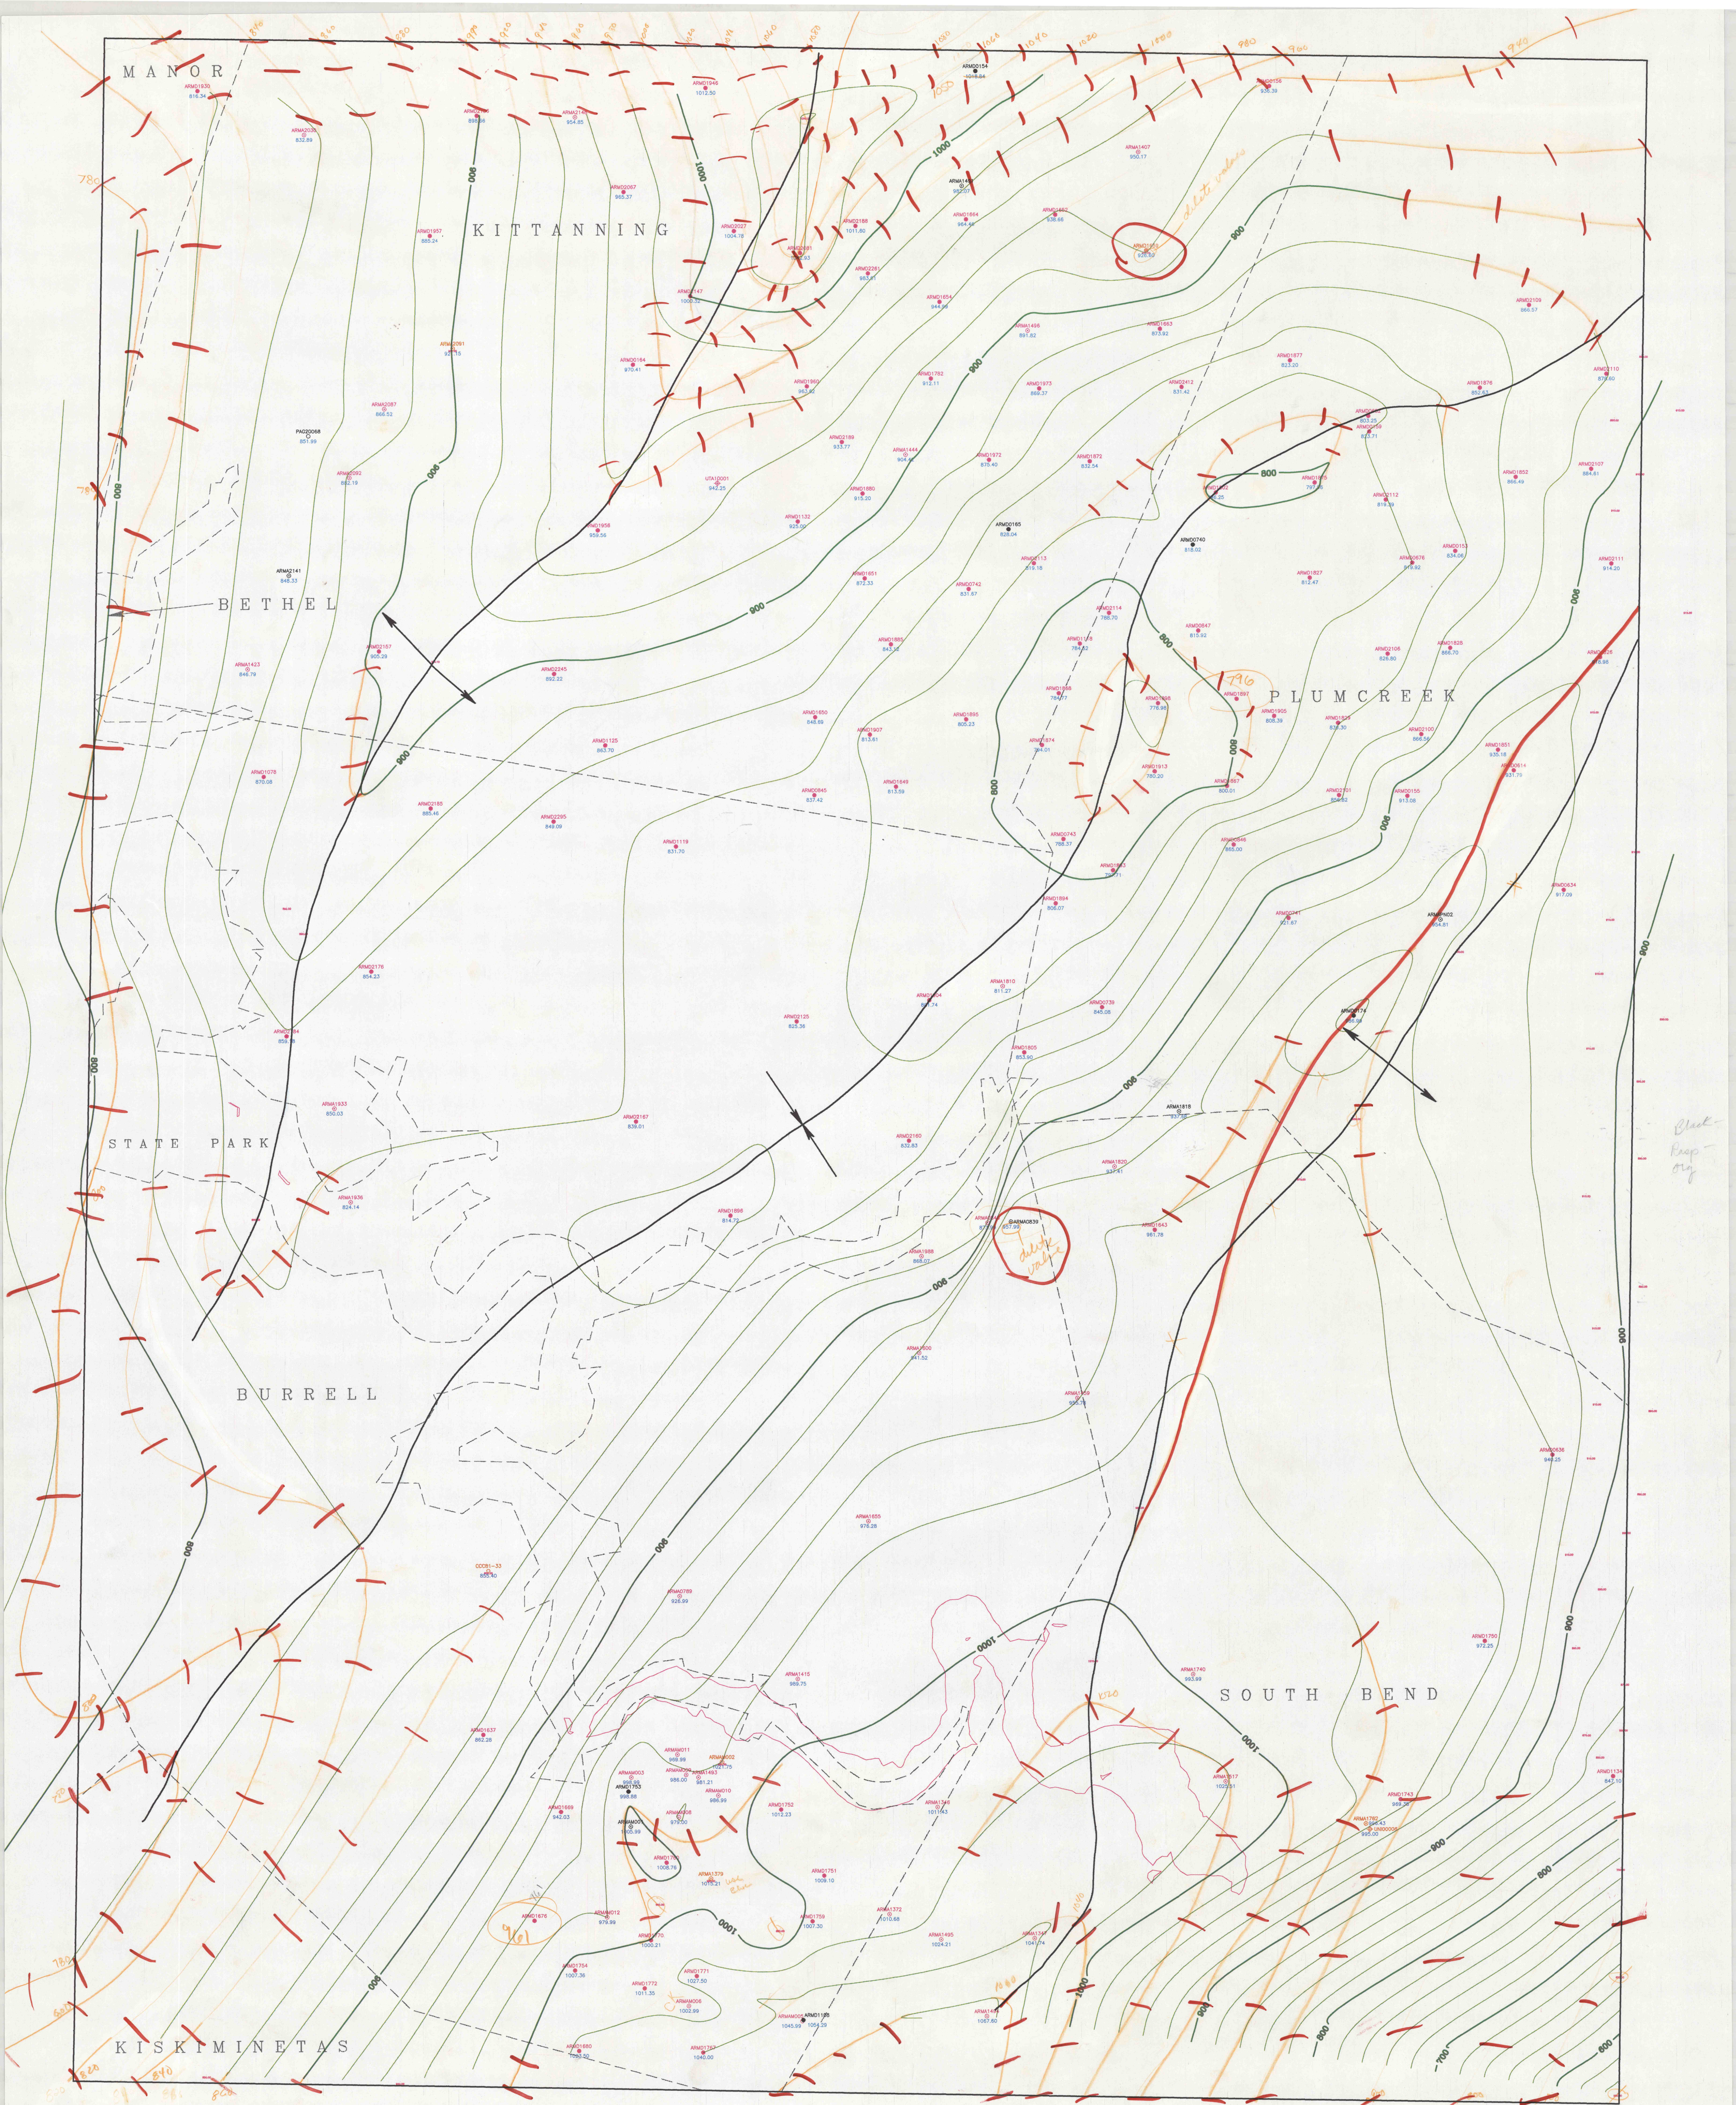

Revised
By Pete
12-31-91

023 DRILLHOLE
023L DRILLHOLE
023U DRILLHOLE

Rochester & Pittsburgh Coal Co
Armstrong County
Reserve Evaluation
Project

MIDDLE KITTANNING STRUCTURE MAP

for the
WHITESBURG QUADRANGLE
Scale 1 inch = 1200 feet
December 1991

GRAPHIC SCALE 1"=1200'
0 1200 2400 3600

DATE: FRI DEC 13 15:41:34 1991
PROJECT: K\ARM\WHBRG.NEW

I MAPS#18842