


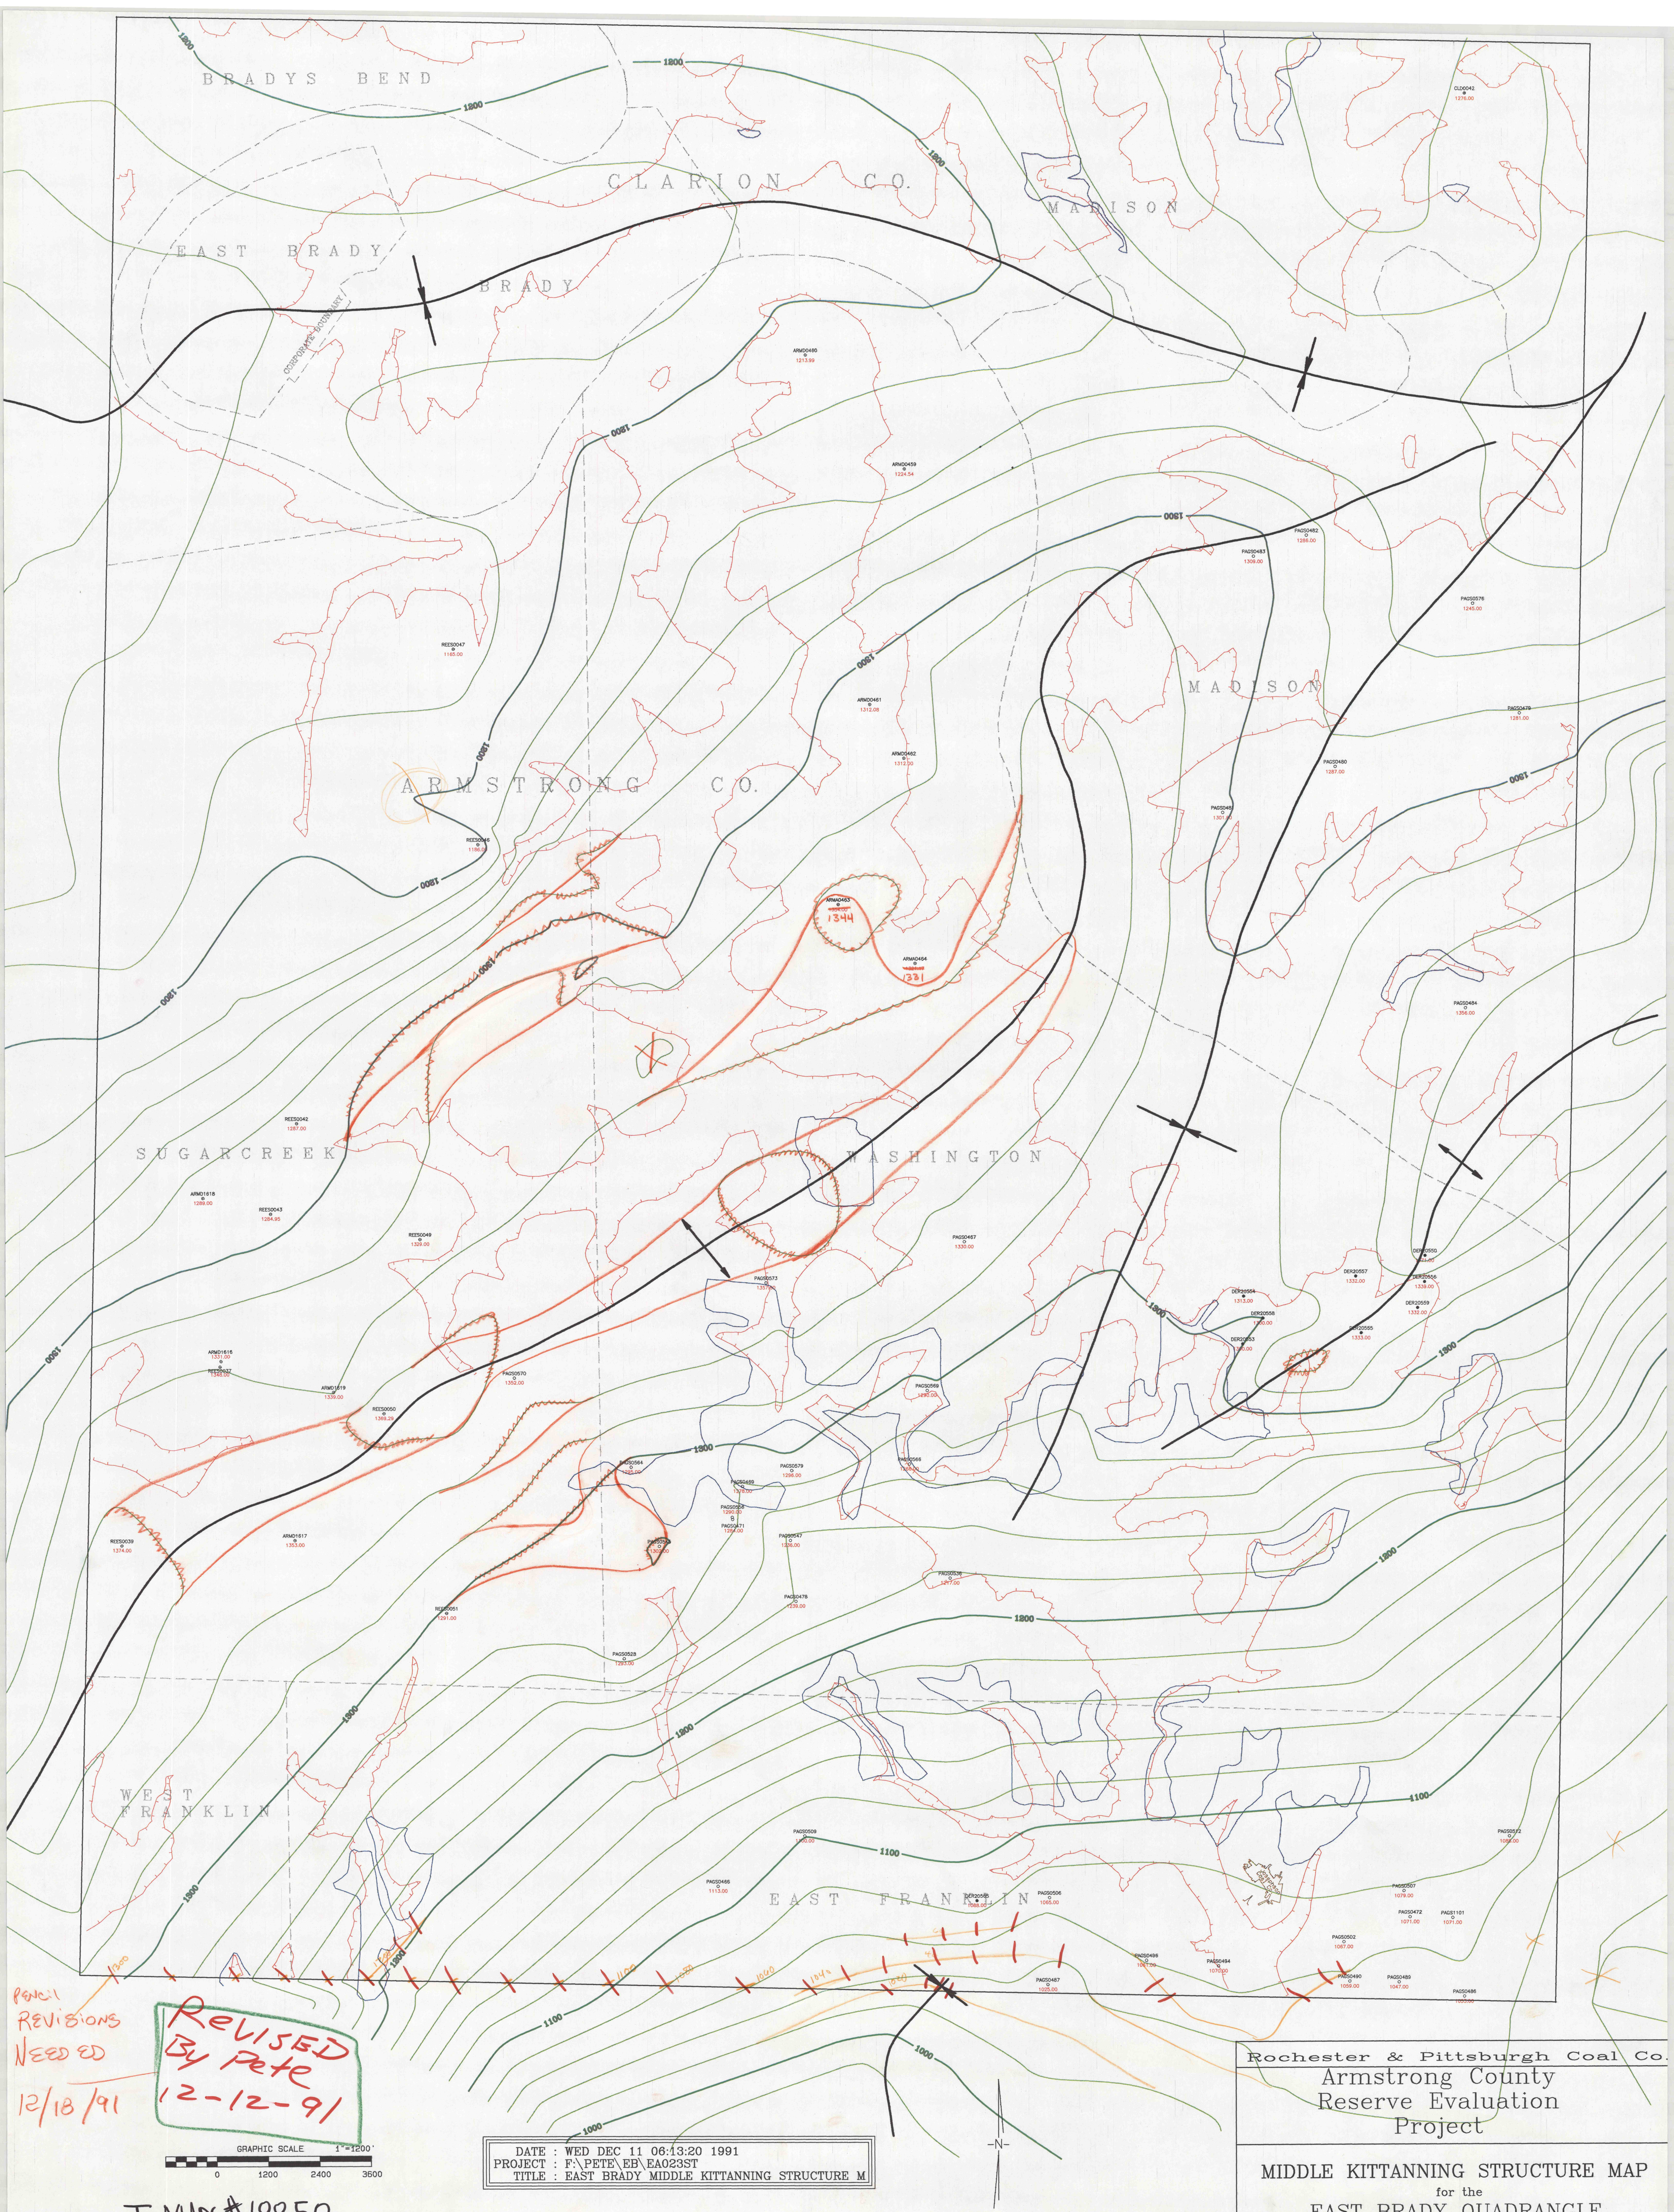

Pencil
REVISIONS
NEEDED
12/18/91

**REVISED
By Pete
12-12-91**

GRAPHIC SCALE 1"=1200'

0 1200 2400 3600

DATE : WED DEC 11 06:13:20 1991
PROJECT : F:\PETE\EB\EA023ST
TITLE : EAST BRADY MIDDLE KITTANNING STRUCTURE M

Rochester & Pittsburgh Coal Co.
Armstrong County
Reserve Evaluation
Project

MIDDLE KITTANNING STRUCTURE MAP
for the
EAST BRADY QUADRANGLE
Scale 1 inch = 1200 feet
December 1991

I MAPS*18850