


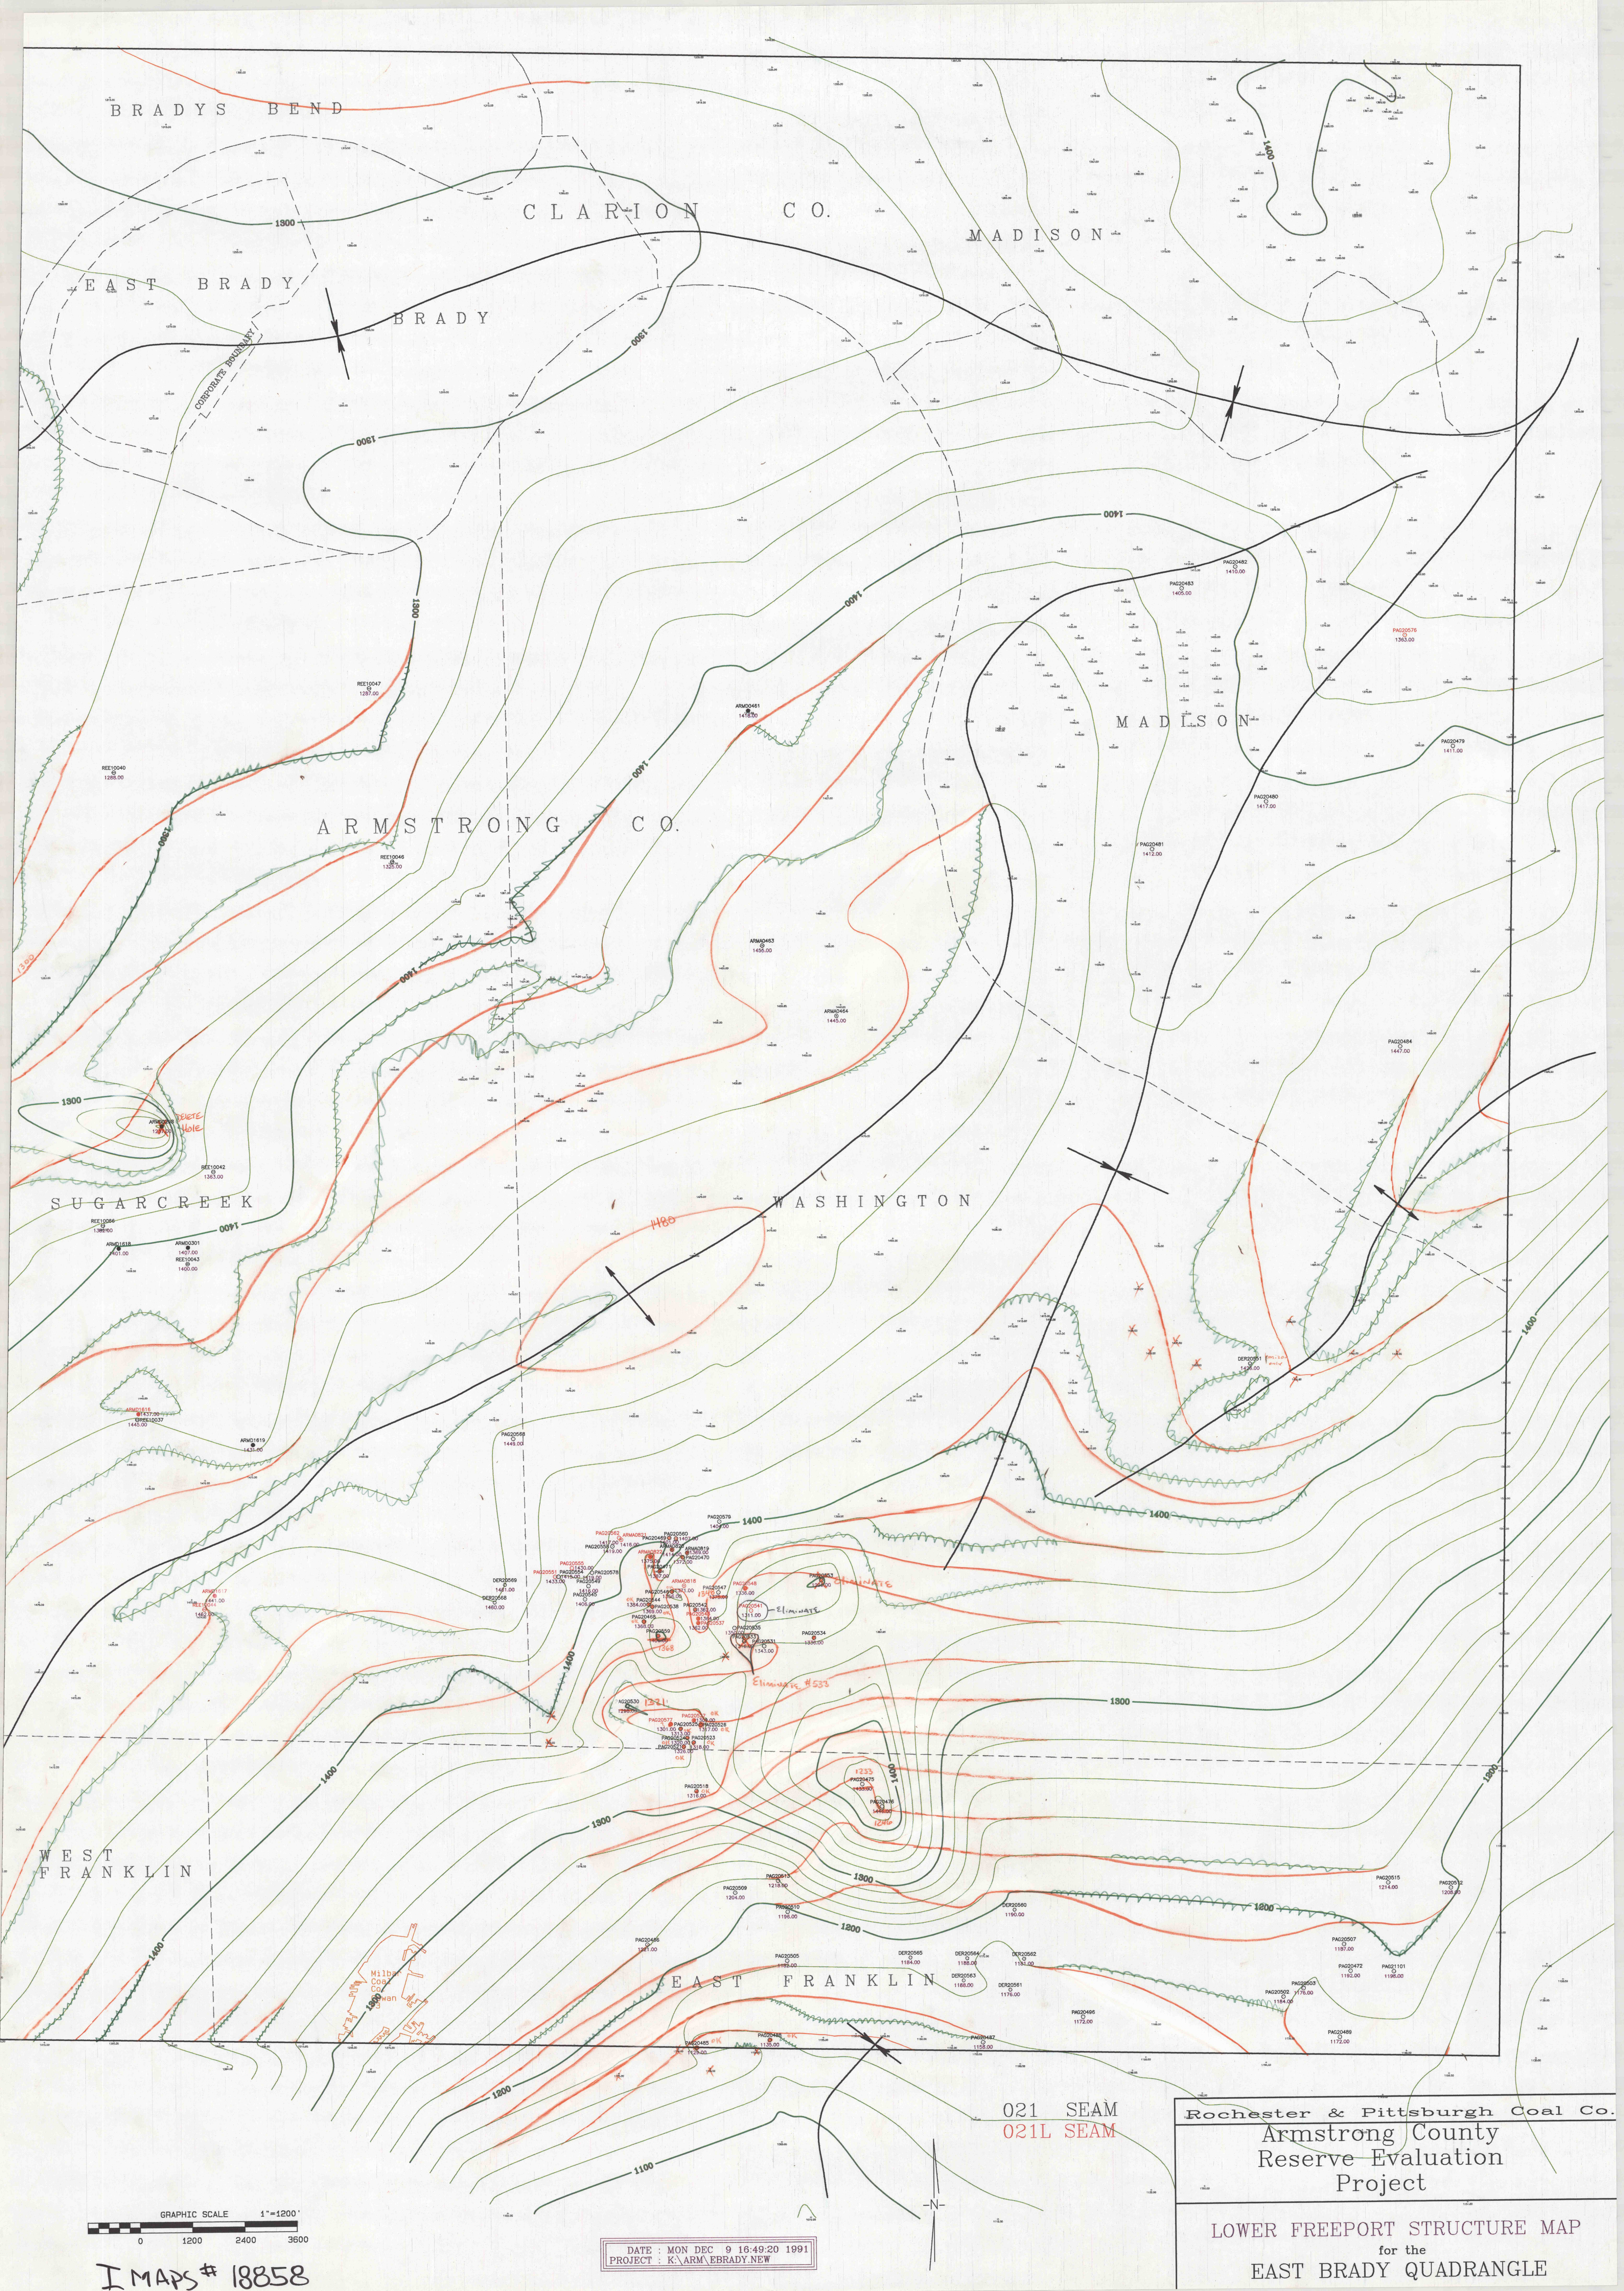

BRADYS BEND

CLARION CO.

MADISON

EAST BRADY

BRADY

CORPORATE BOUNDARY

ARMSTRONG CO.

MADISON

SUGARCREEK

WASHINGTON

WEST FRANKLIN

EAST FRANKLIN

021 SEAM
021L SEAM

Rochester & Pittsburgh Coal Co.
Armstrong County
Reserve Evaluation
Project

LOWER FREEPORT STRUCTURE MAP
for the
EAST BRADY QUADRANGLE

GRAPHIC SCALE 1"=1200'
0 1200 2400 3600

DATE: MON DEC 9 16:49:20 1991
PROJECT: K:\ARM\EBRADY.NEW

I MAPS # 18858