
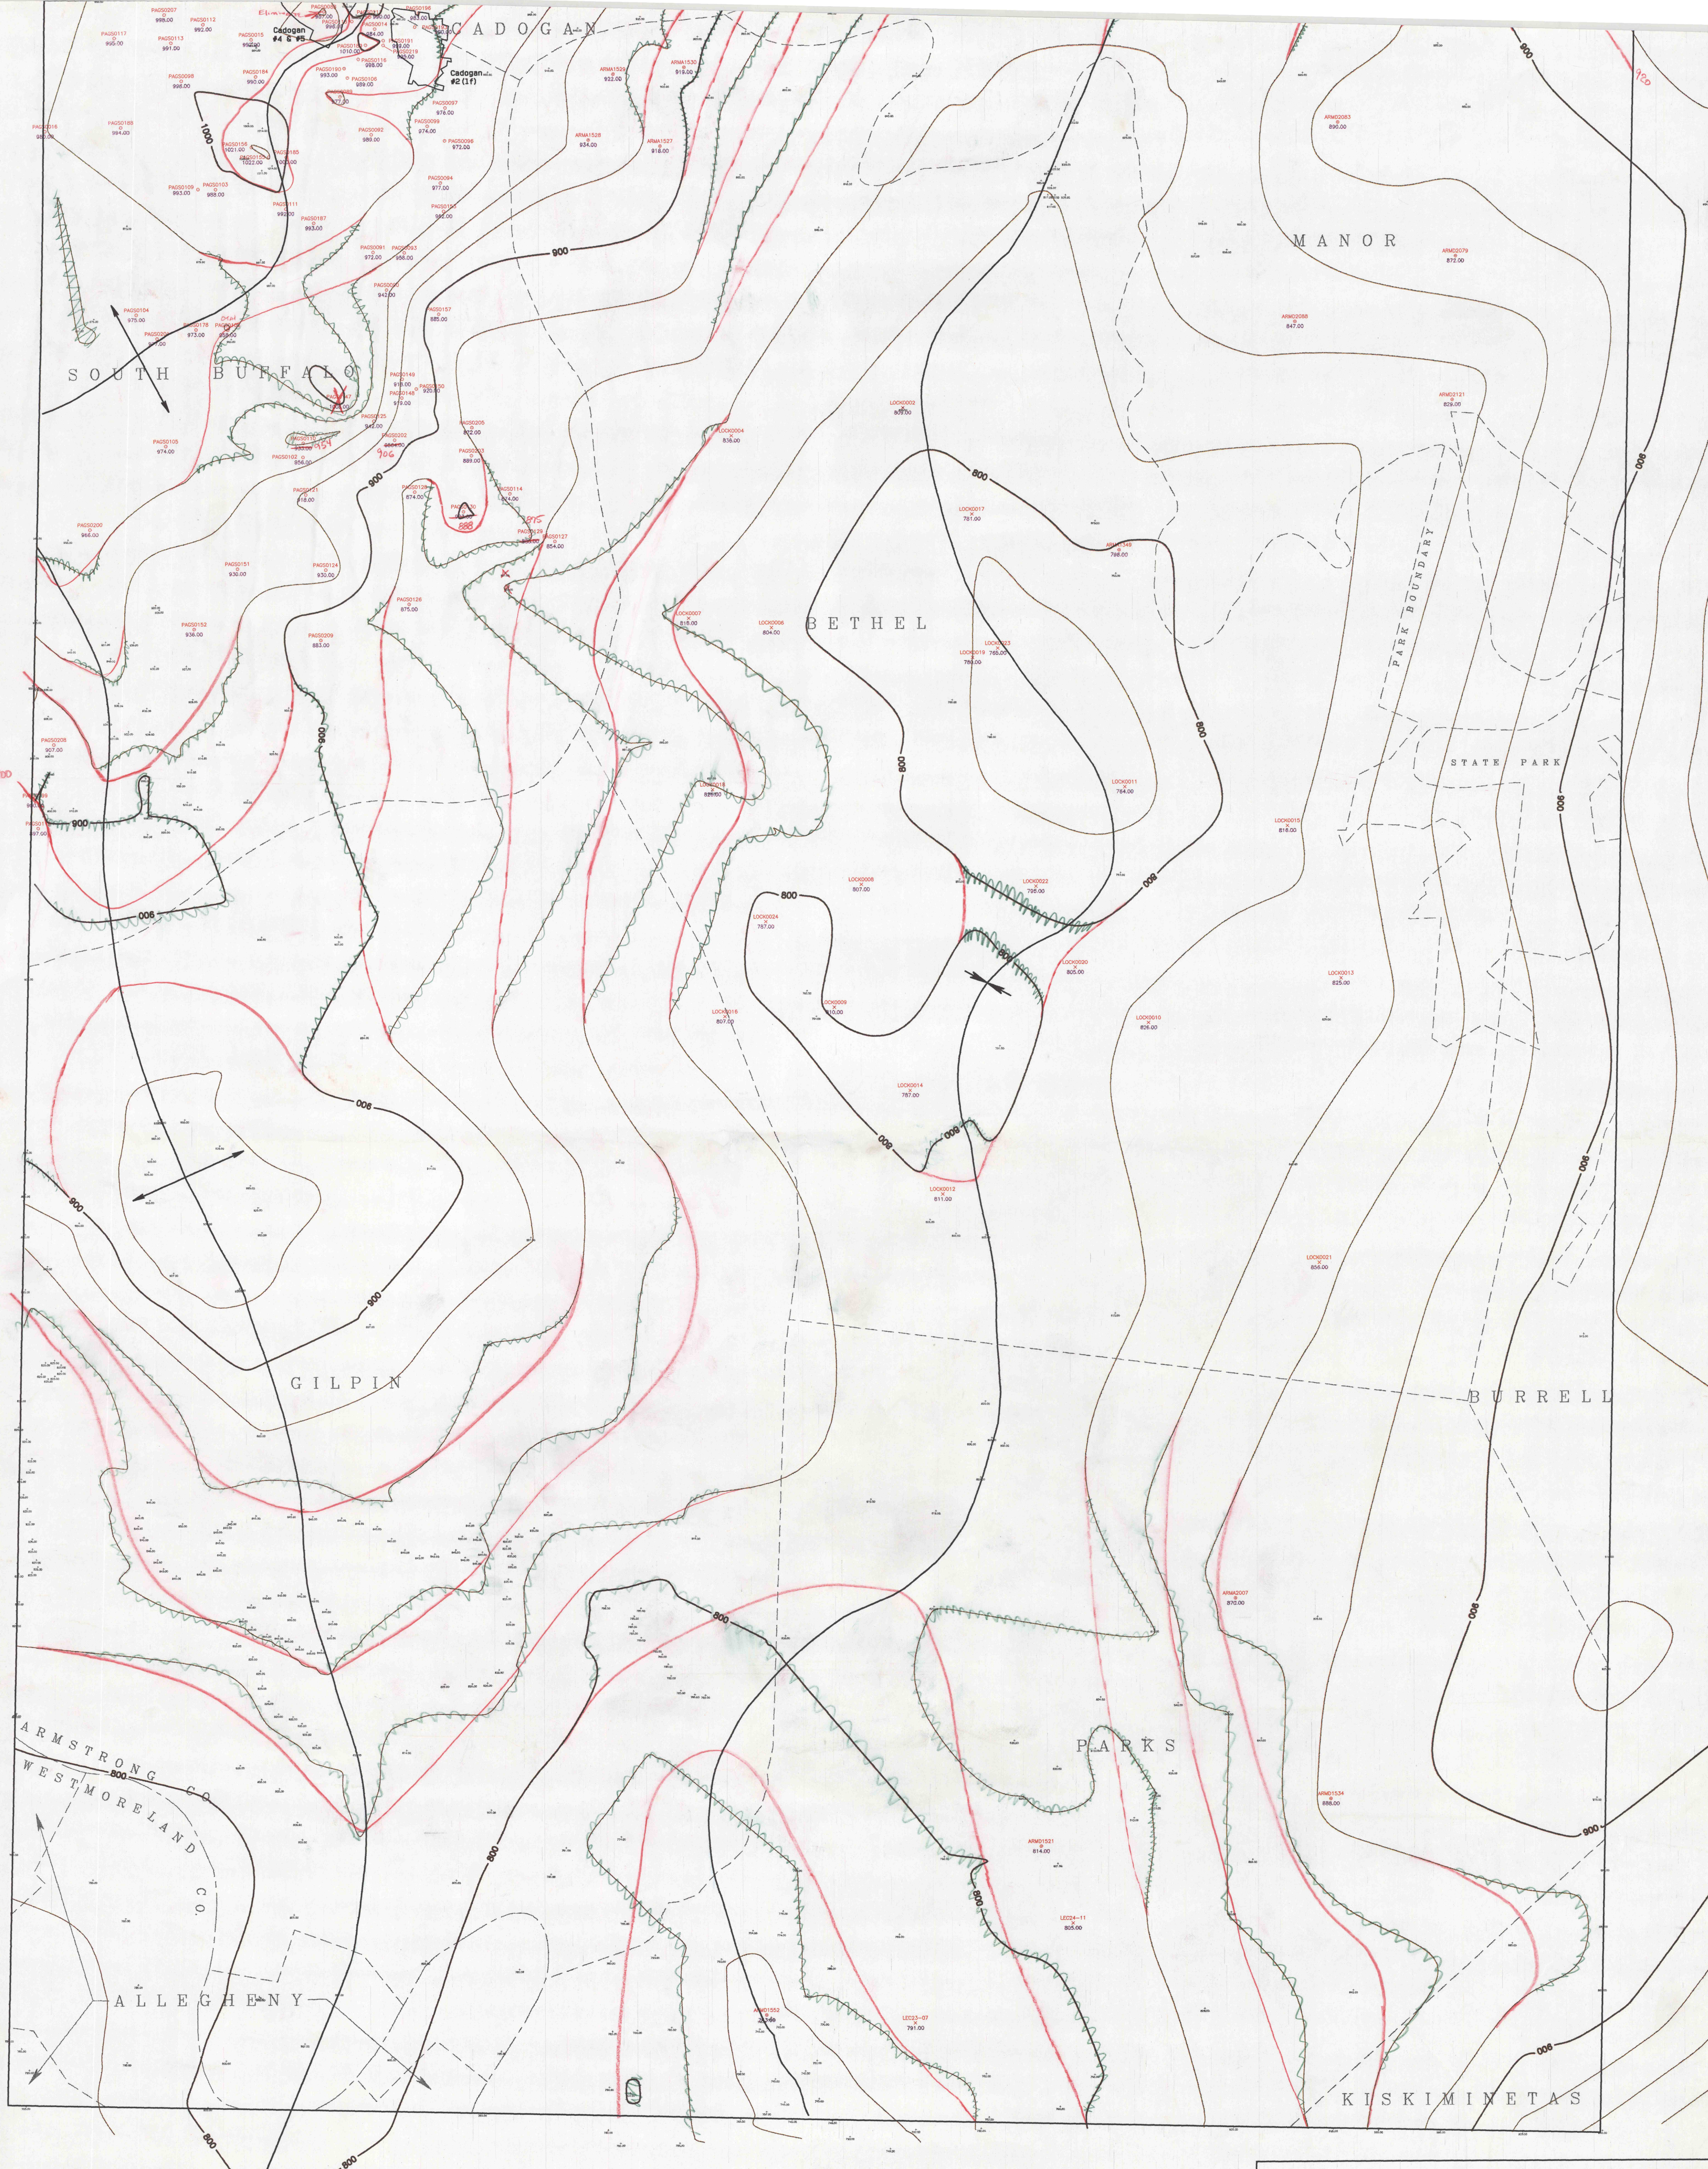


DATE: WED DEC 11 10:24:47 1991
PROJECT: K\ARM\LBG.NEW

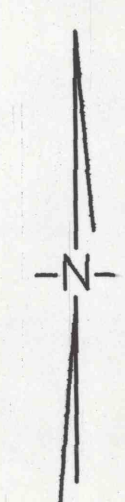

Rochester & Pittsburgh Coal Co.
Armstrong County
Reserve Evaluation
Project
LOWER FREEPORT STRUCTURE MAP
for the
LEECHBURG QUADRANGLE
Scale 1 inch = 1200 feet
December 1991

T MAPS*18859