


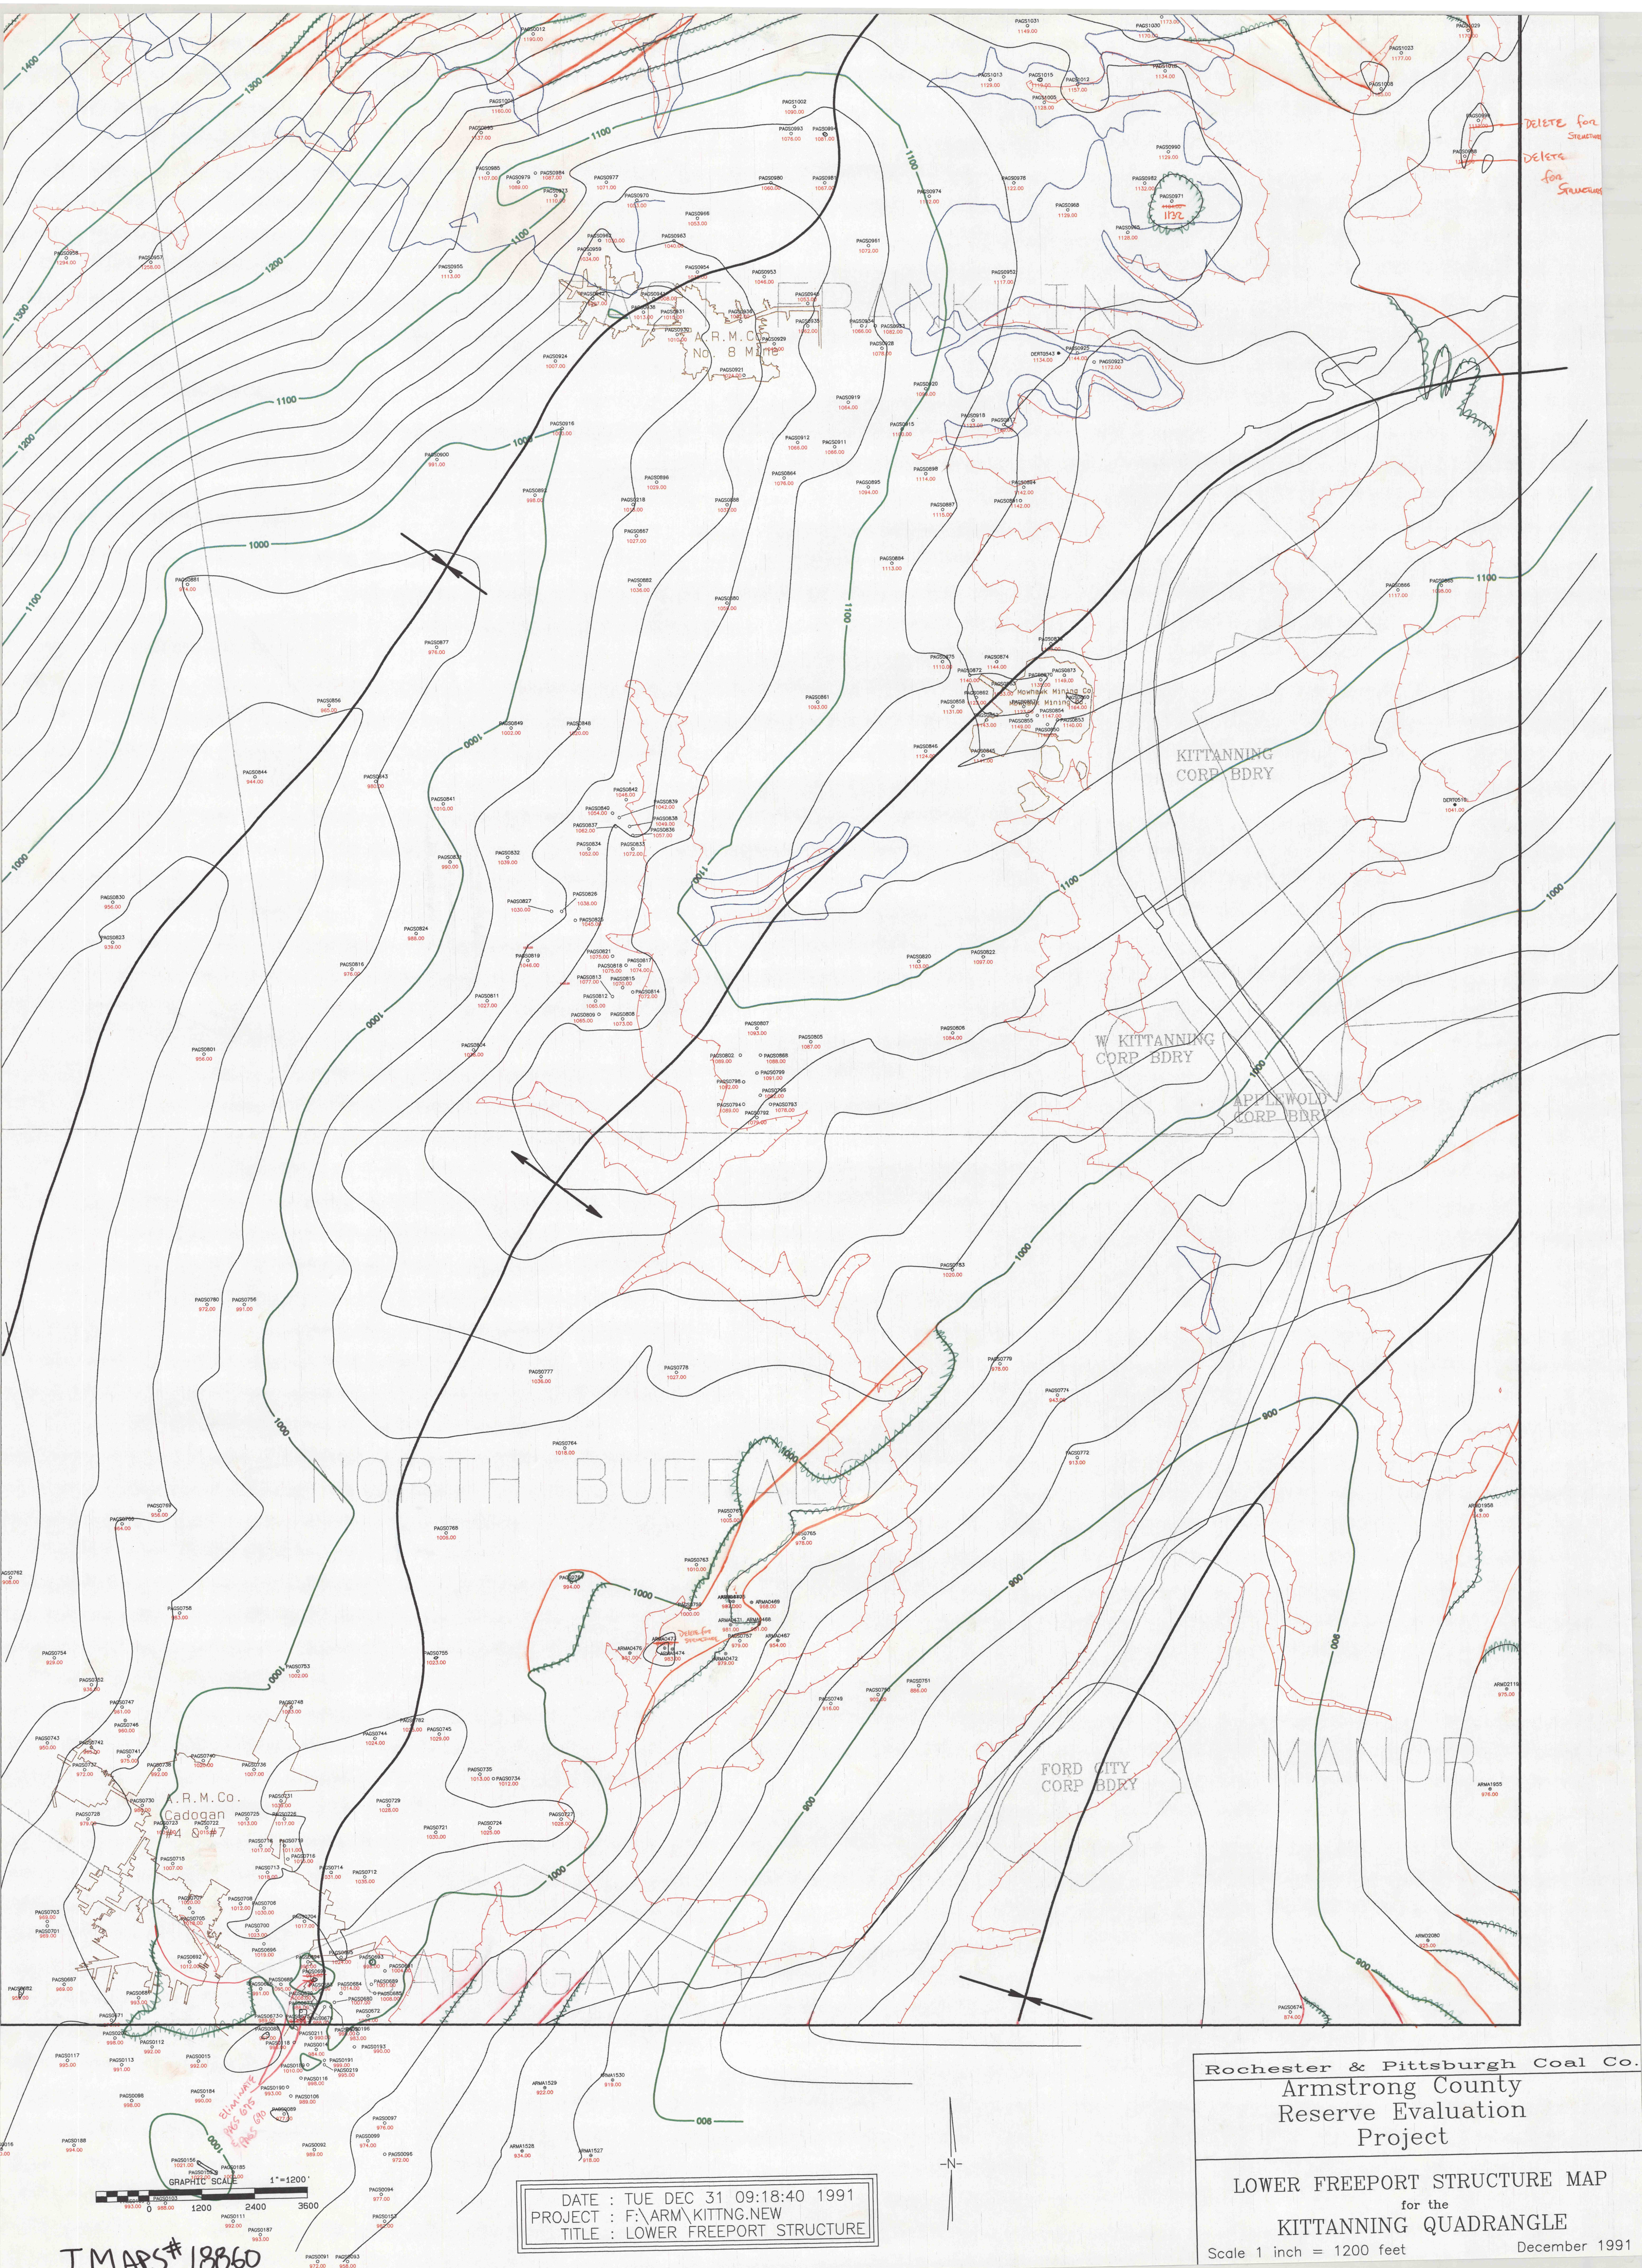

DELETE for
STRUCTURE
DELETE
for
STRUCTURE

KITTANNING
CORP BDRY

W KITTANNING
CORP BDRY

APPLEWOLD
CORP BDRY

FORD CITY
CORP BDRY

MANOR

NORTH BUFFALO

CADOGAN

A.R.M. Co.
Cadogan
#4 Q13#7

DATE : TUE DEC 31 09:18:40 1991
PROJECT : F:\ARM\KITTING.NEW
TITLE : LOWER FREEPORT STRUCTURE

Rochester & Pittsburgh Coal Co.
Armstrong County
Reserve Evaluation
Project

LOWER FREEPORT STRUCTURE MAP
for the
KITTANNING QUADRANGLE
Scale 1 inch = 1200 feet
December 1991

GRAPHIC SCALE
1"=1200'
1200 2400 3600

T MAPS# 18860