


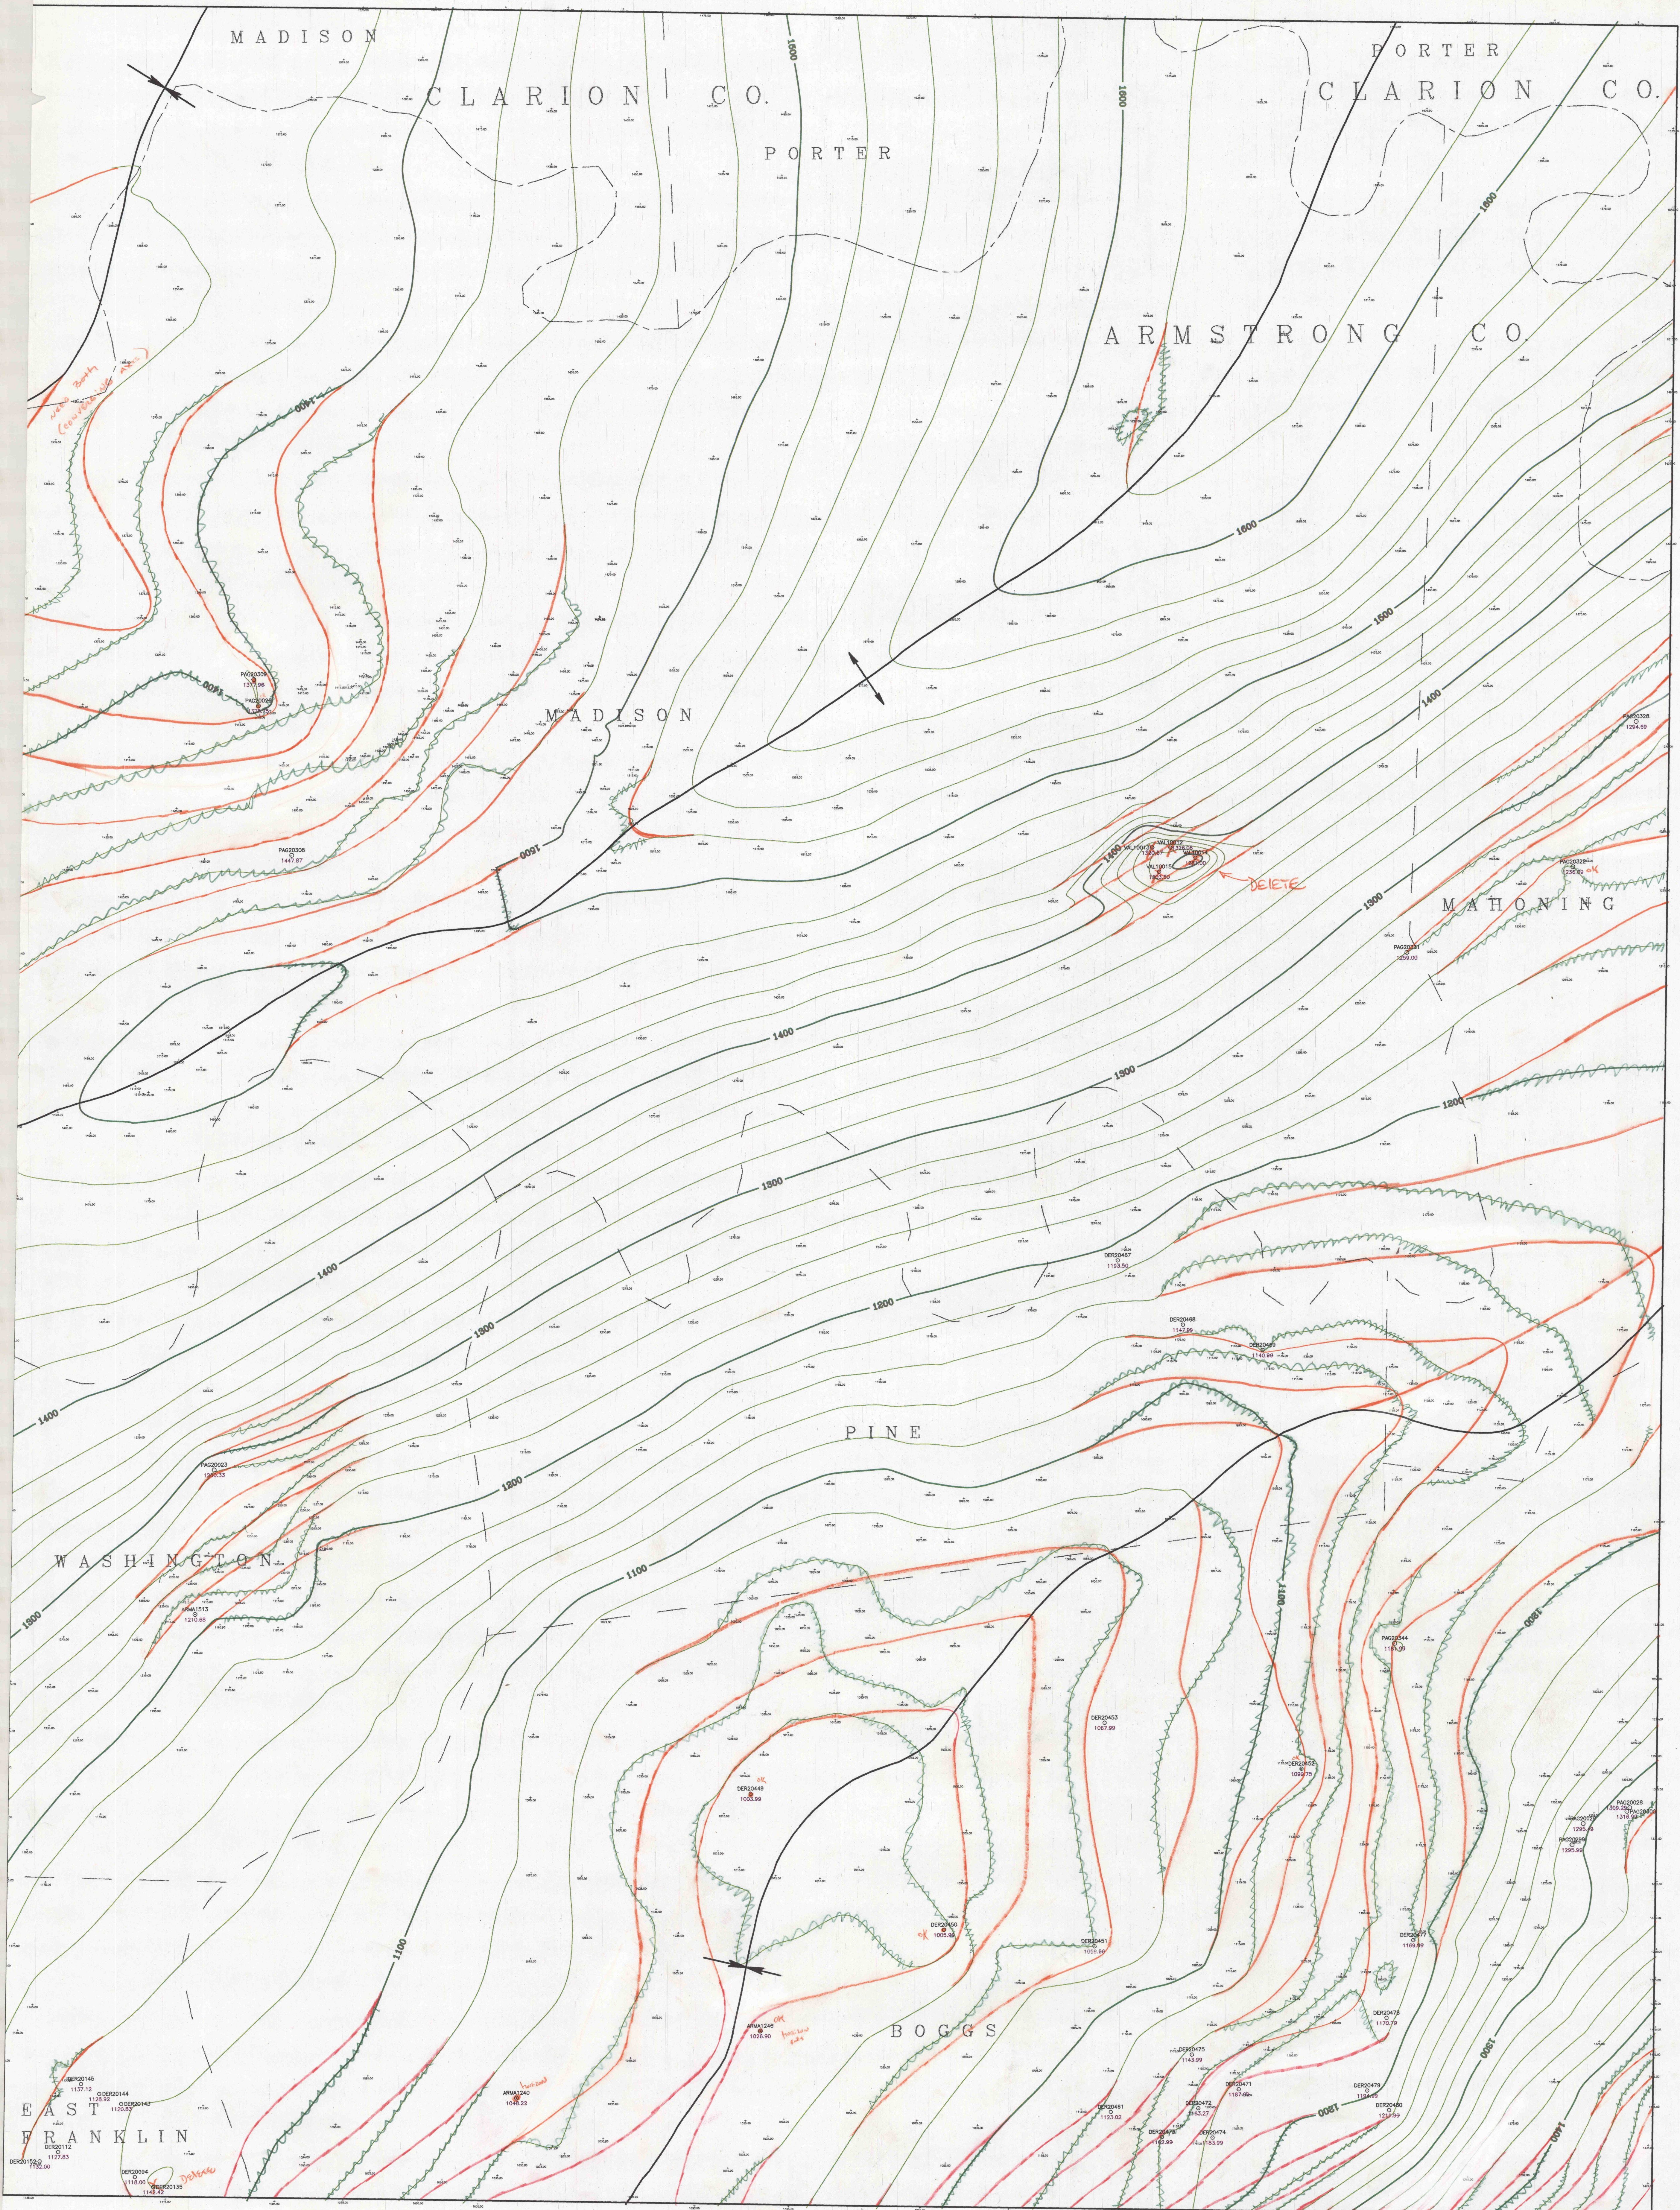

Rochester & Pittsburgh Coal Co.
Armstrong County
Reserve Evaluation
Project

LOWER FREEPORT STRUCTURE MAP
for the
TEMPLETON QUADRANGLE
Scale 1 inch = 1200 feet
December 1991

GRAPHIC SCALE 1"=1200'
0 1200 2400 3600
I MAPS#18861

DATE : MON DEC 9 15:43:38 1991
PROJECT : K:\ARM\TEMPLETON\NEW

