
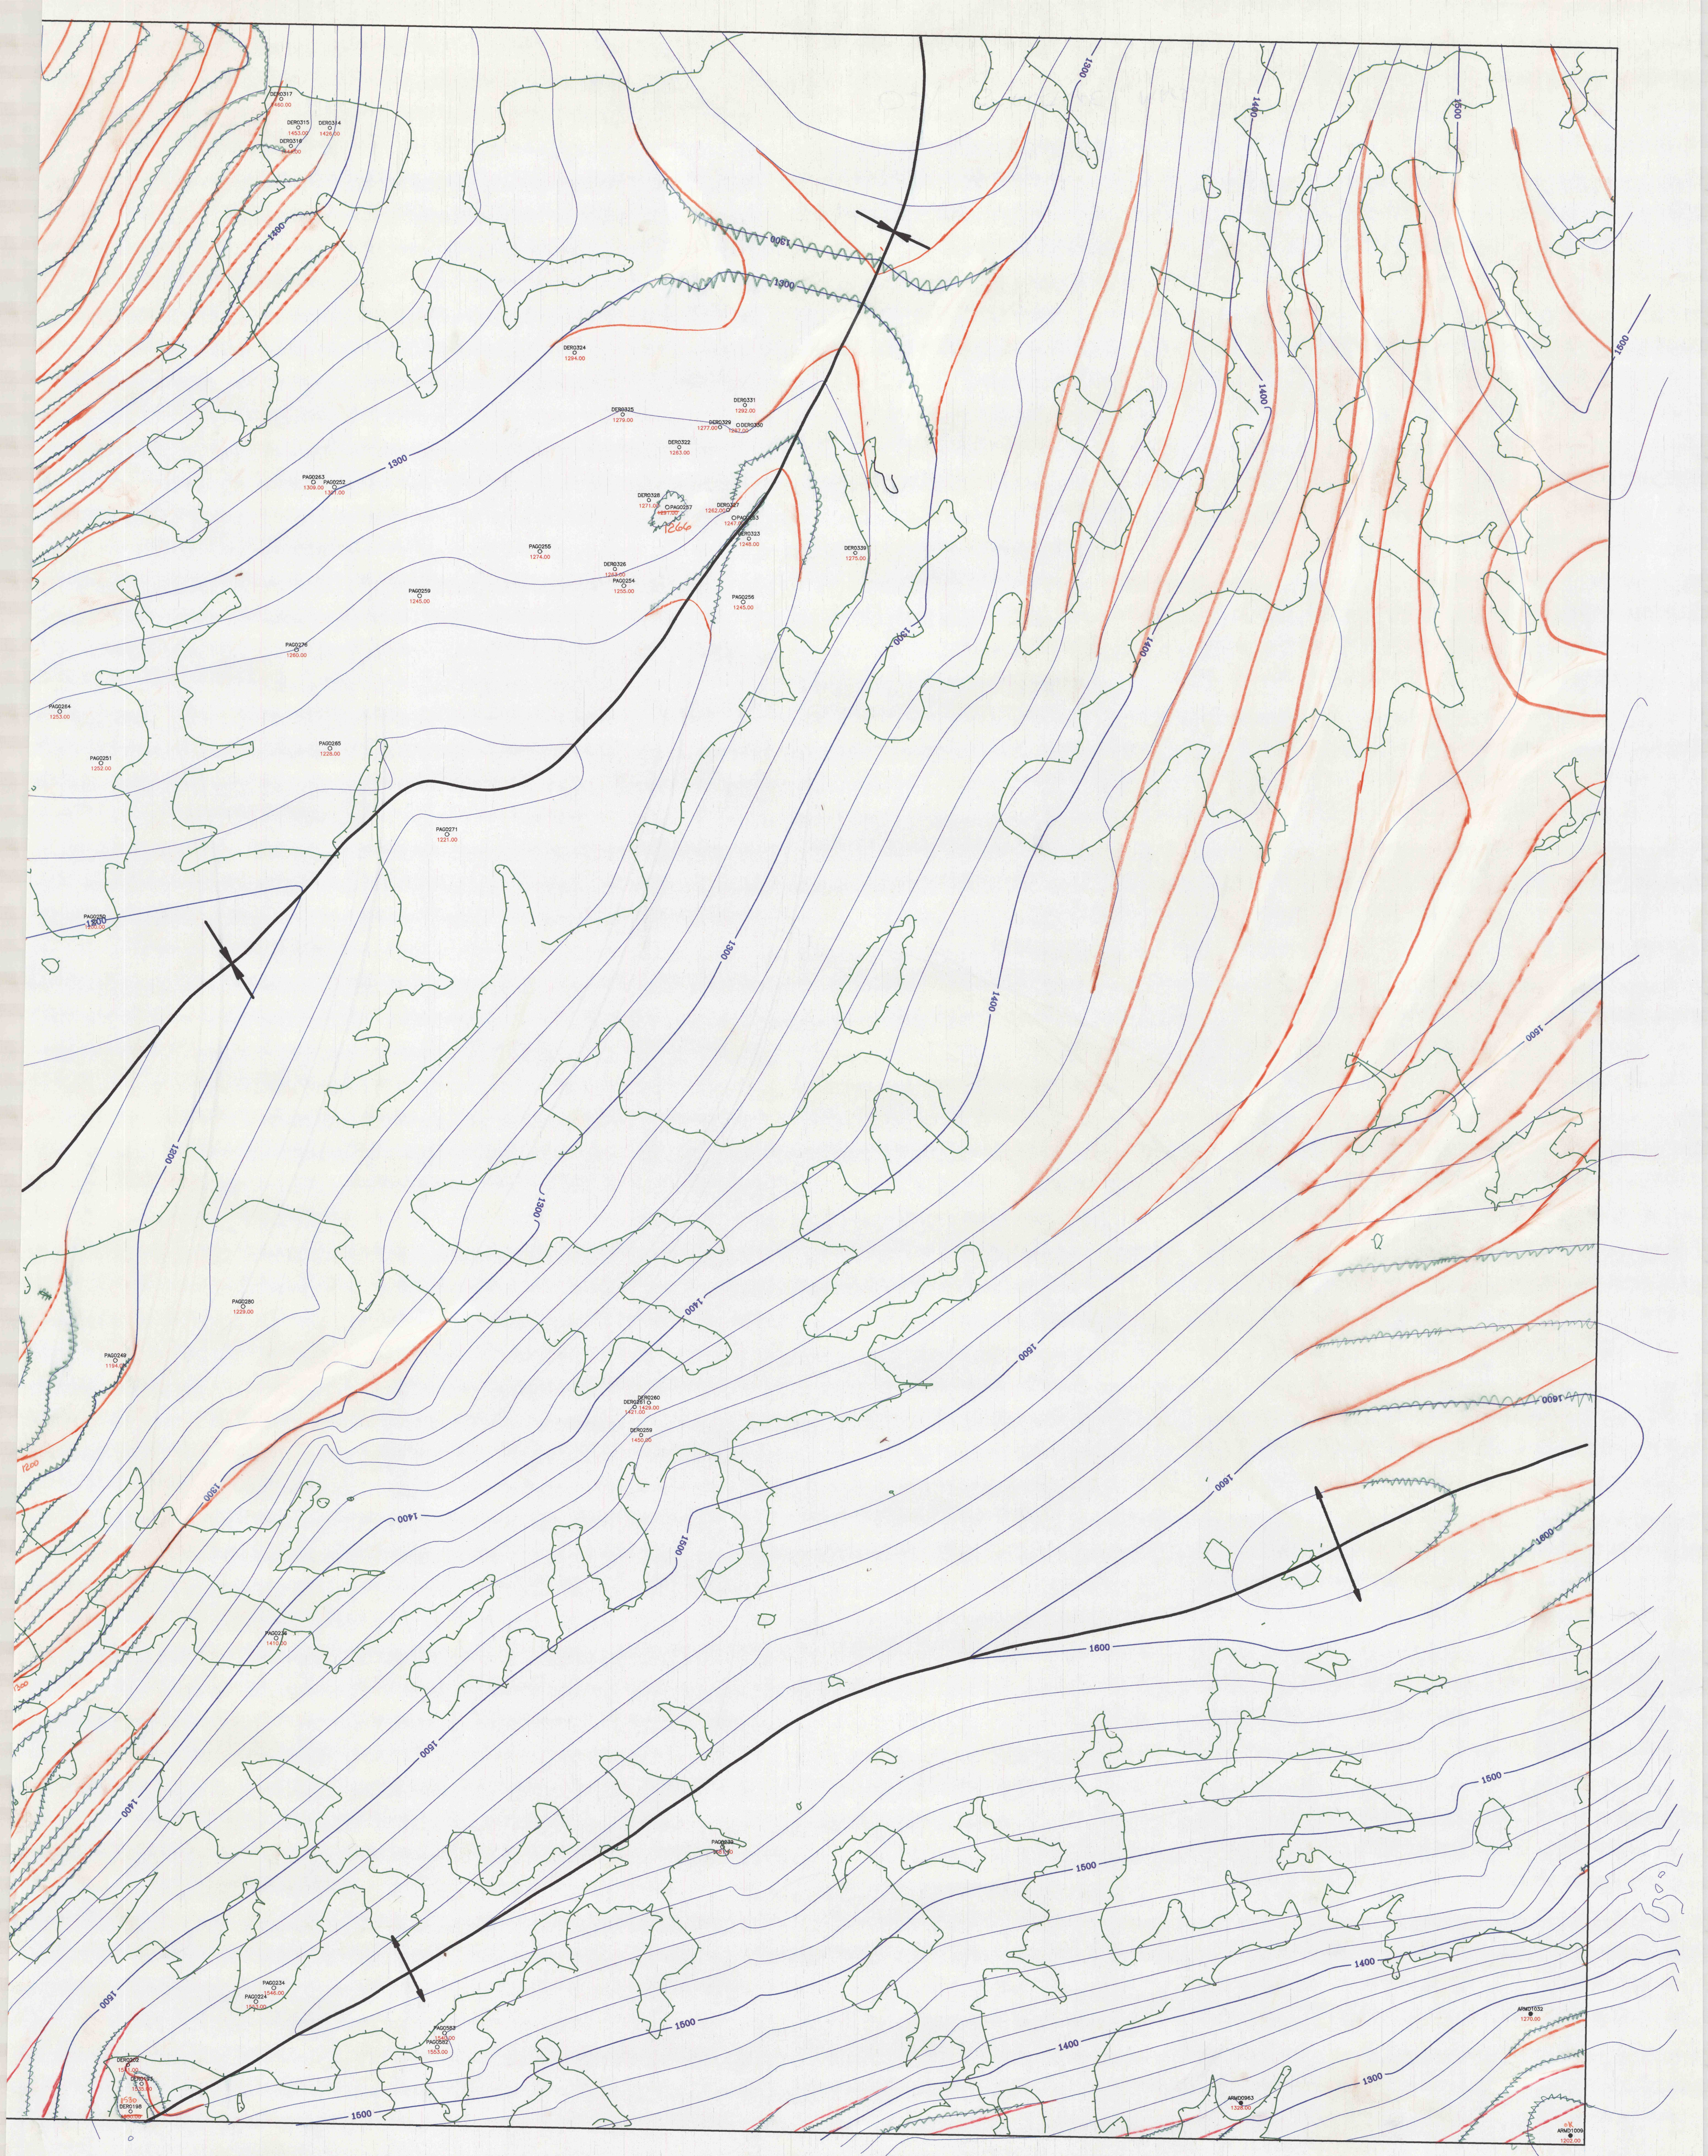


IMAPS#18864

DATE : TUE NOV 12 16:10:04 1991
PROJECT : FA-ARIA DISTANT NEW
TITLE : 021 STRUCTURE WITH CROPLINE

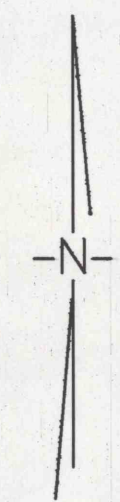

Rochester & Pittsburgh Coal Co.
Armstrong County
Reserve Evaluation
Project

LOWER FREEPORT STRUCTURE MAP

for the
DISTANT QUADRANGLE

Scale 1 inch = 1200 feet

November 1991