


622.1893-1214-115

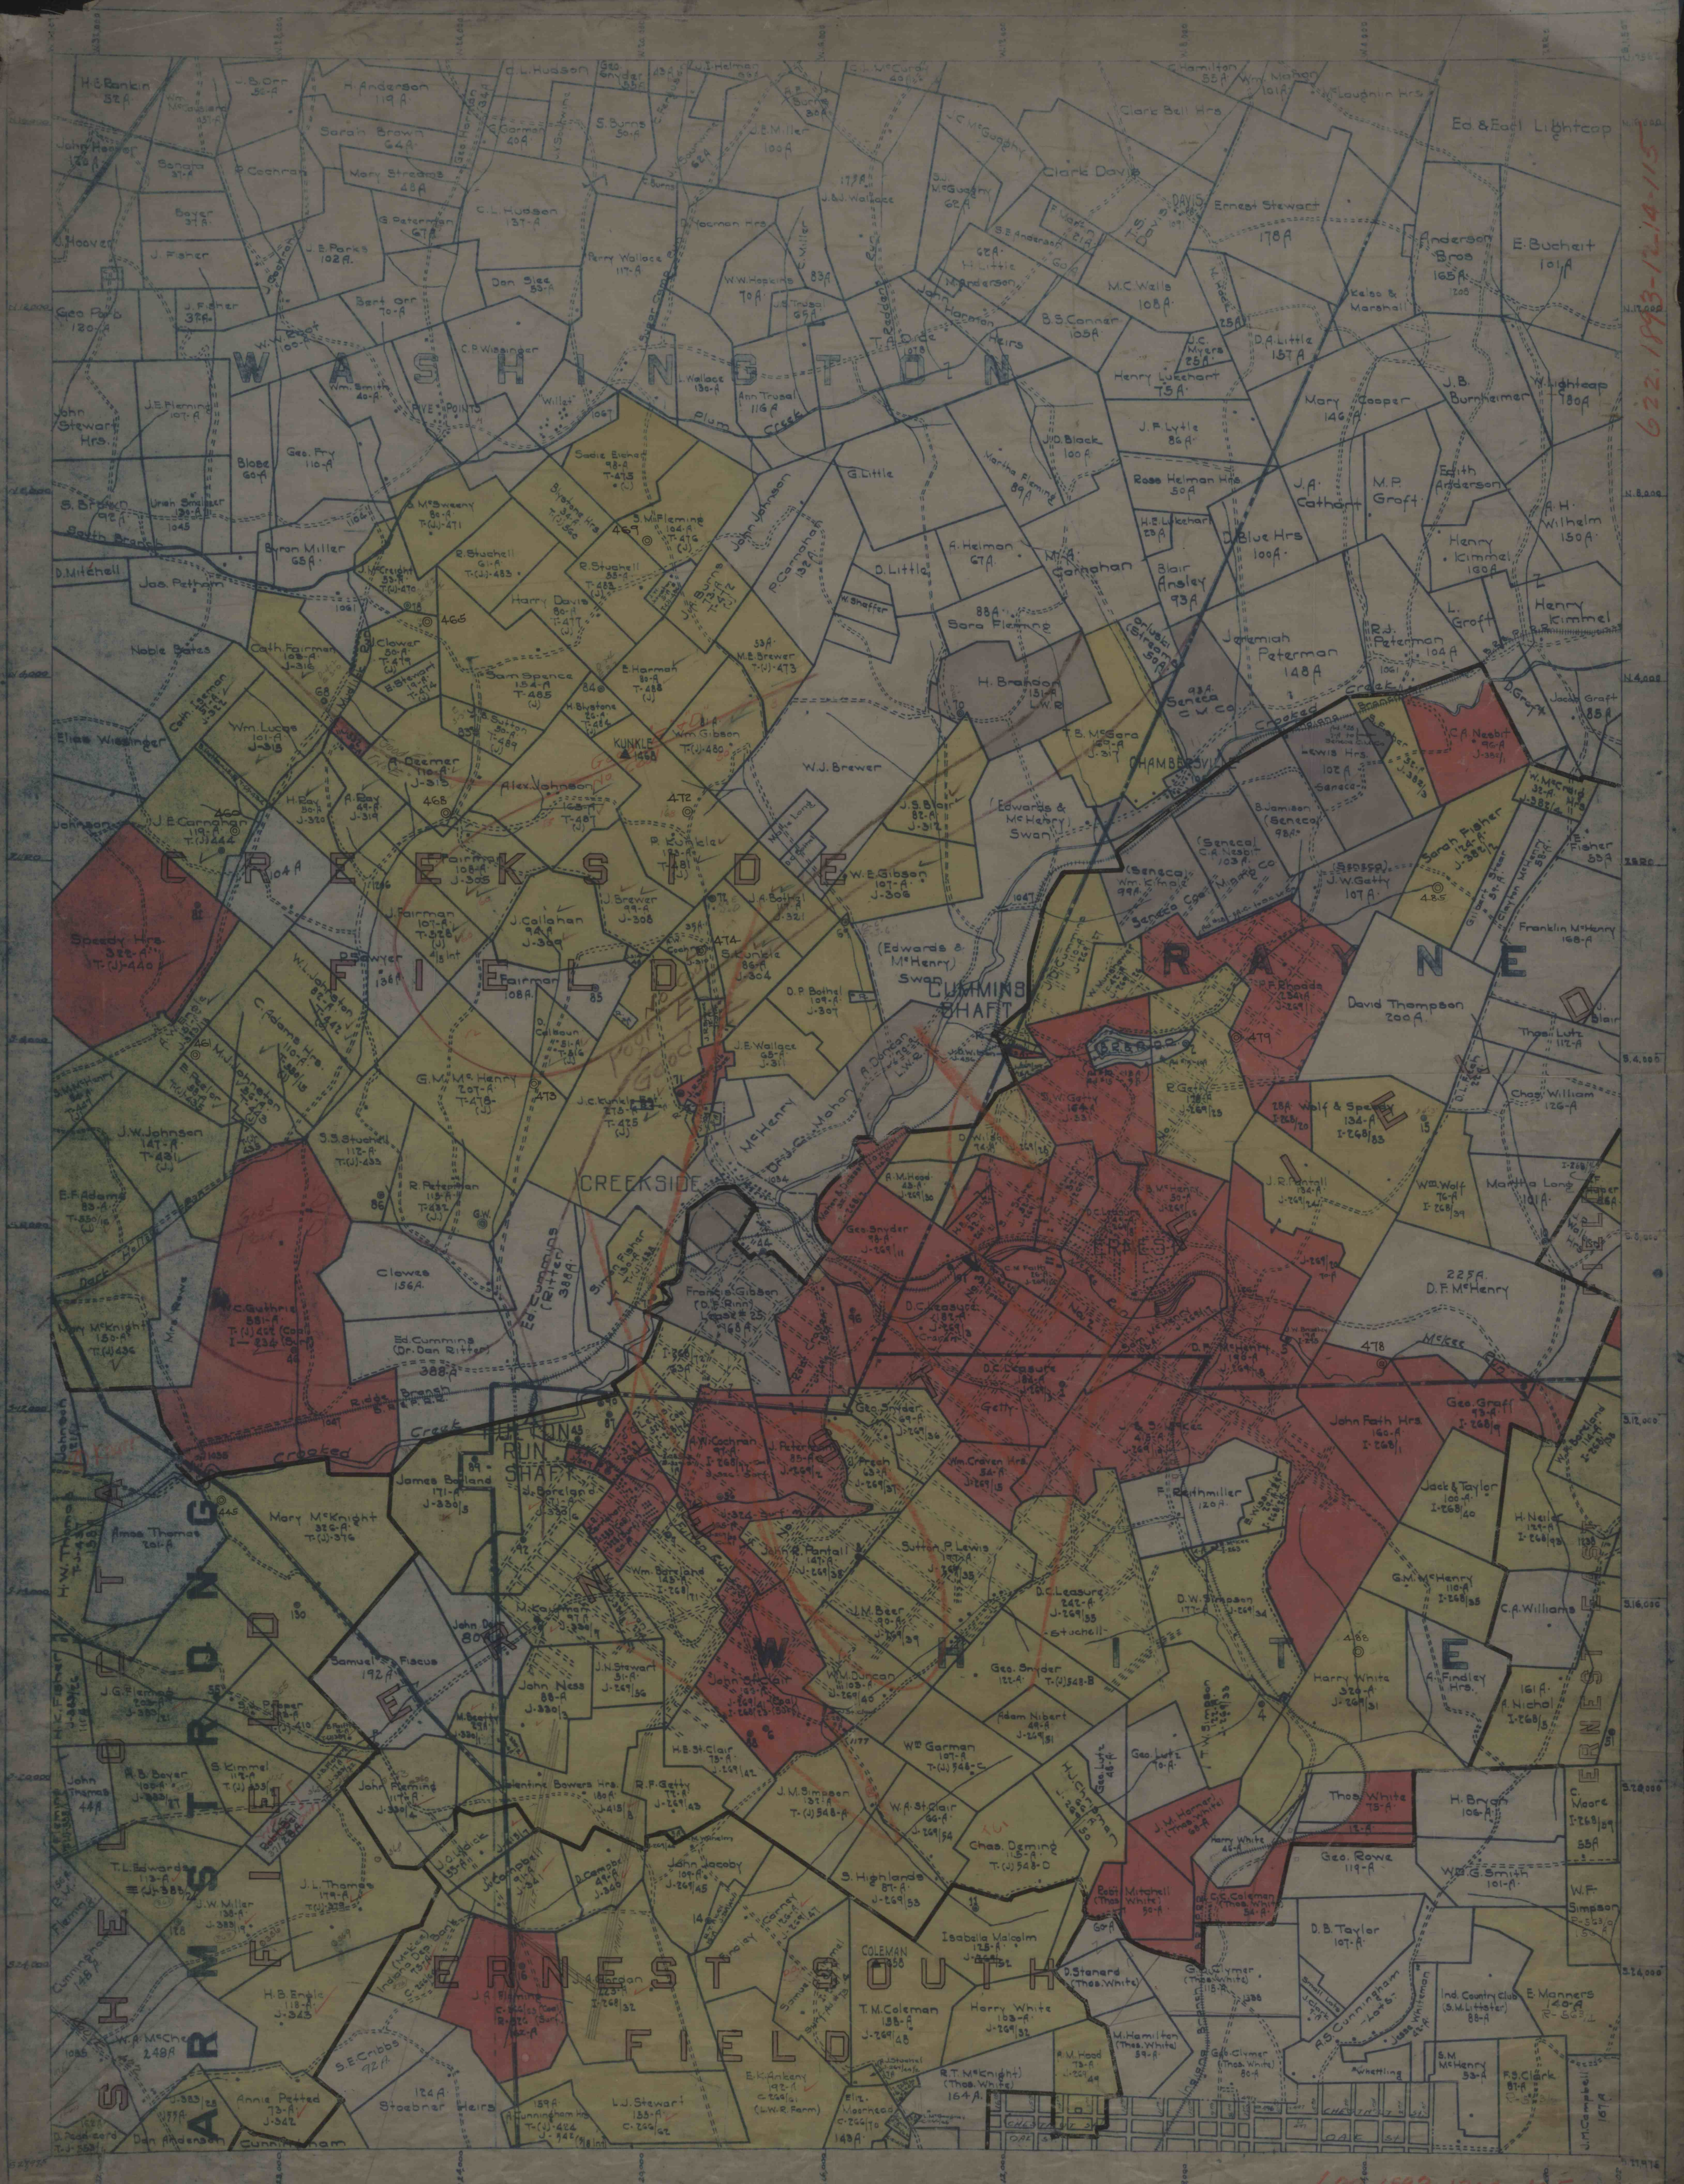

622.1893-1214-115

INDIANA
UPPER LEFT

FILE COPY
RETURN