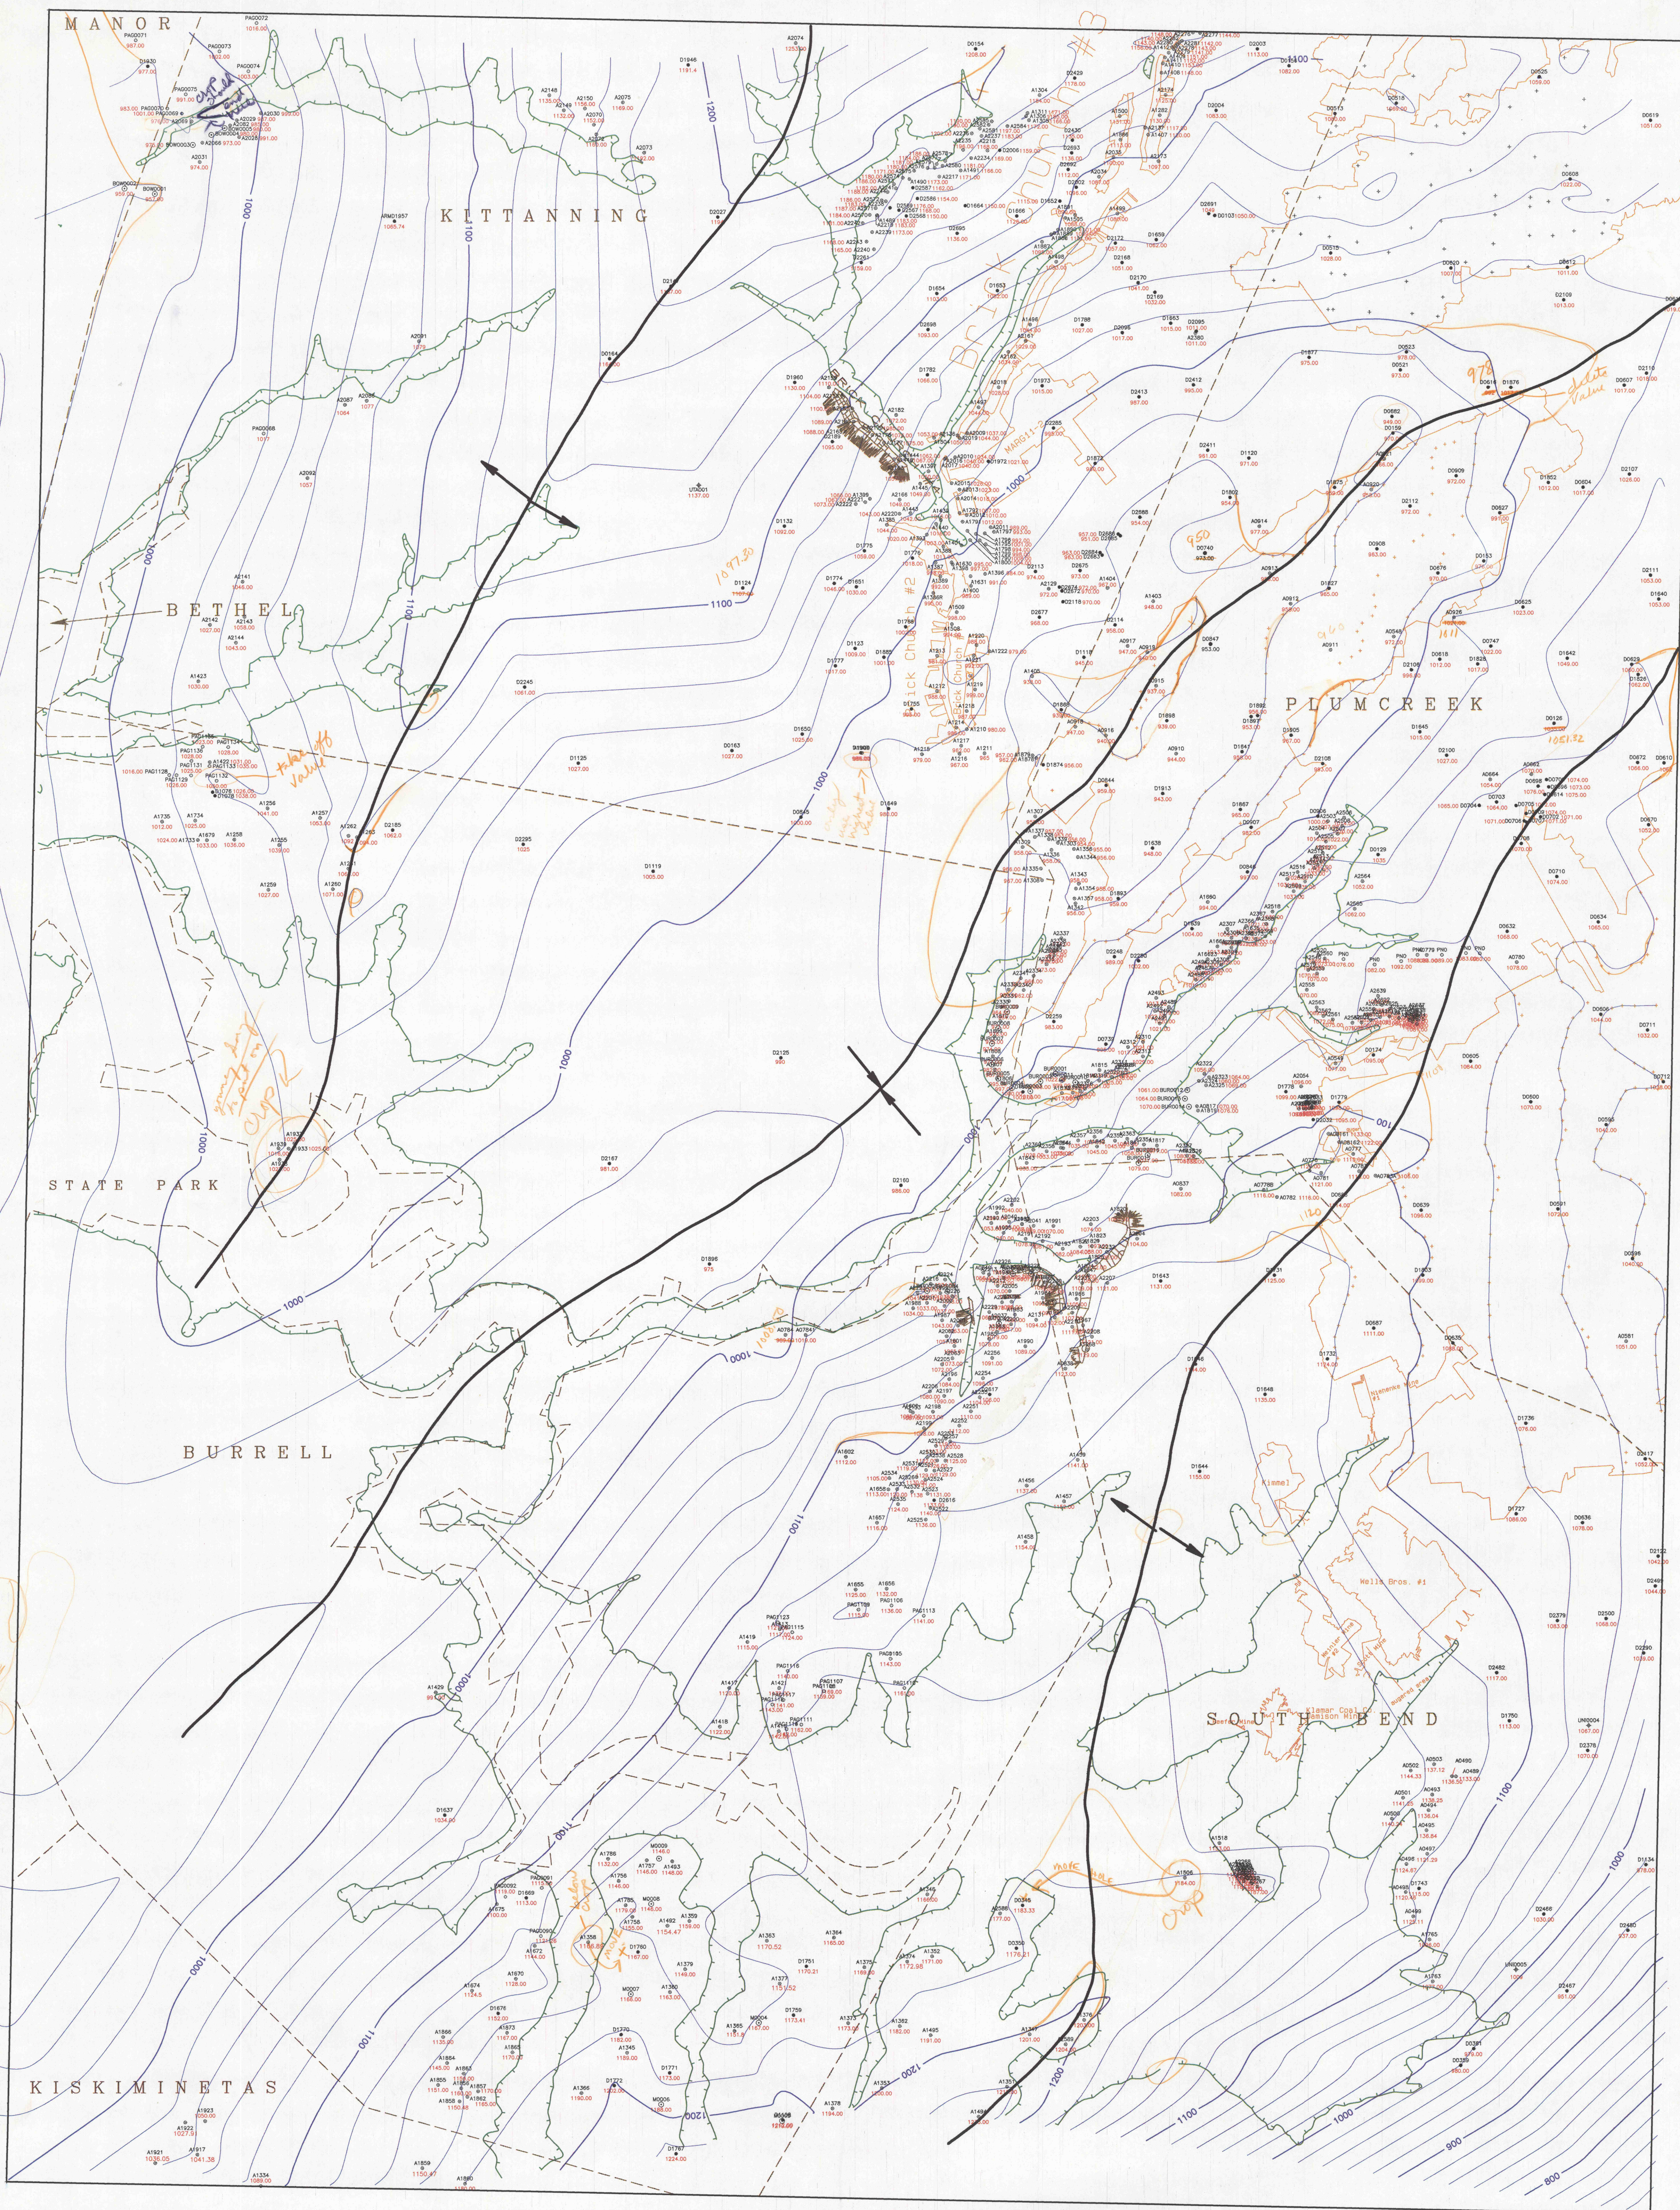


DATE : THU NOV 14 12:59:20 1991
PROJECT : F:\ARM\WHB\G.STC
TITLE : UPPER FREEPORT STRUCTURE W/ CROP

Rochester & Pittsburgh Coal Co.
Armstrong County
Reserve Evaluation
Project

UPPER FREEPORT STRUCTURE MAP
for the
WHITESBURG QUADRANGLE
Scale 1 inch = 1200 feet
October 1991

IMAPS#18895