
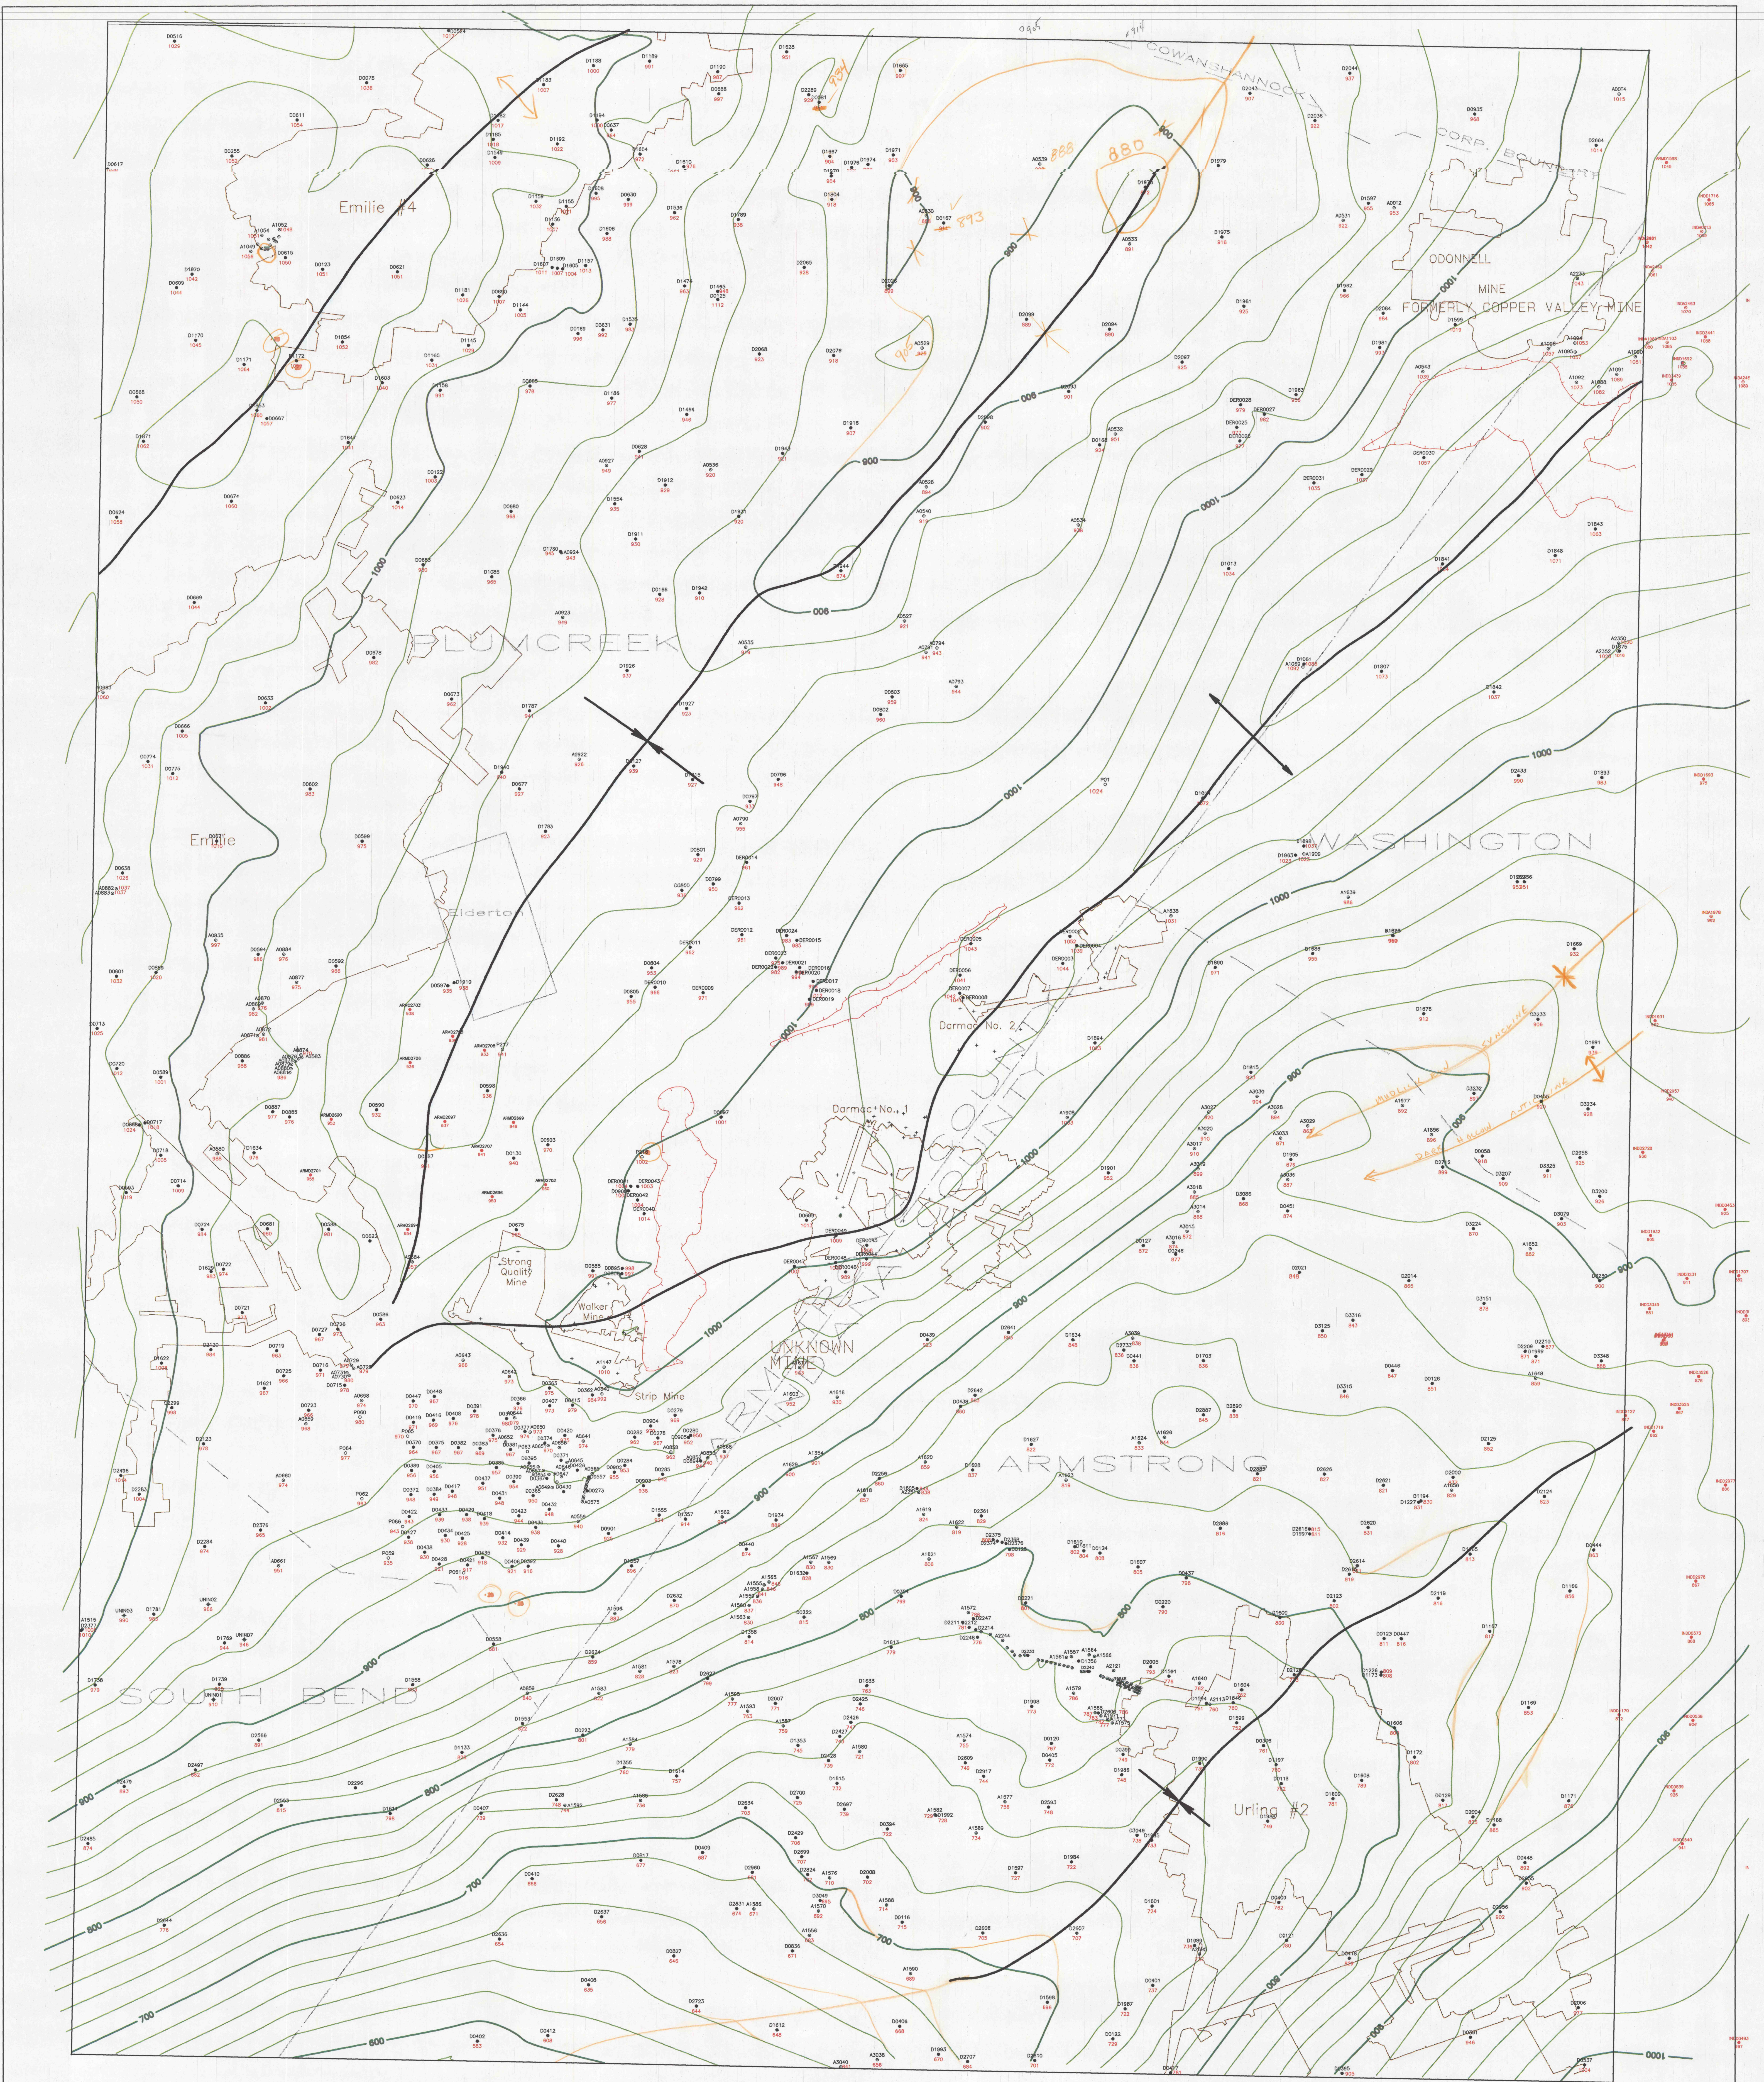


DATE : THU DEC 12 11:28:35 1991
PROJECT : F:\PETE\ELDERTON\EL020ST
TITLE : UPPER FREEPORT STRUCTURE MAP WITH CROP

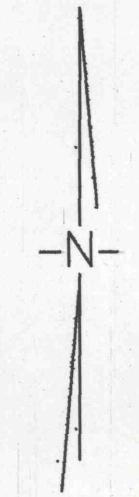

Rochester & Pittsburgh Coal Co.
Armstrong County
Reserve Evaluation
Project
UPPER FREEPORT STRUCTURE MAP
For the
ELDERTON QUADRANGLE
Scale 1 inch = 1200 feet November 1991

IMAPS#18896