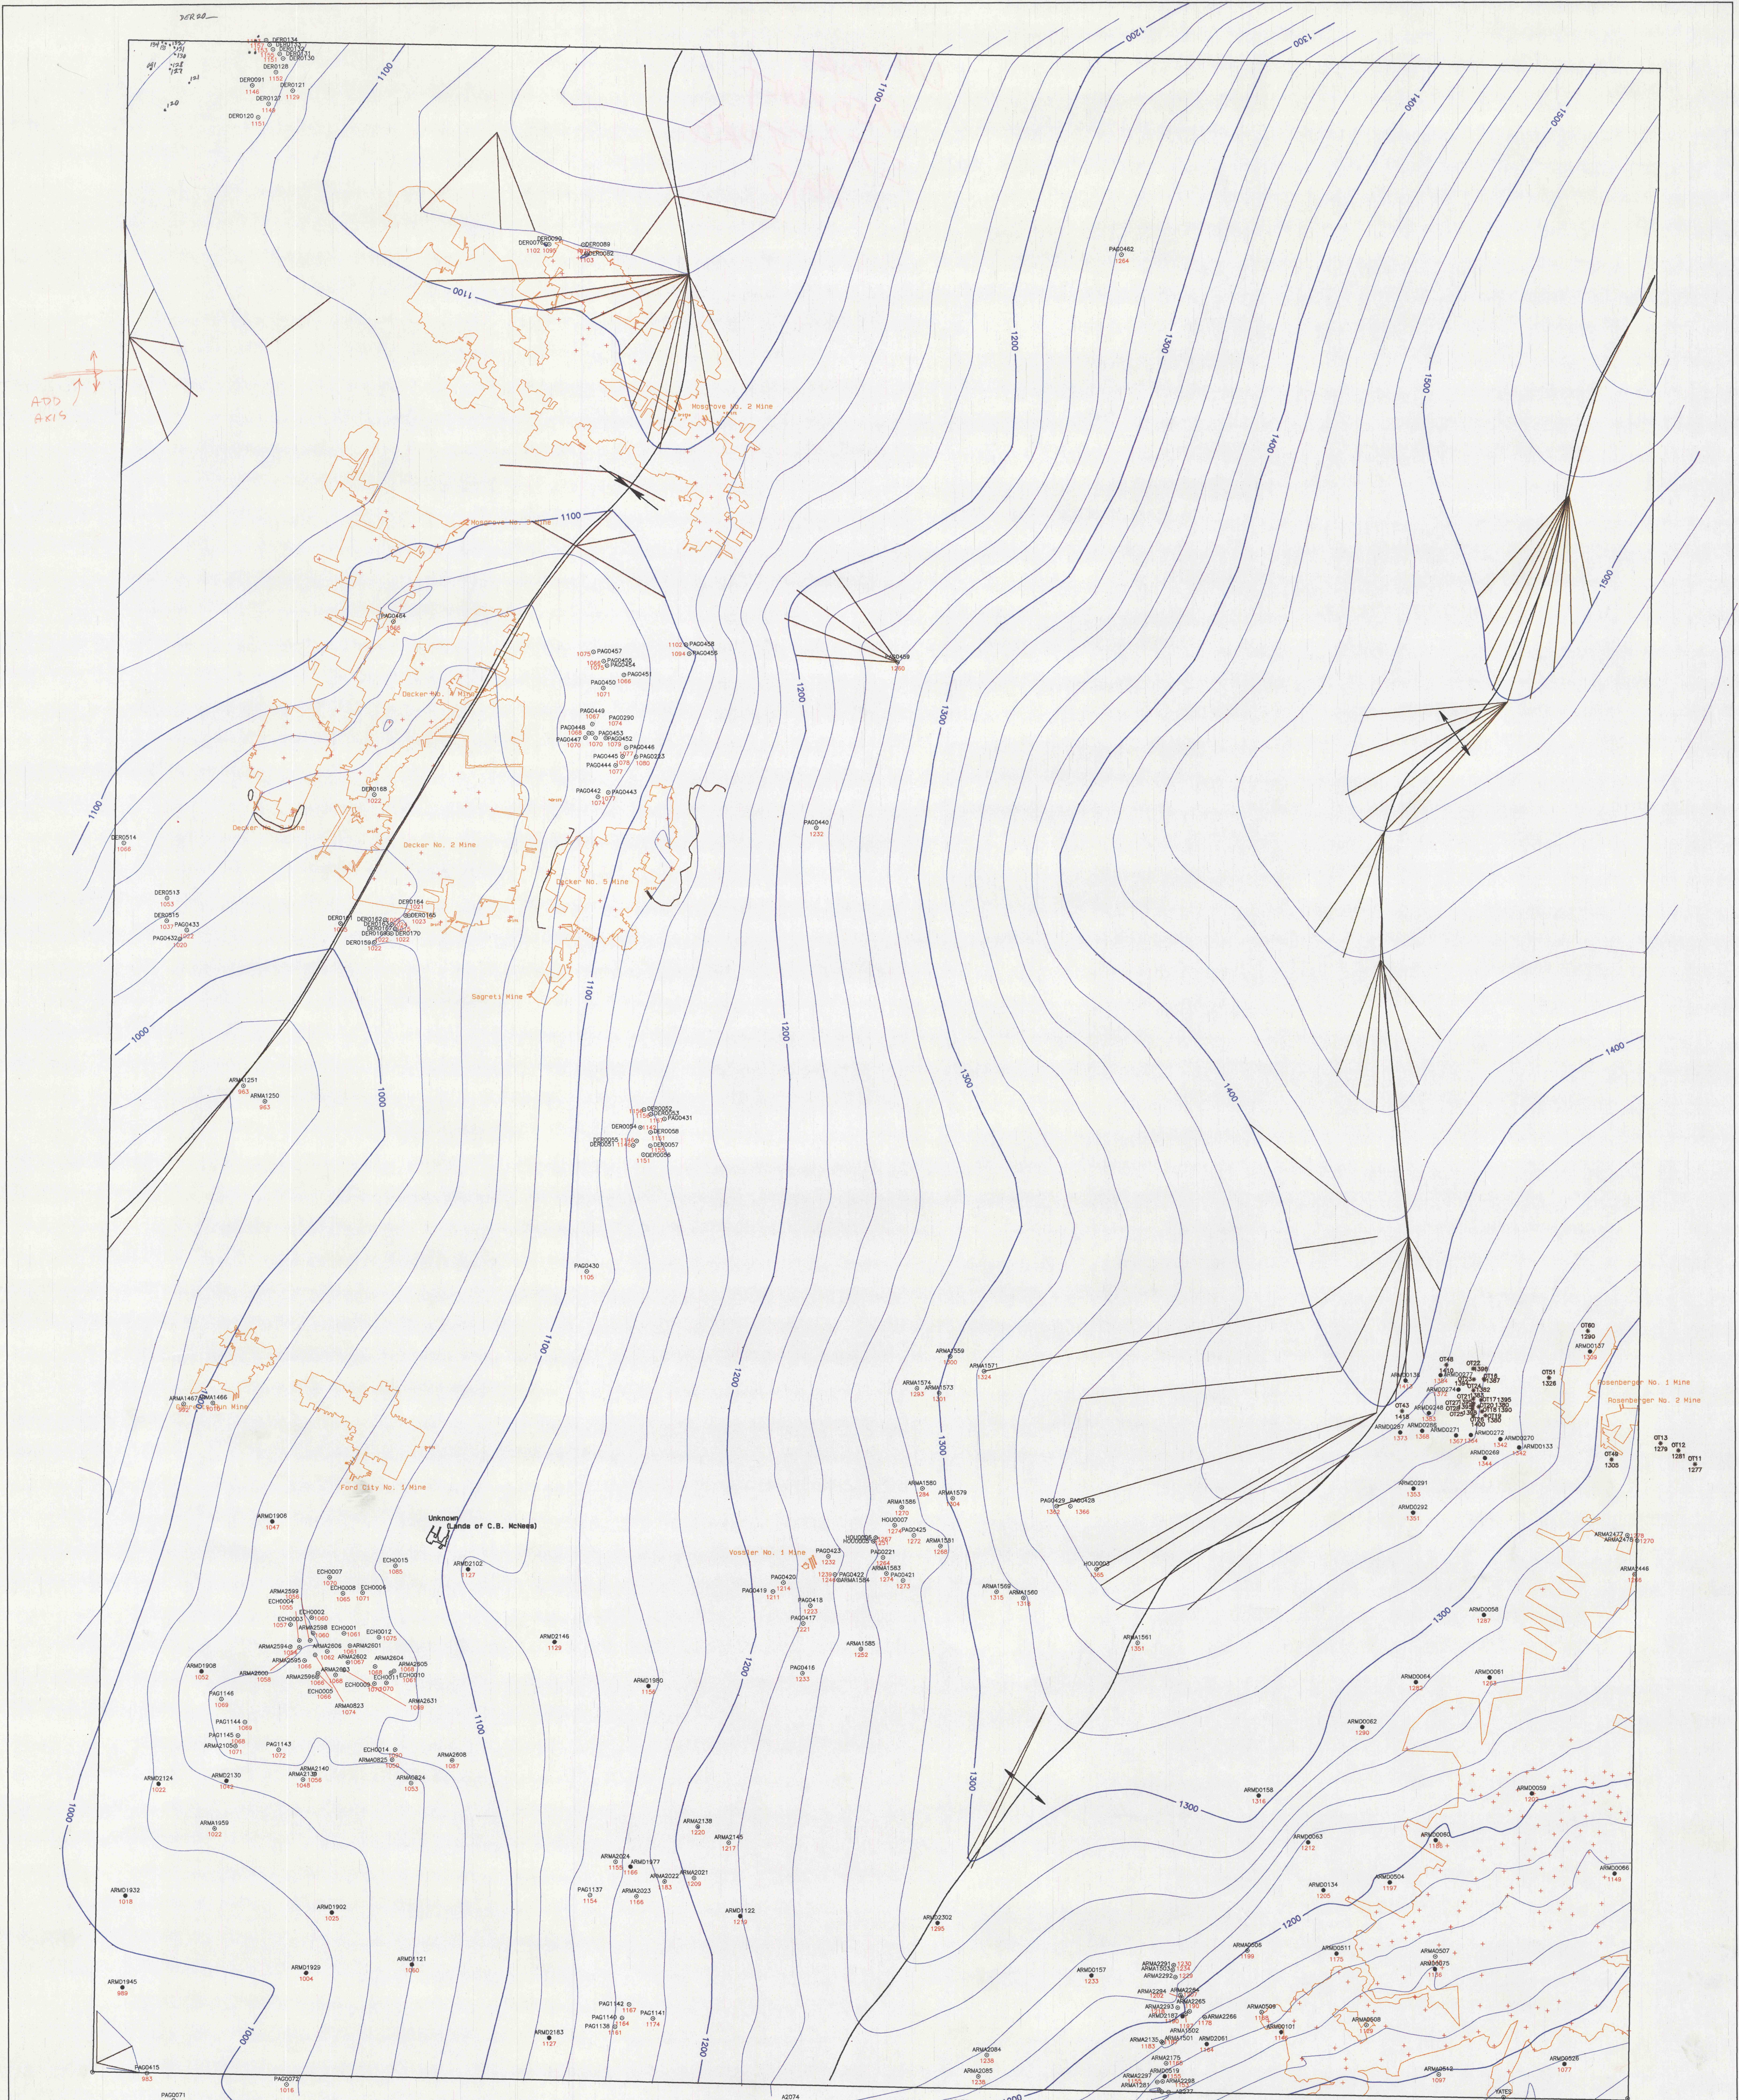


Do not
USE
UBW MAP Bx15
PETB
2-3-92

Rochester & Pittsburgh Coal Co.
Armstrong County
Reserve Evaluation
Project
UPPER FREEPORT STRUCTURE MAP
for the
MOSGROVE QUADRANGLE
Scale 1" = 1200' NOVEMBER 1991

IMAPS#18898