



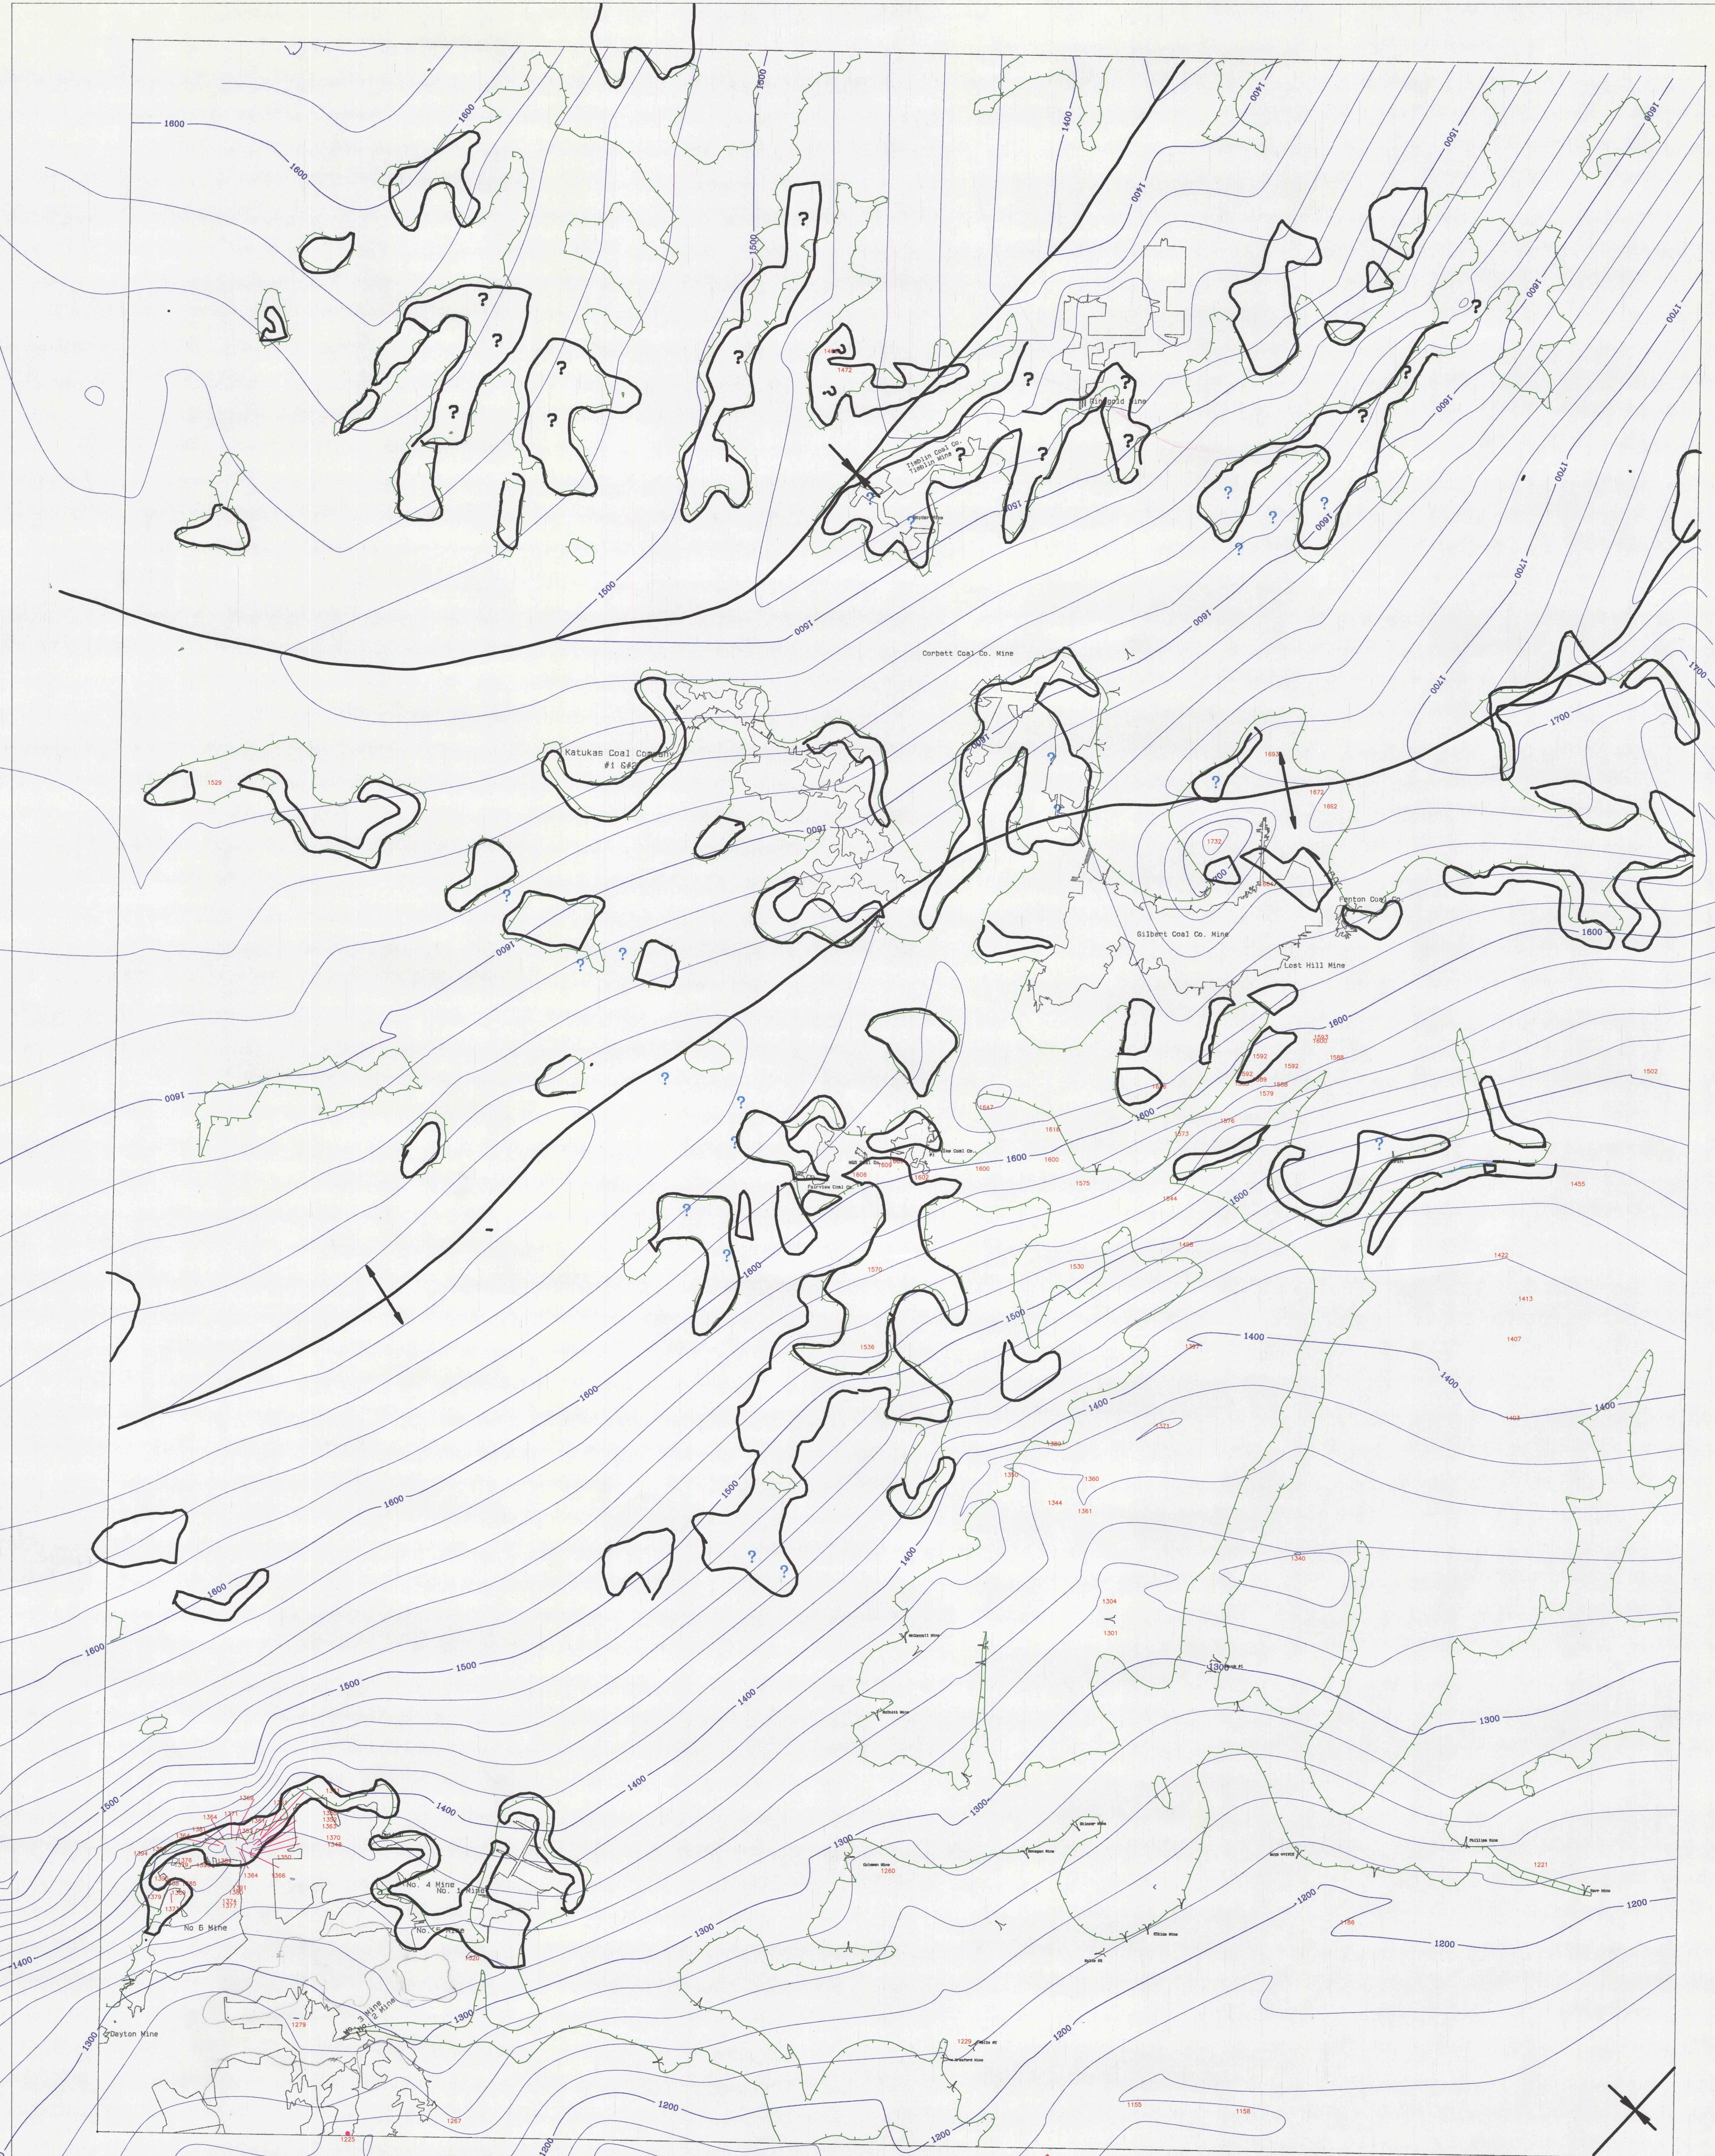

Do not use
NEW MAP
Exists
Pete 1-3-92

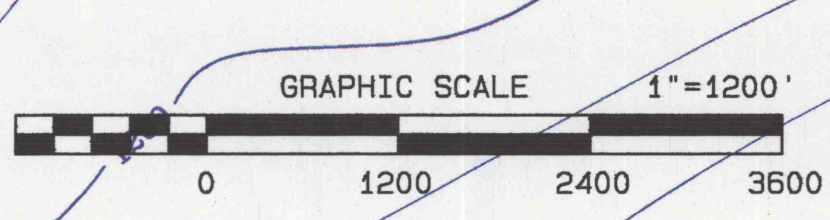

DATE : THU NOV 21 05:33:39 1991
PROJECT : F:\ARM\DAYTON\02XSTRC
TITLE : UPPER FREEPORT STRUCTURE MAP

Rochester & Pittsburgh Coal Co.
Armstrong County
Reserve Evaluation
Project

UPPER FREEPORT STRUCTURE
for the
DAYTON QUADRANGLE
Scale 1 inch = 1200 feet November 1991

IMAPS#18900