


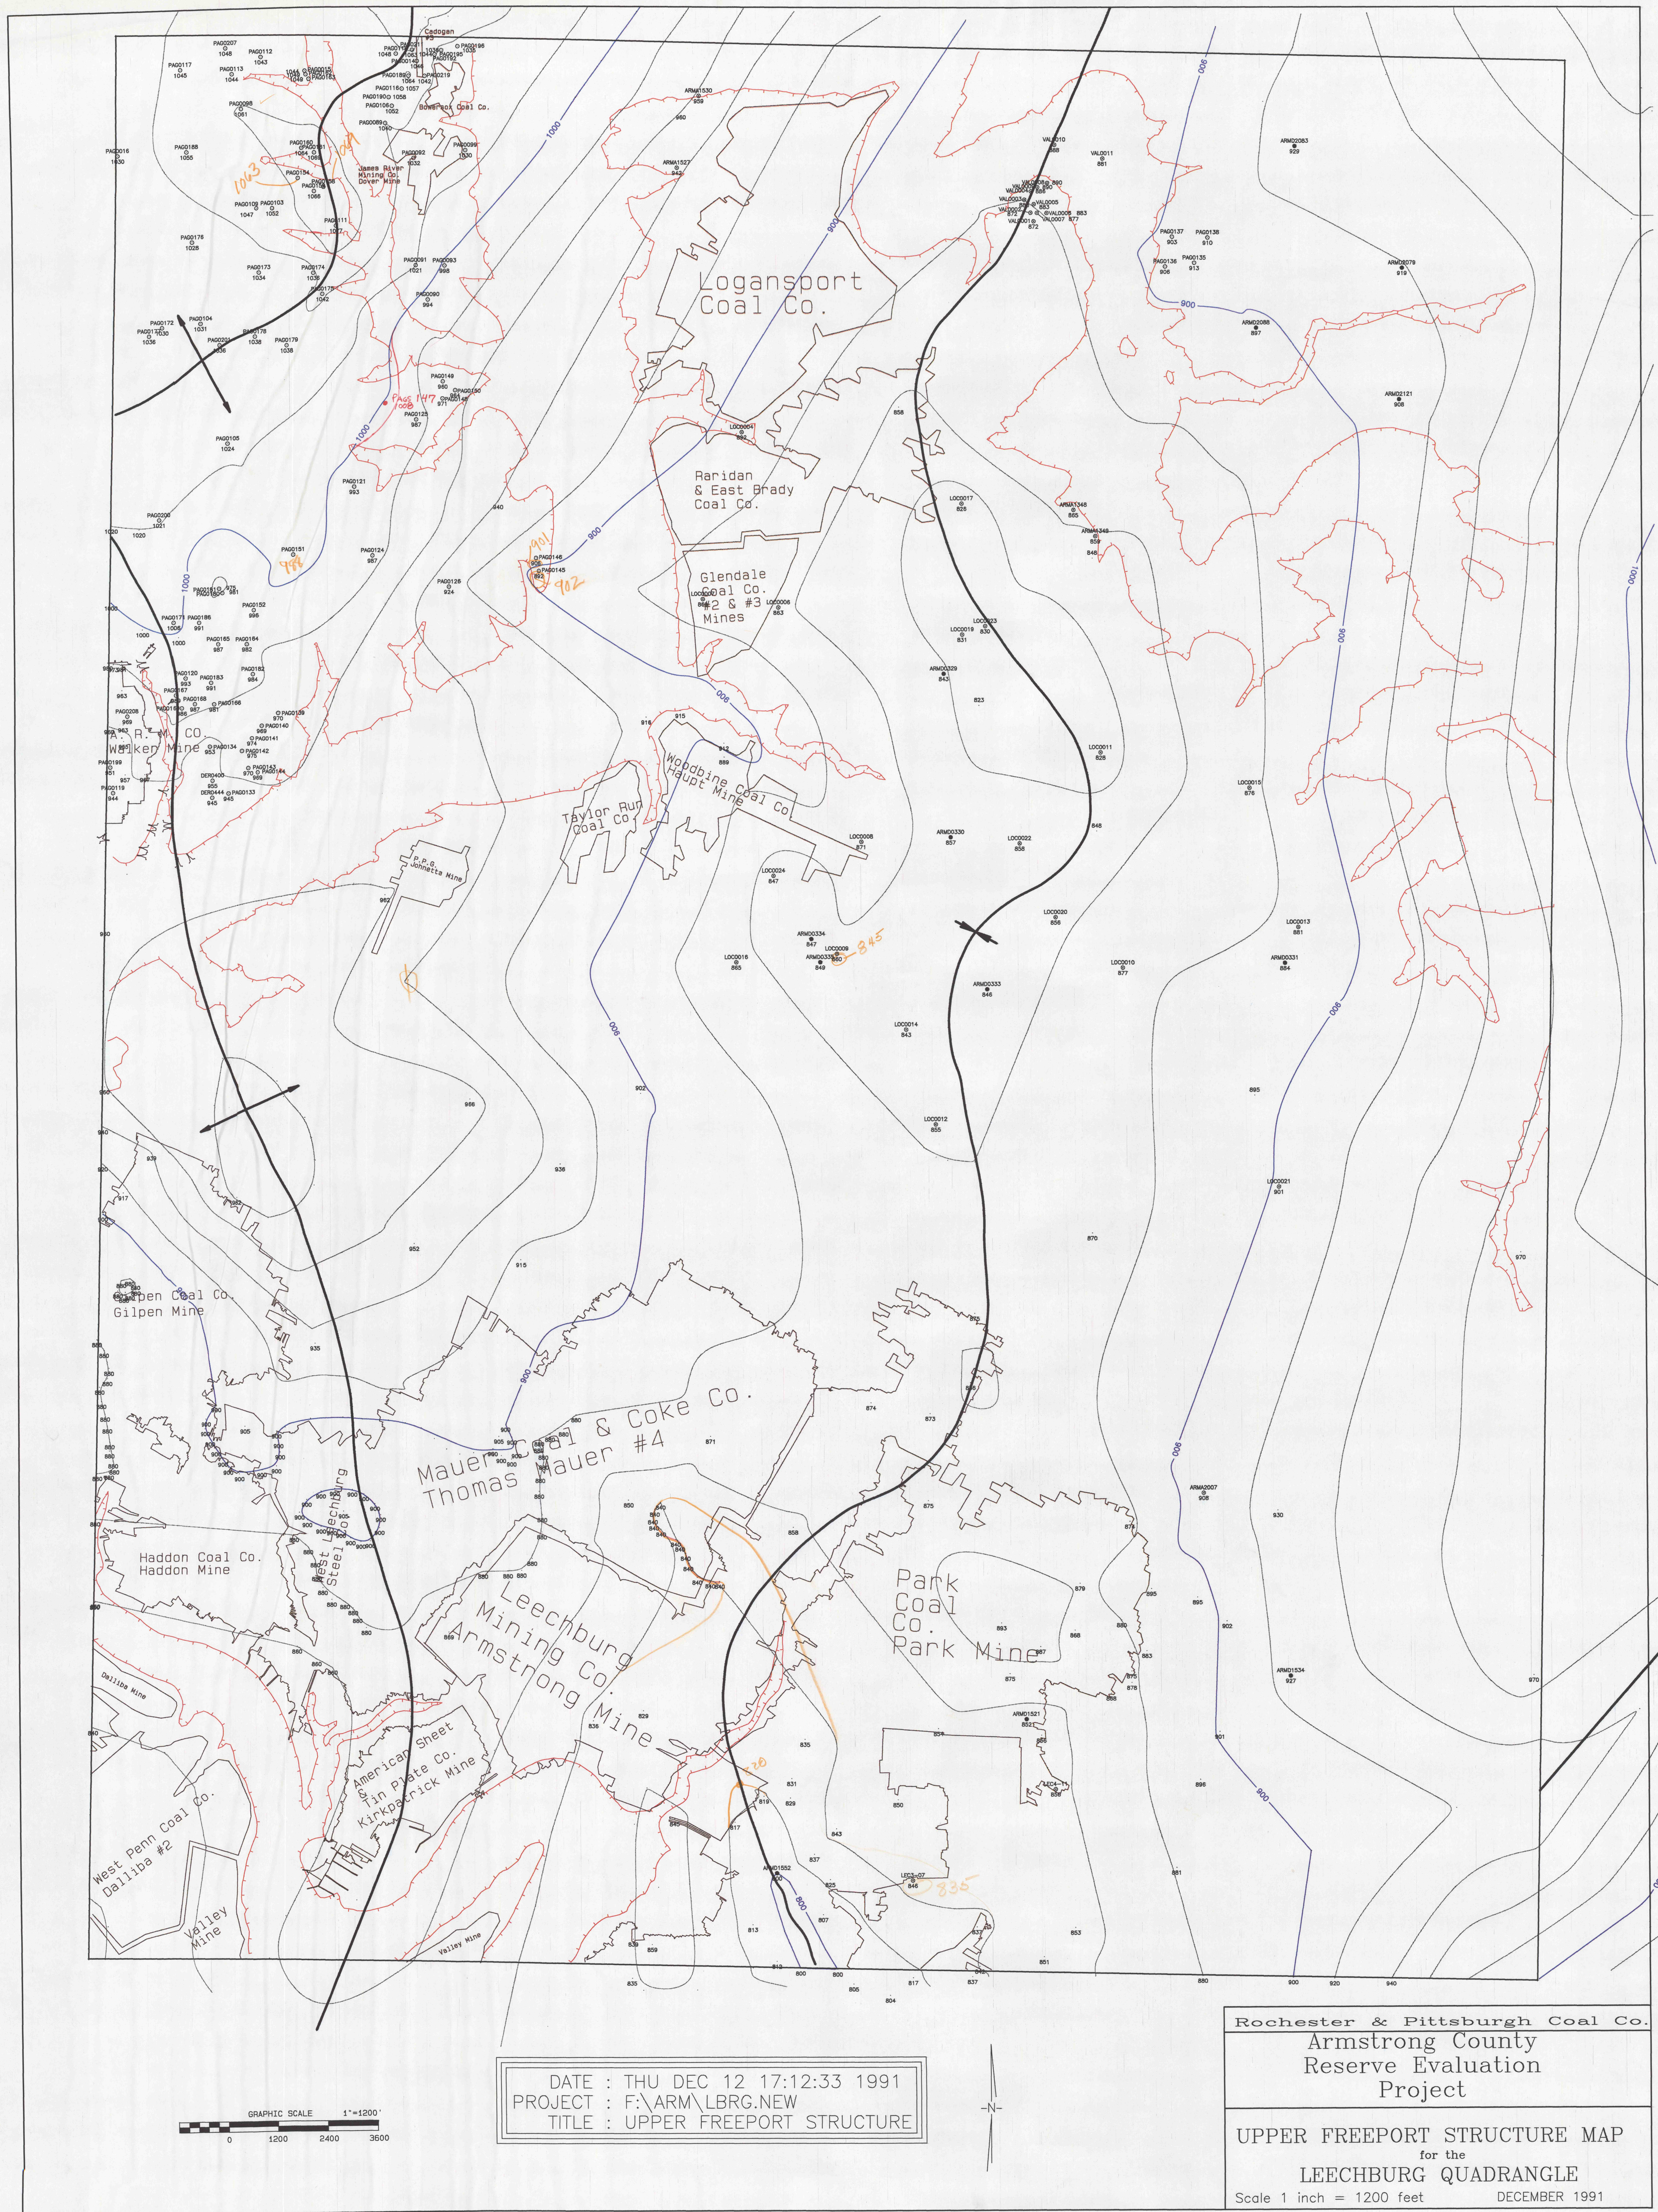

IMARS #18903