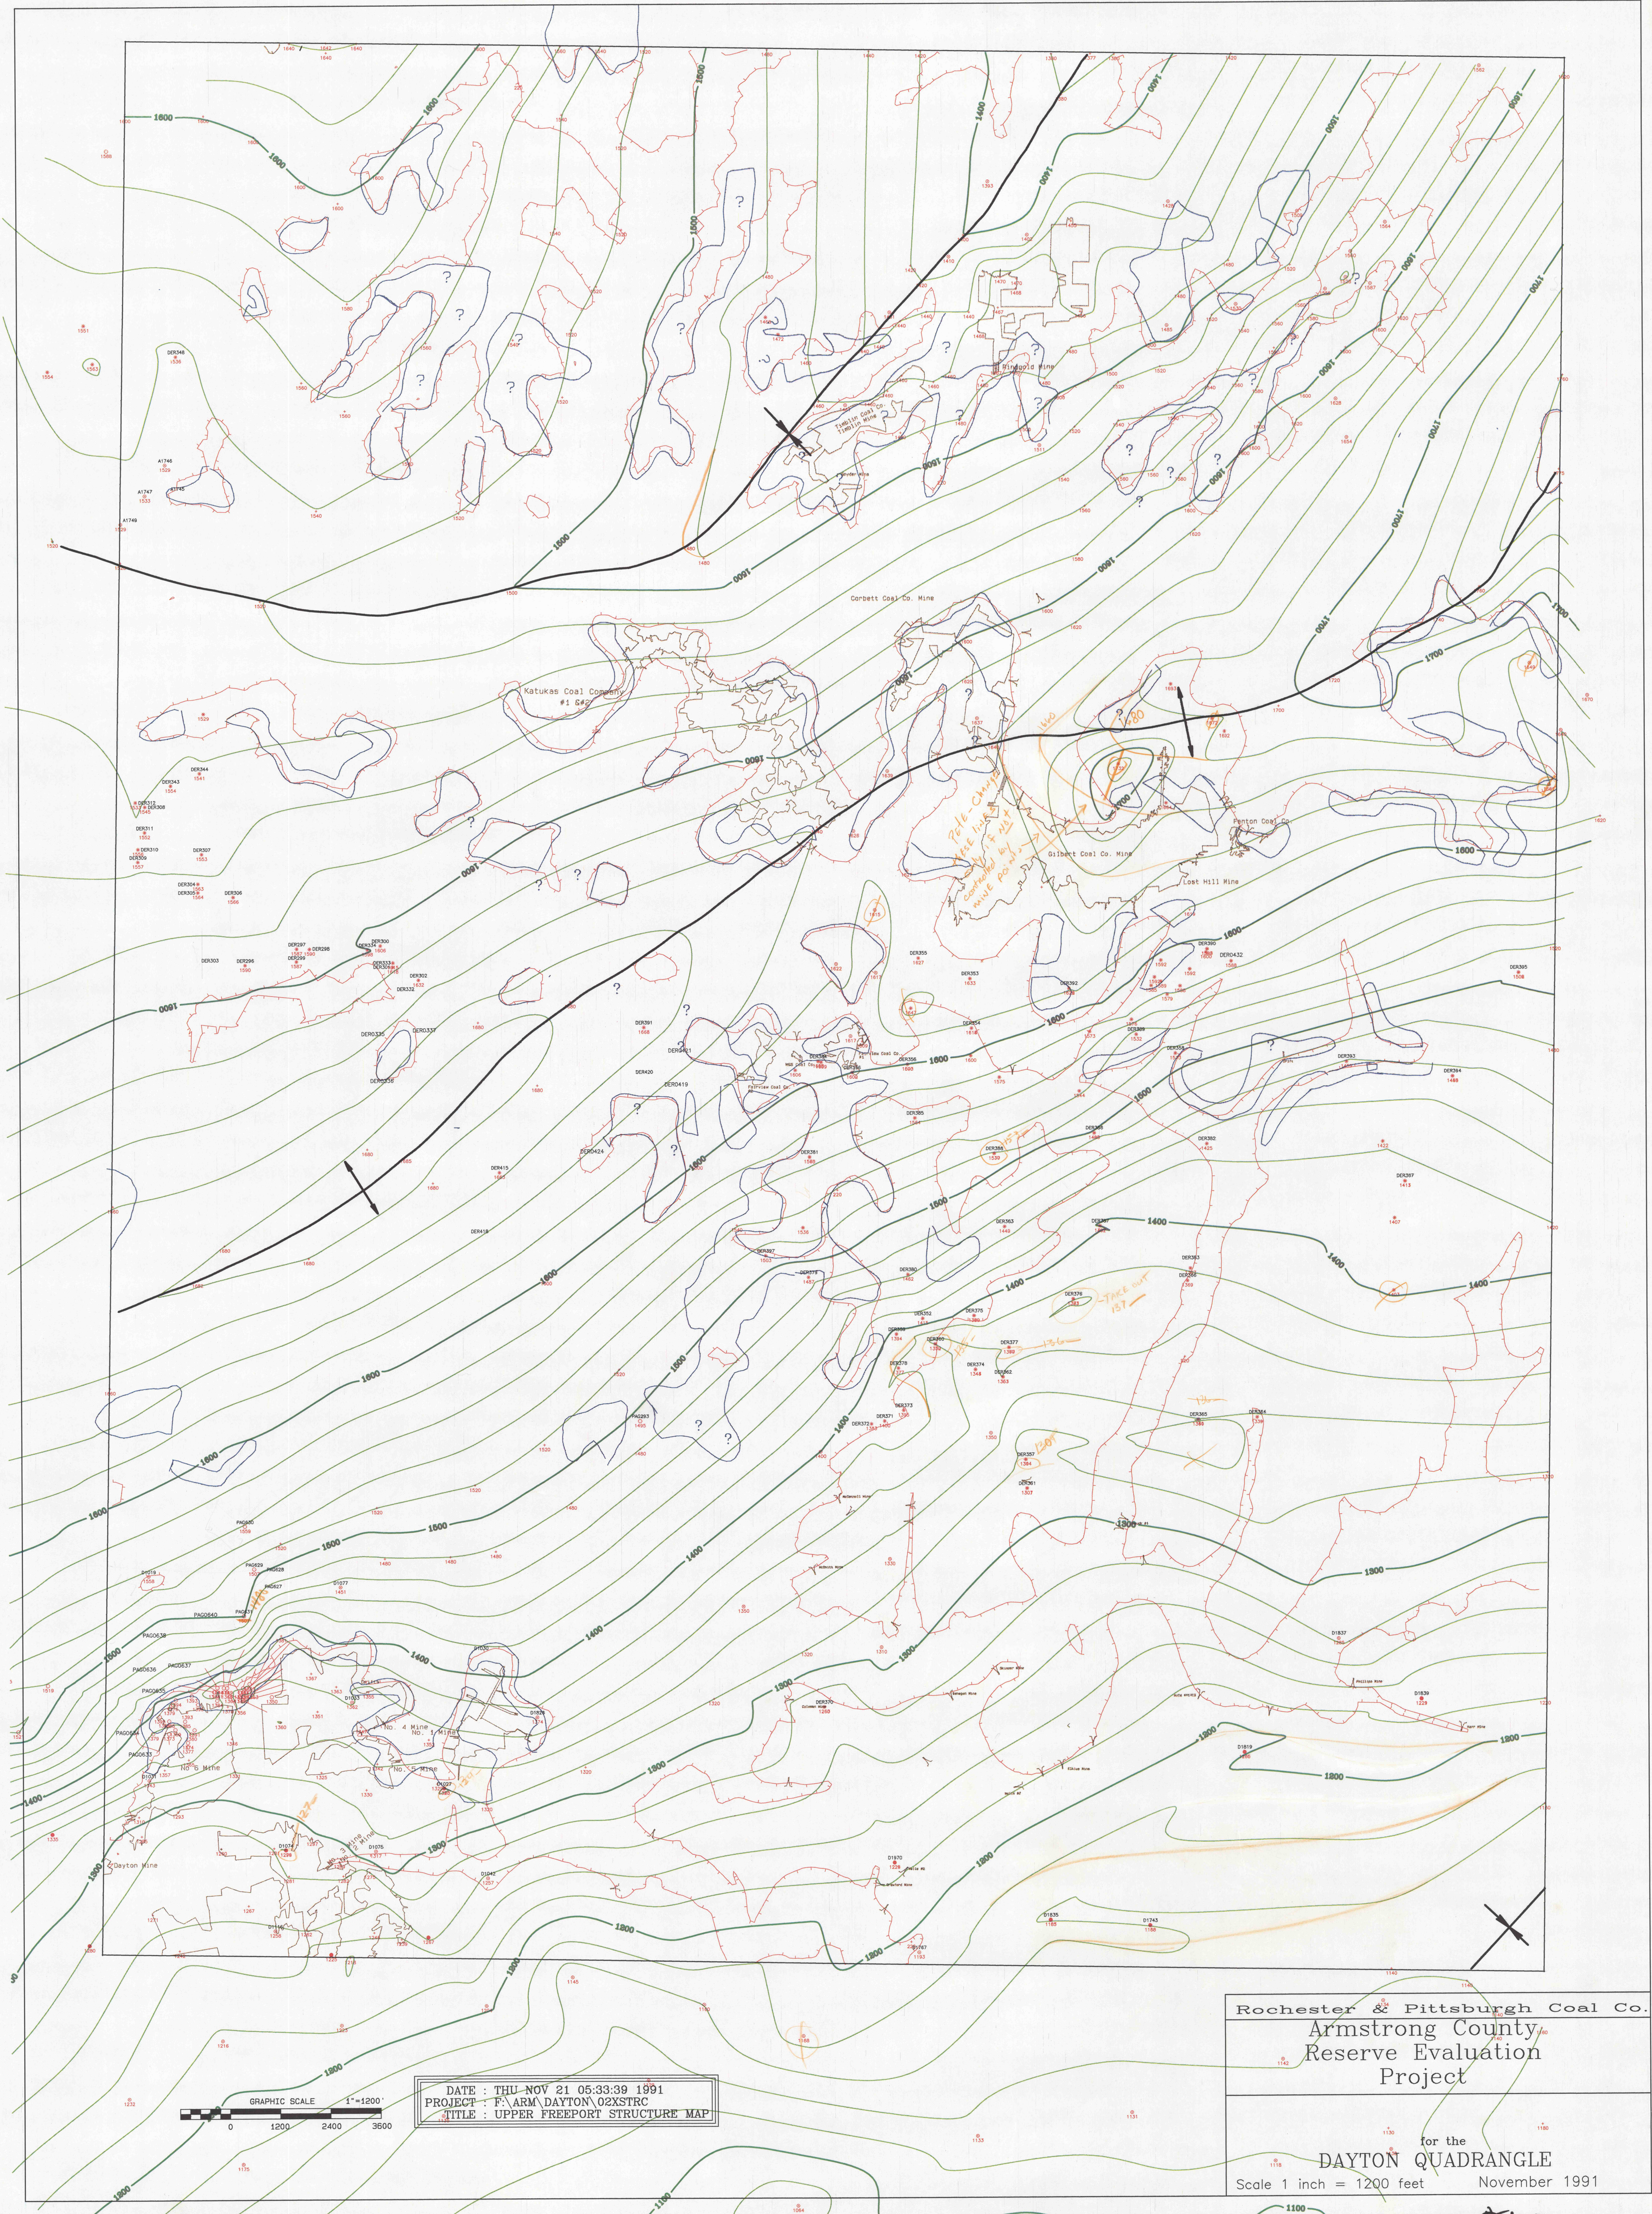


DATE : THU-NOV 21 05:33:39 1991  
PROJECT : F:\ARM\DAYTON\02XSTRC  
TITLE : UPPER FREEPORT STRUCTURE MAP

Rochester & Pittsburgh Coal Co.  
Armstrong County  
Reserve Evaluation  
Project

for the  
DAYTON QUADRANGLE  
Scale 1 inch = 1200 feet November 1991

I MAPS # 18706