


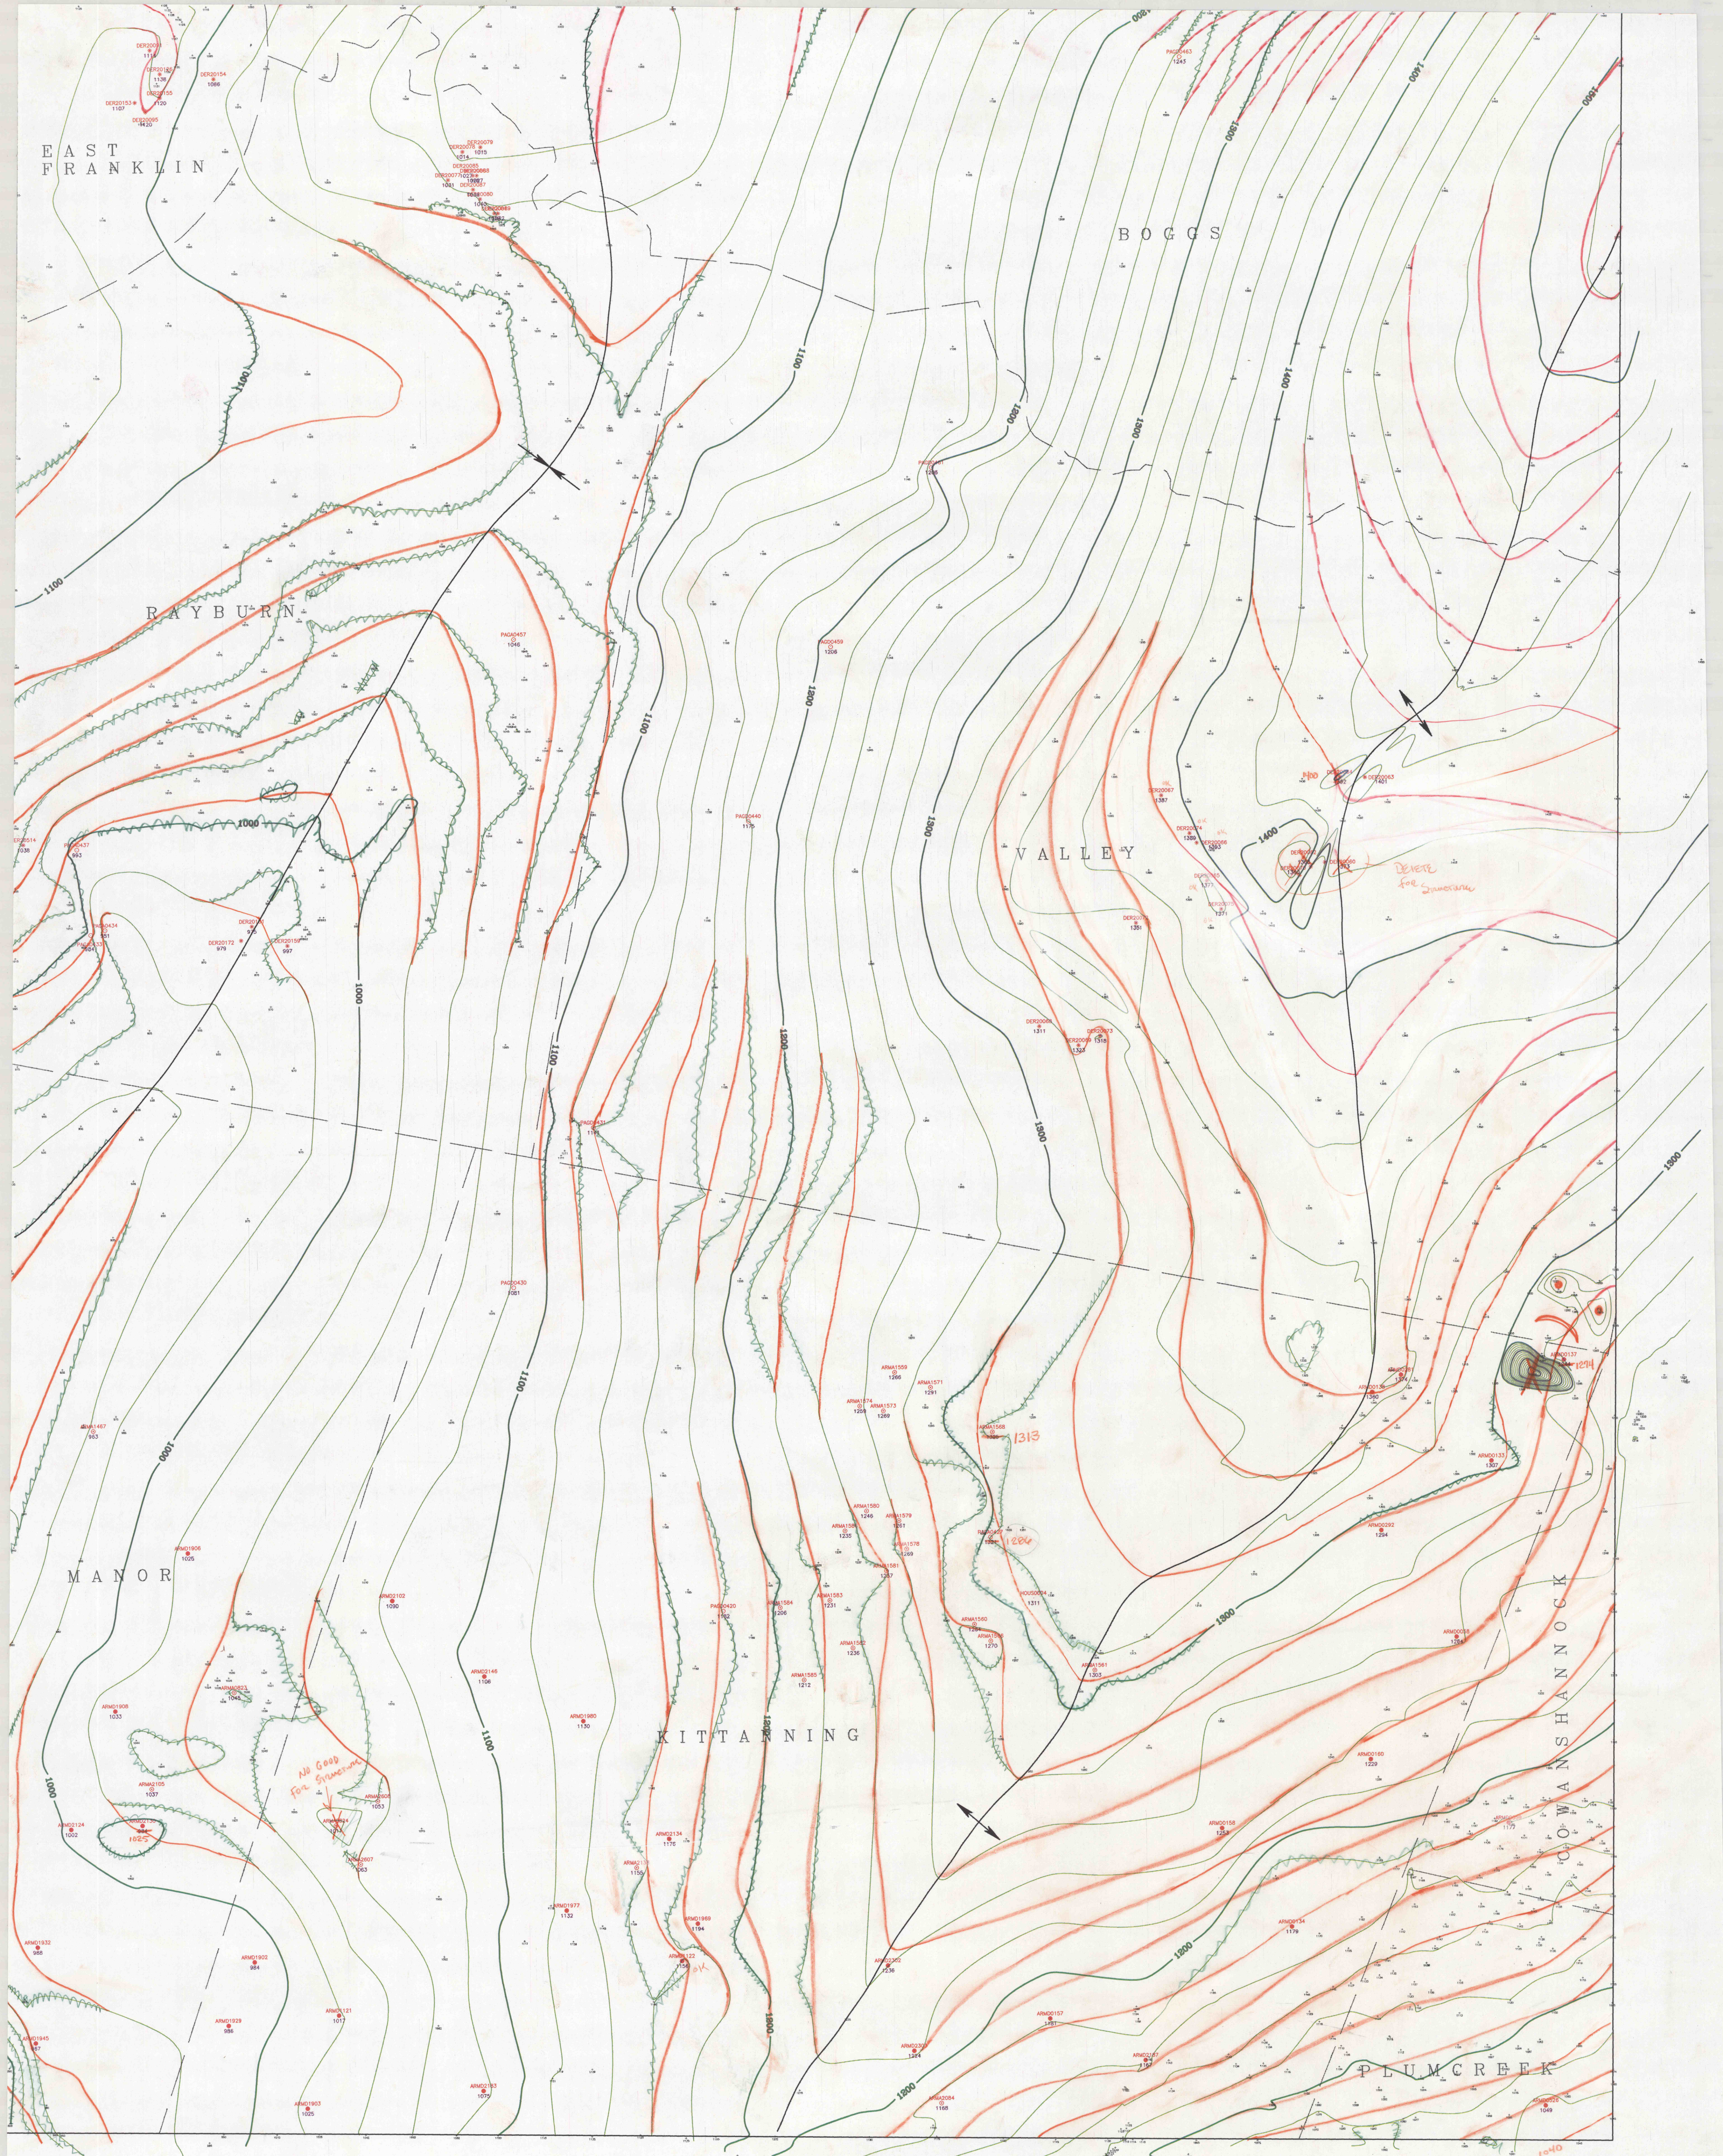

EAST
FRANKLIN

BOGG'S

RAYBURN

VALLEY

MANOR

KITTANNING

COWANSHANNOCK

PLUMCREEK

Rochester & Pittsburgh Coal Co.
Armstrong County
Reserve Evaluation
Project

LOWER FREEPORT STRUCTURE
for the
MOSGROVE QUADRANGLE

Scale 1 inch = 1200 feet

December 1991

GRAPHIC SCALE
1"=1200'
0 1200 2400 3600

DATE : TUE DEC 10 10:56:18 1991
PROJECT : K\ARM\MOSG.NEW

IMAPS#18910