
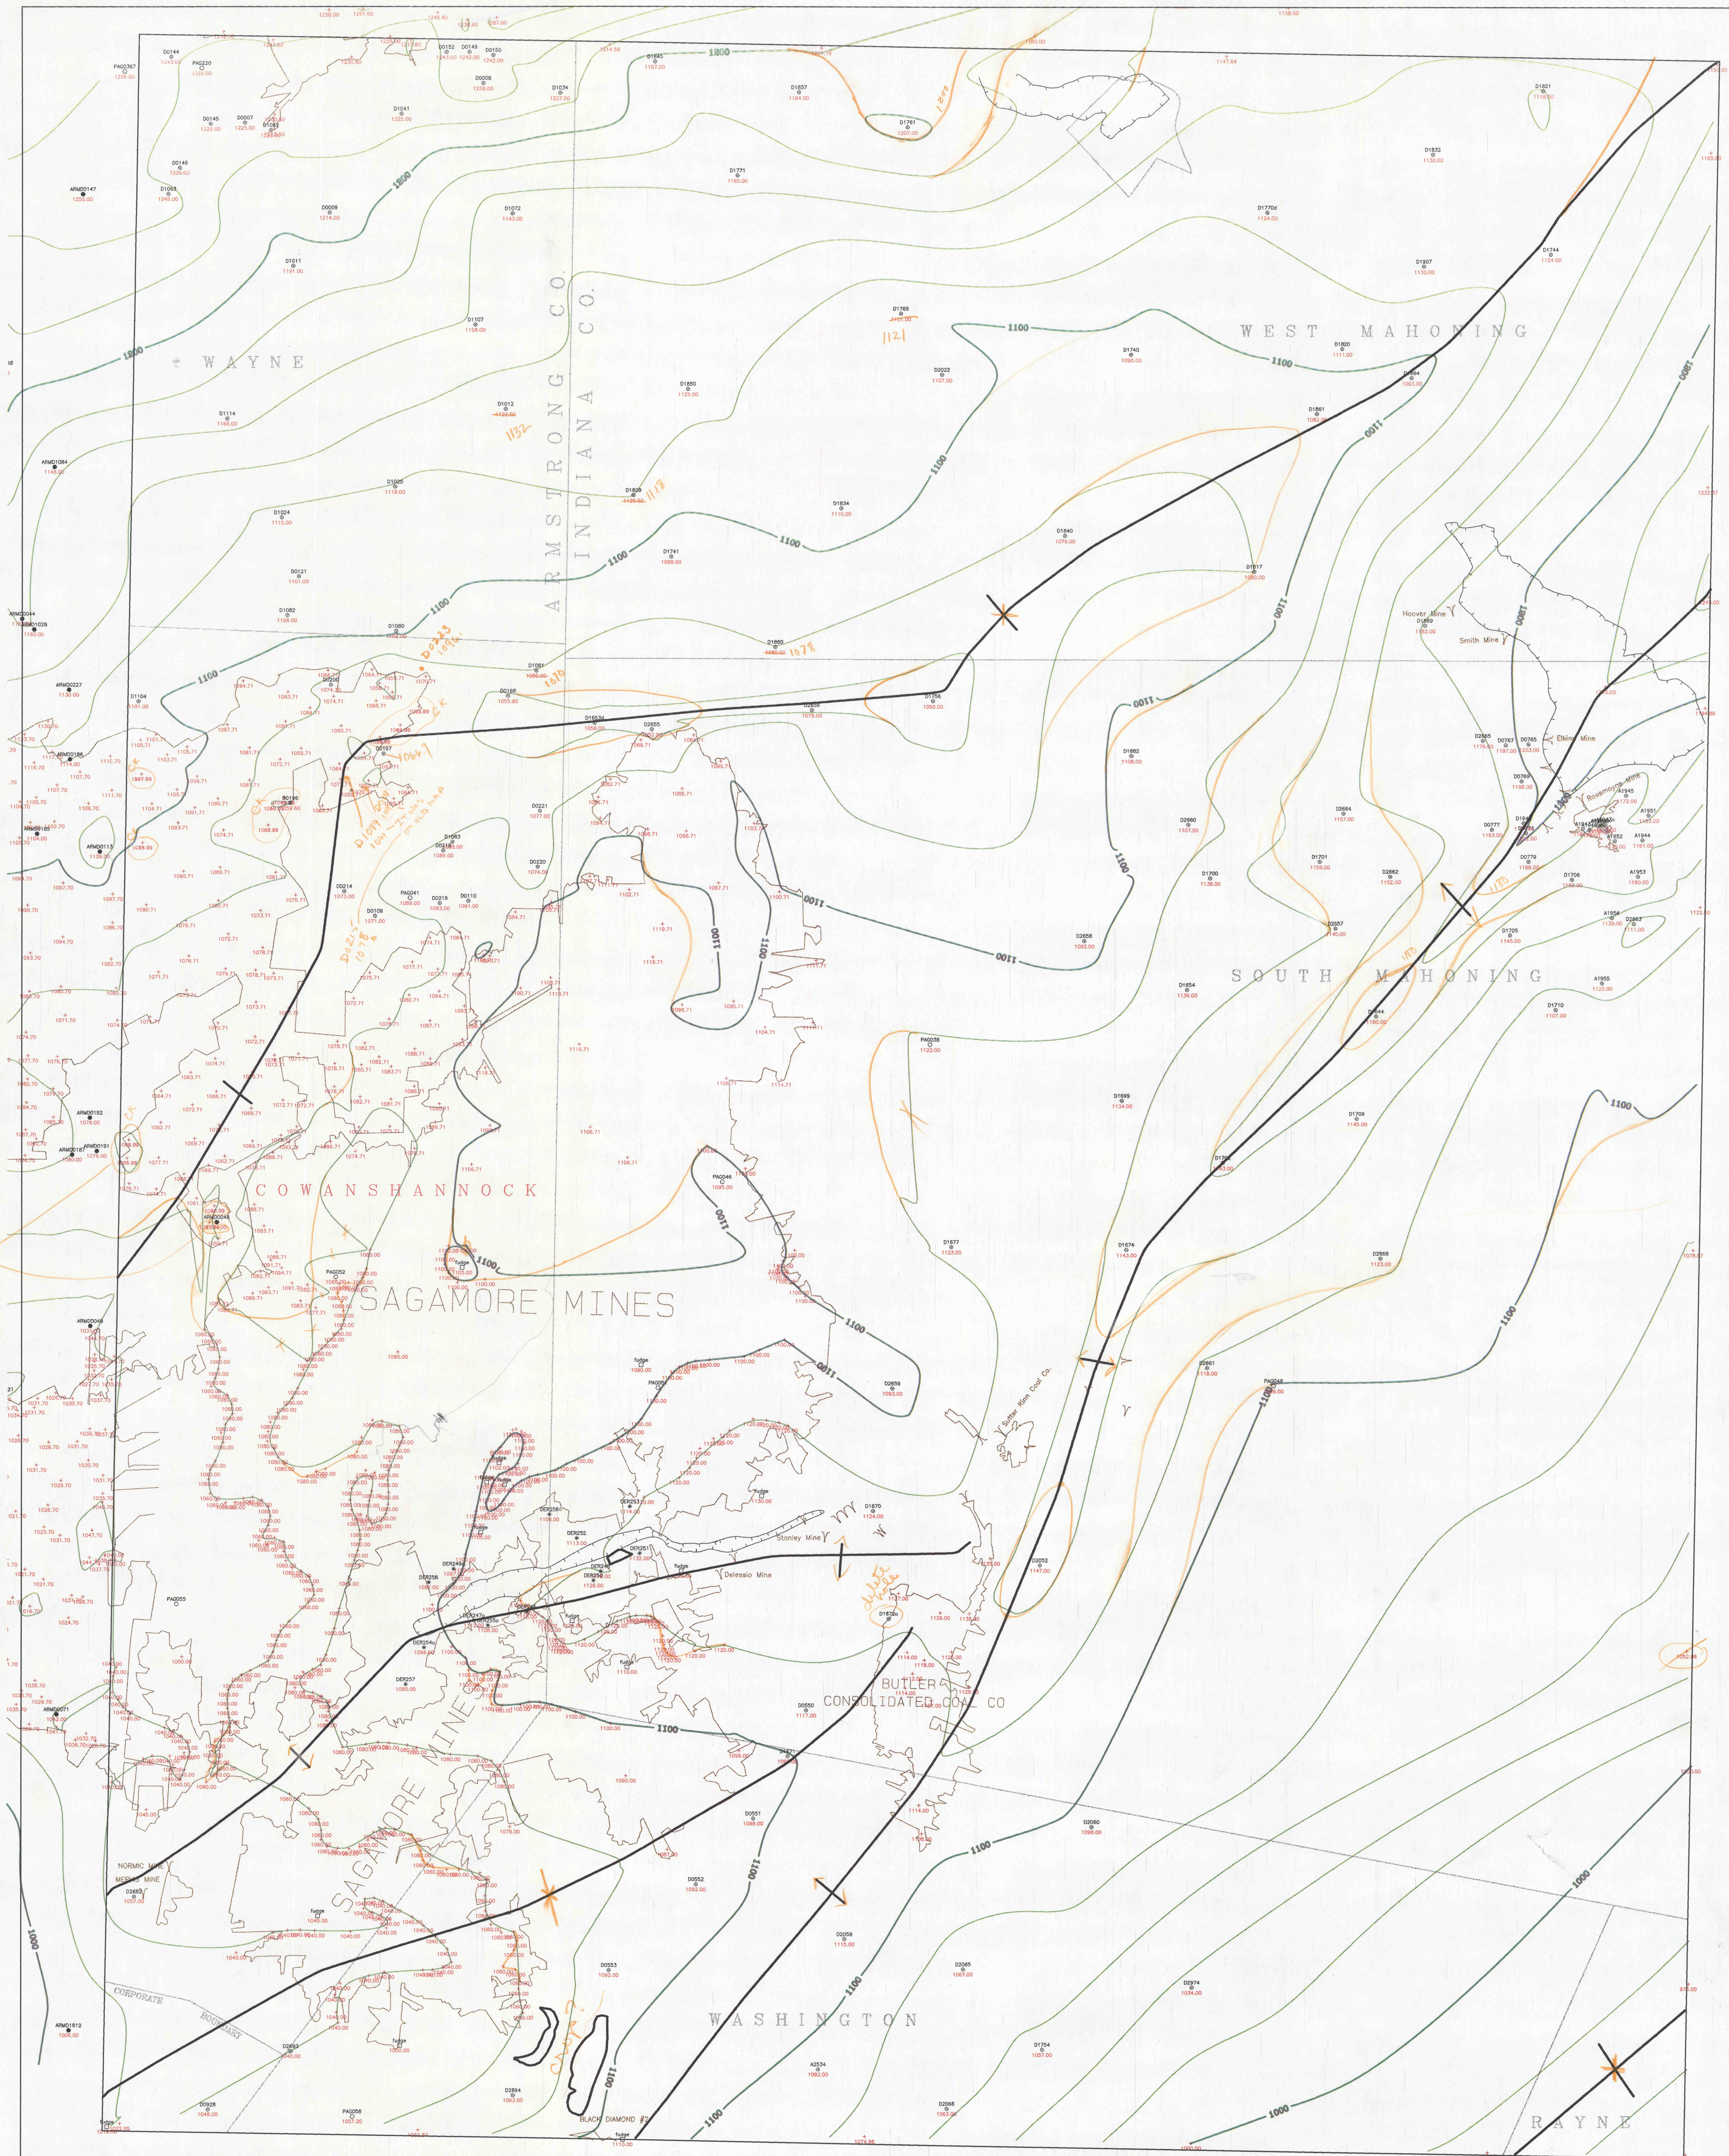


DATE: THU OCT 24 13:14:34 1991
PROJECT: FAARMA PLUMSTRIC
TITLE: UPPER FREEPORT STRUCTURE

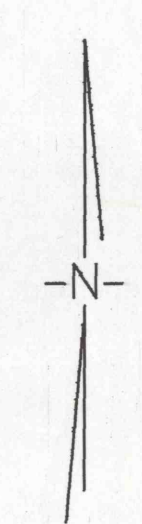

Rochester & Pittsburgh Coal Co.
Armstrong County
Reserve Evaluation
Project

Upper Freeport Structure
for the
PLUMVILLE QUADRANGLE
Scale 1 inch = 1200 feet

IMAPS#18915