


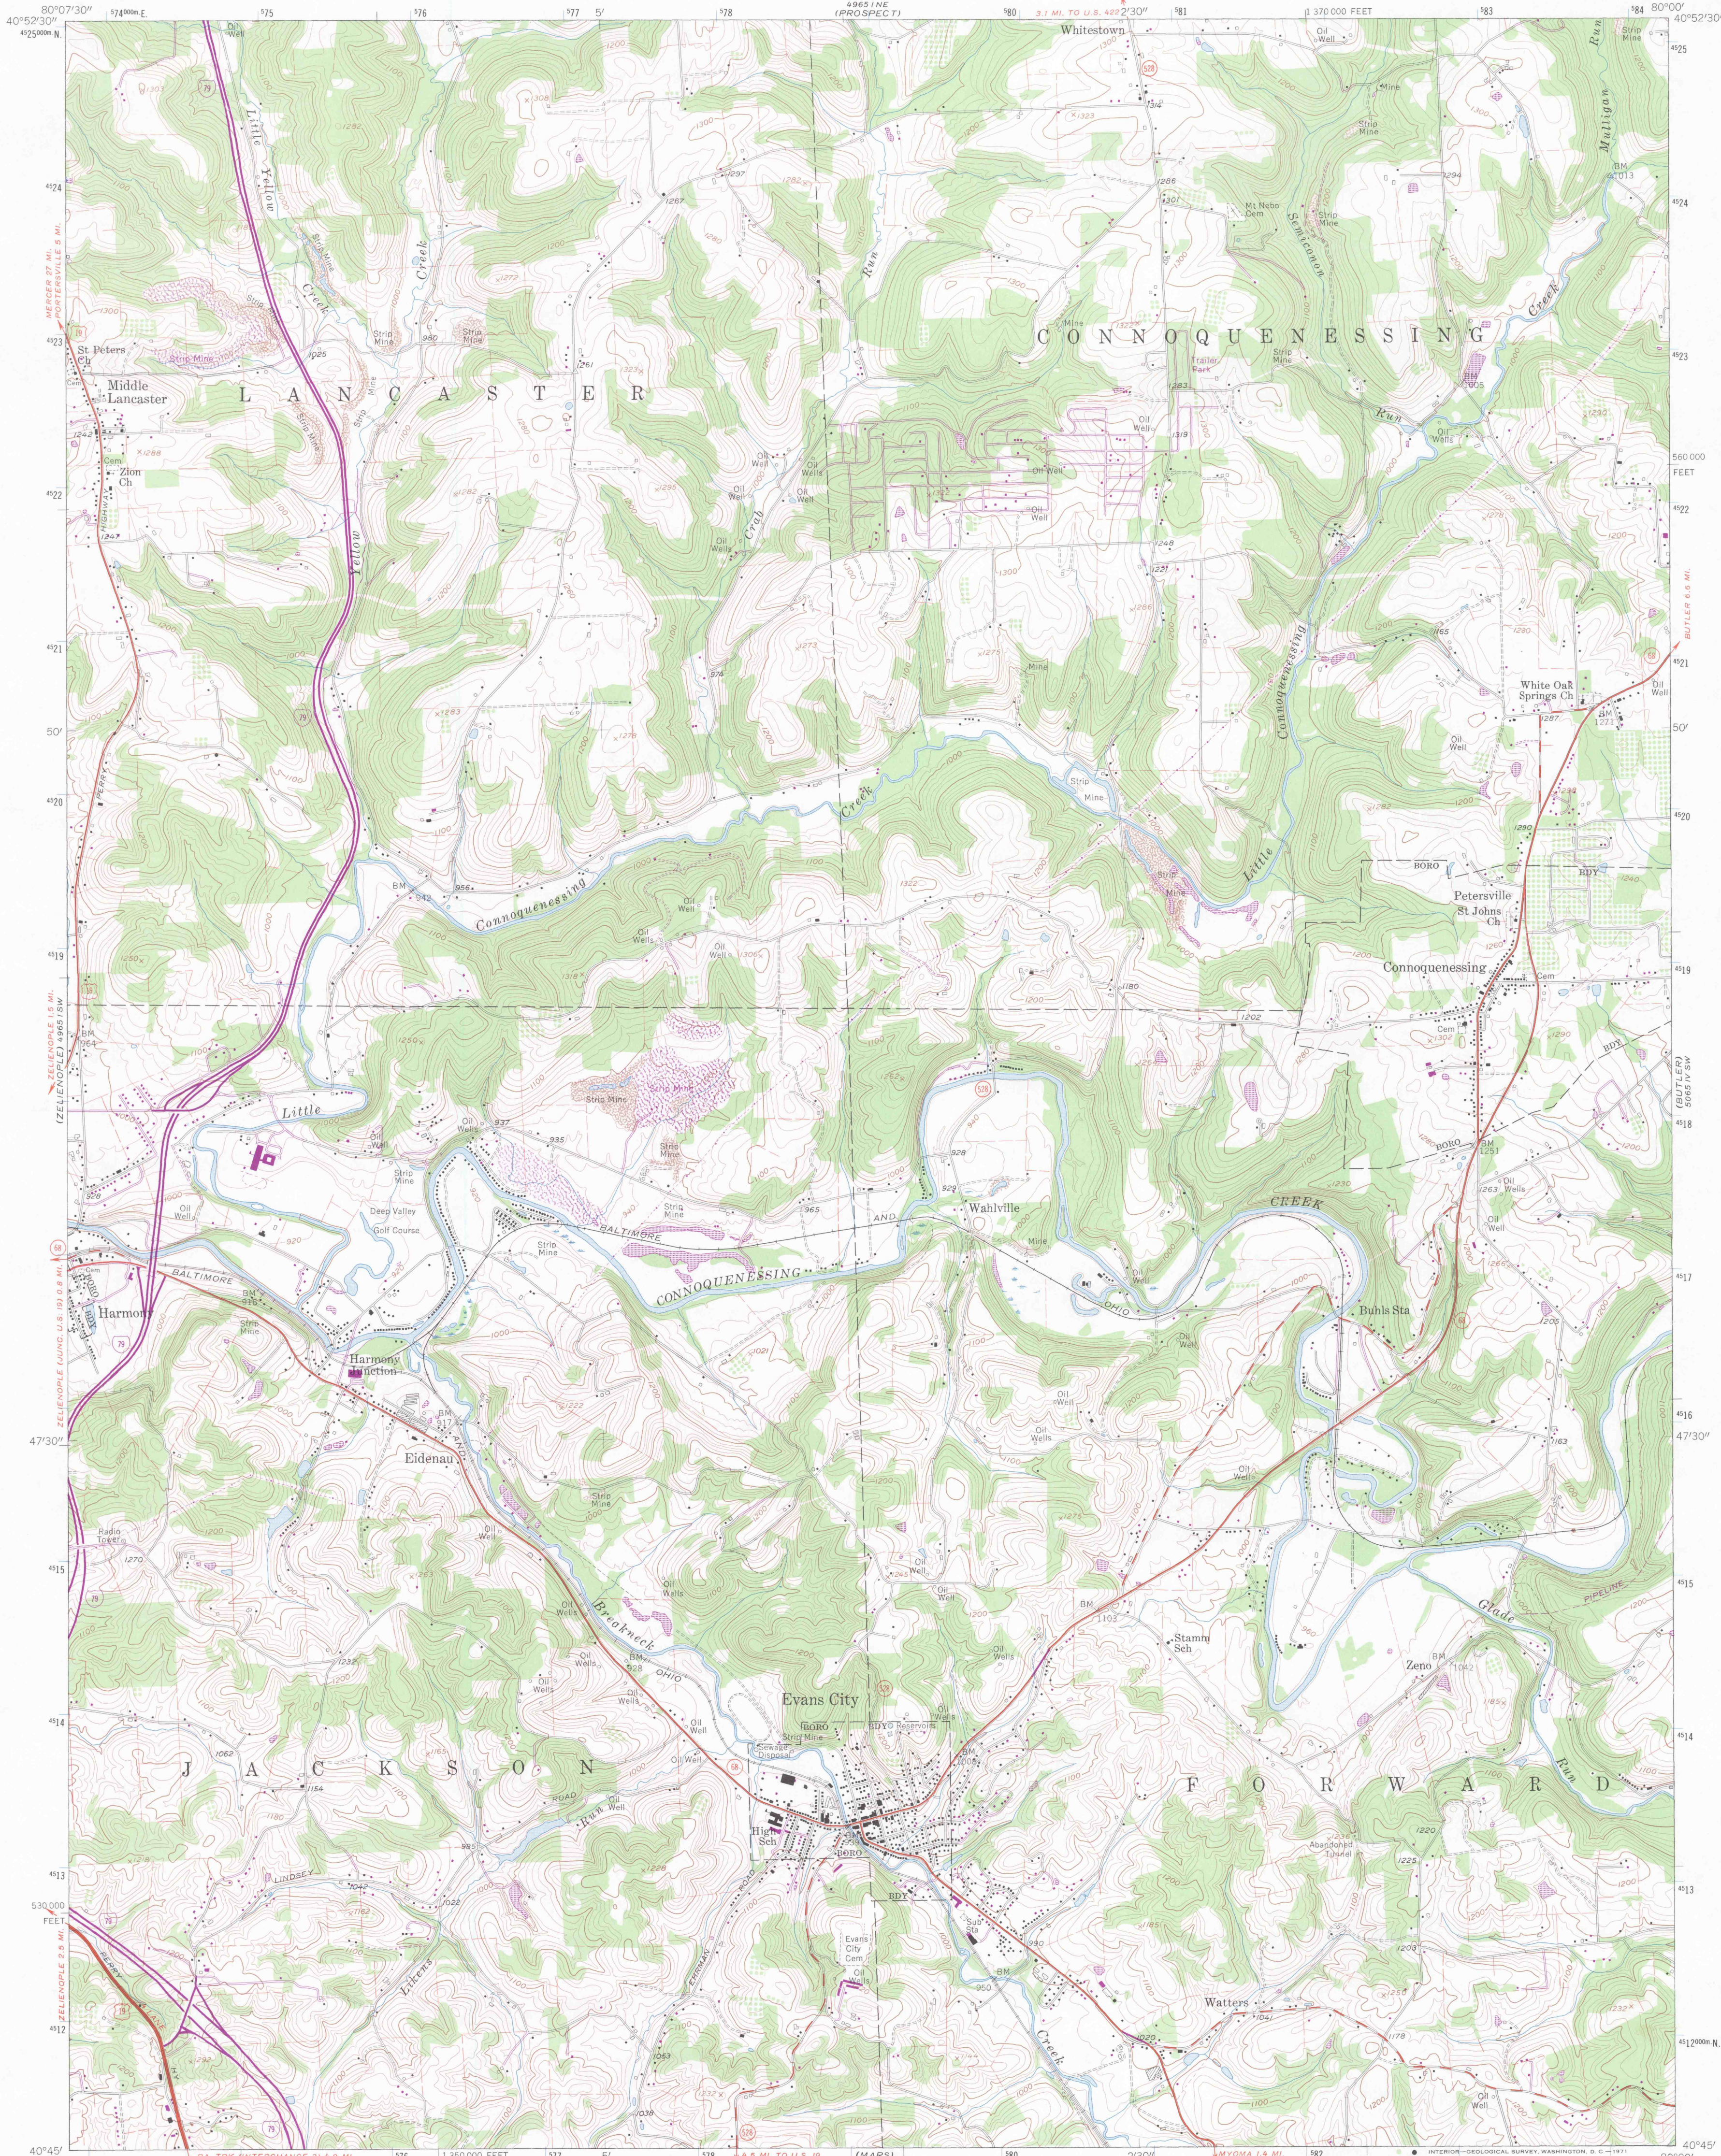

Mapped, edited, and published by the Geological Survey
Control by USGS and USC&GS
Topography from aerial photographs by photogrammetric methods
Aerial photographs taken 1952. Field check 1958
Polyconic projection. 1927 North American datum
10,000-foot grid based on Pennsylvania coordinate system,
south zone
1000-meter Universal Transverse Mercator grid ticks,
zone 17, shown in blue
Fine red dashed lines indicate selected fence and field lines
visible on aerial photographs. This information is unchecked
Unchecked elevations are shown in brown
Contours in strip mine areas compiled from 1952 photography

UTM GRID AND 1969 MAGNETIC NORTH
DECLINATION AT CENTER OF SHEET
Revisions shown in purple compiled in cooperation with
State of Pennsylvania agencies from aerial photographs
taken 1969. This information not field checked

GREEN SHEET
Office Copy
A-03

NOT TO BE TAKEN FROM THE OFFICE

242
REQUEST

ROAD CLASSIFICATION
Heavy-duty ——— Light-duty ———
Medium-duty ——— Unimproved dirt ———
U.S. Route ——— State Route ———
Interstate Route ———

EVANS CITY, PA.
SE 1/4 ZELIENOPLE 15' QUADRANGLE
N 4045—W 8000/7.5
1958
PHOTOREVISED 1969
AMS 4965 I SE—SERIES V831

IMAPS 19014