


UNITED STATES
DEPARTMENT OF THE INTERIOR
GEOLOGICAL SURVEY




FOREST CITY QUADRANGLE
PENNSYLVANIA
7.5 MINUTE SERIES (TOPOGRAPHIC)

5967 V.S.
(LAKE COOK)

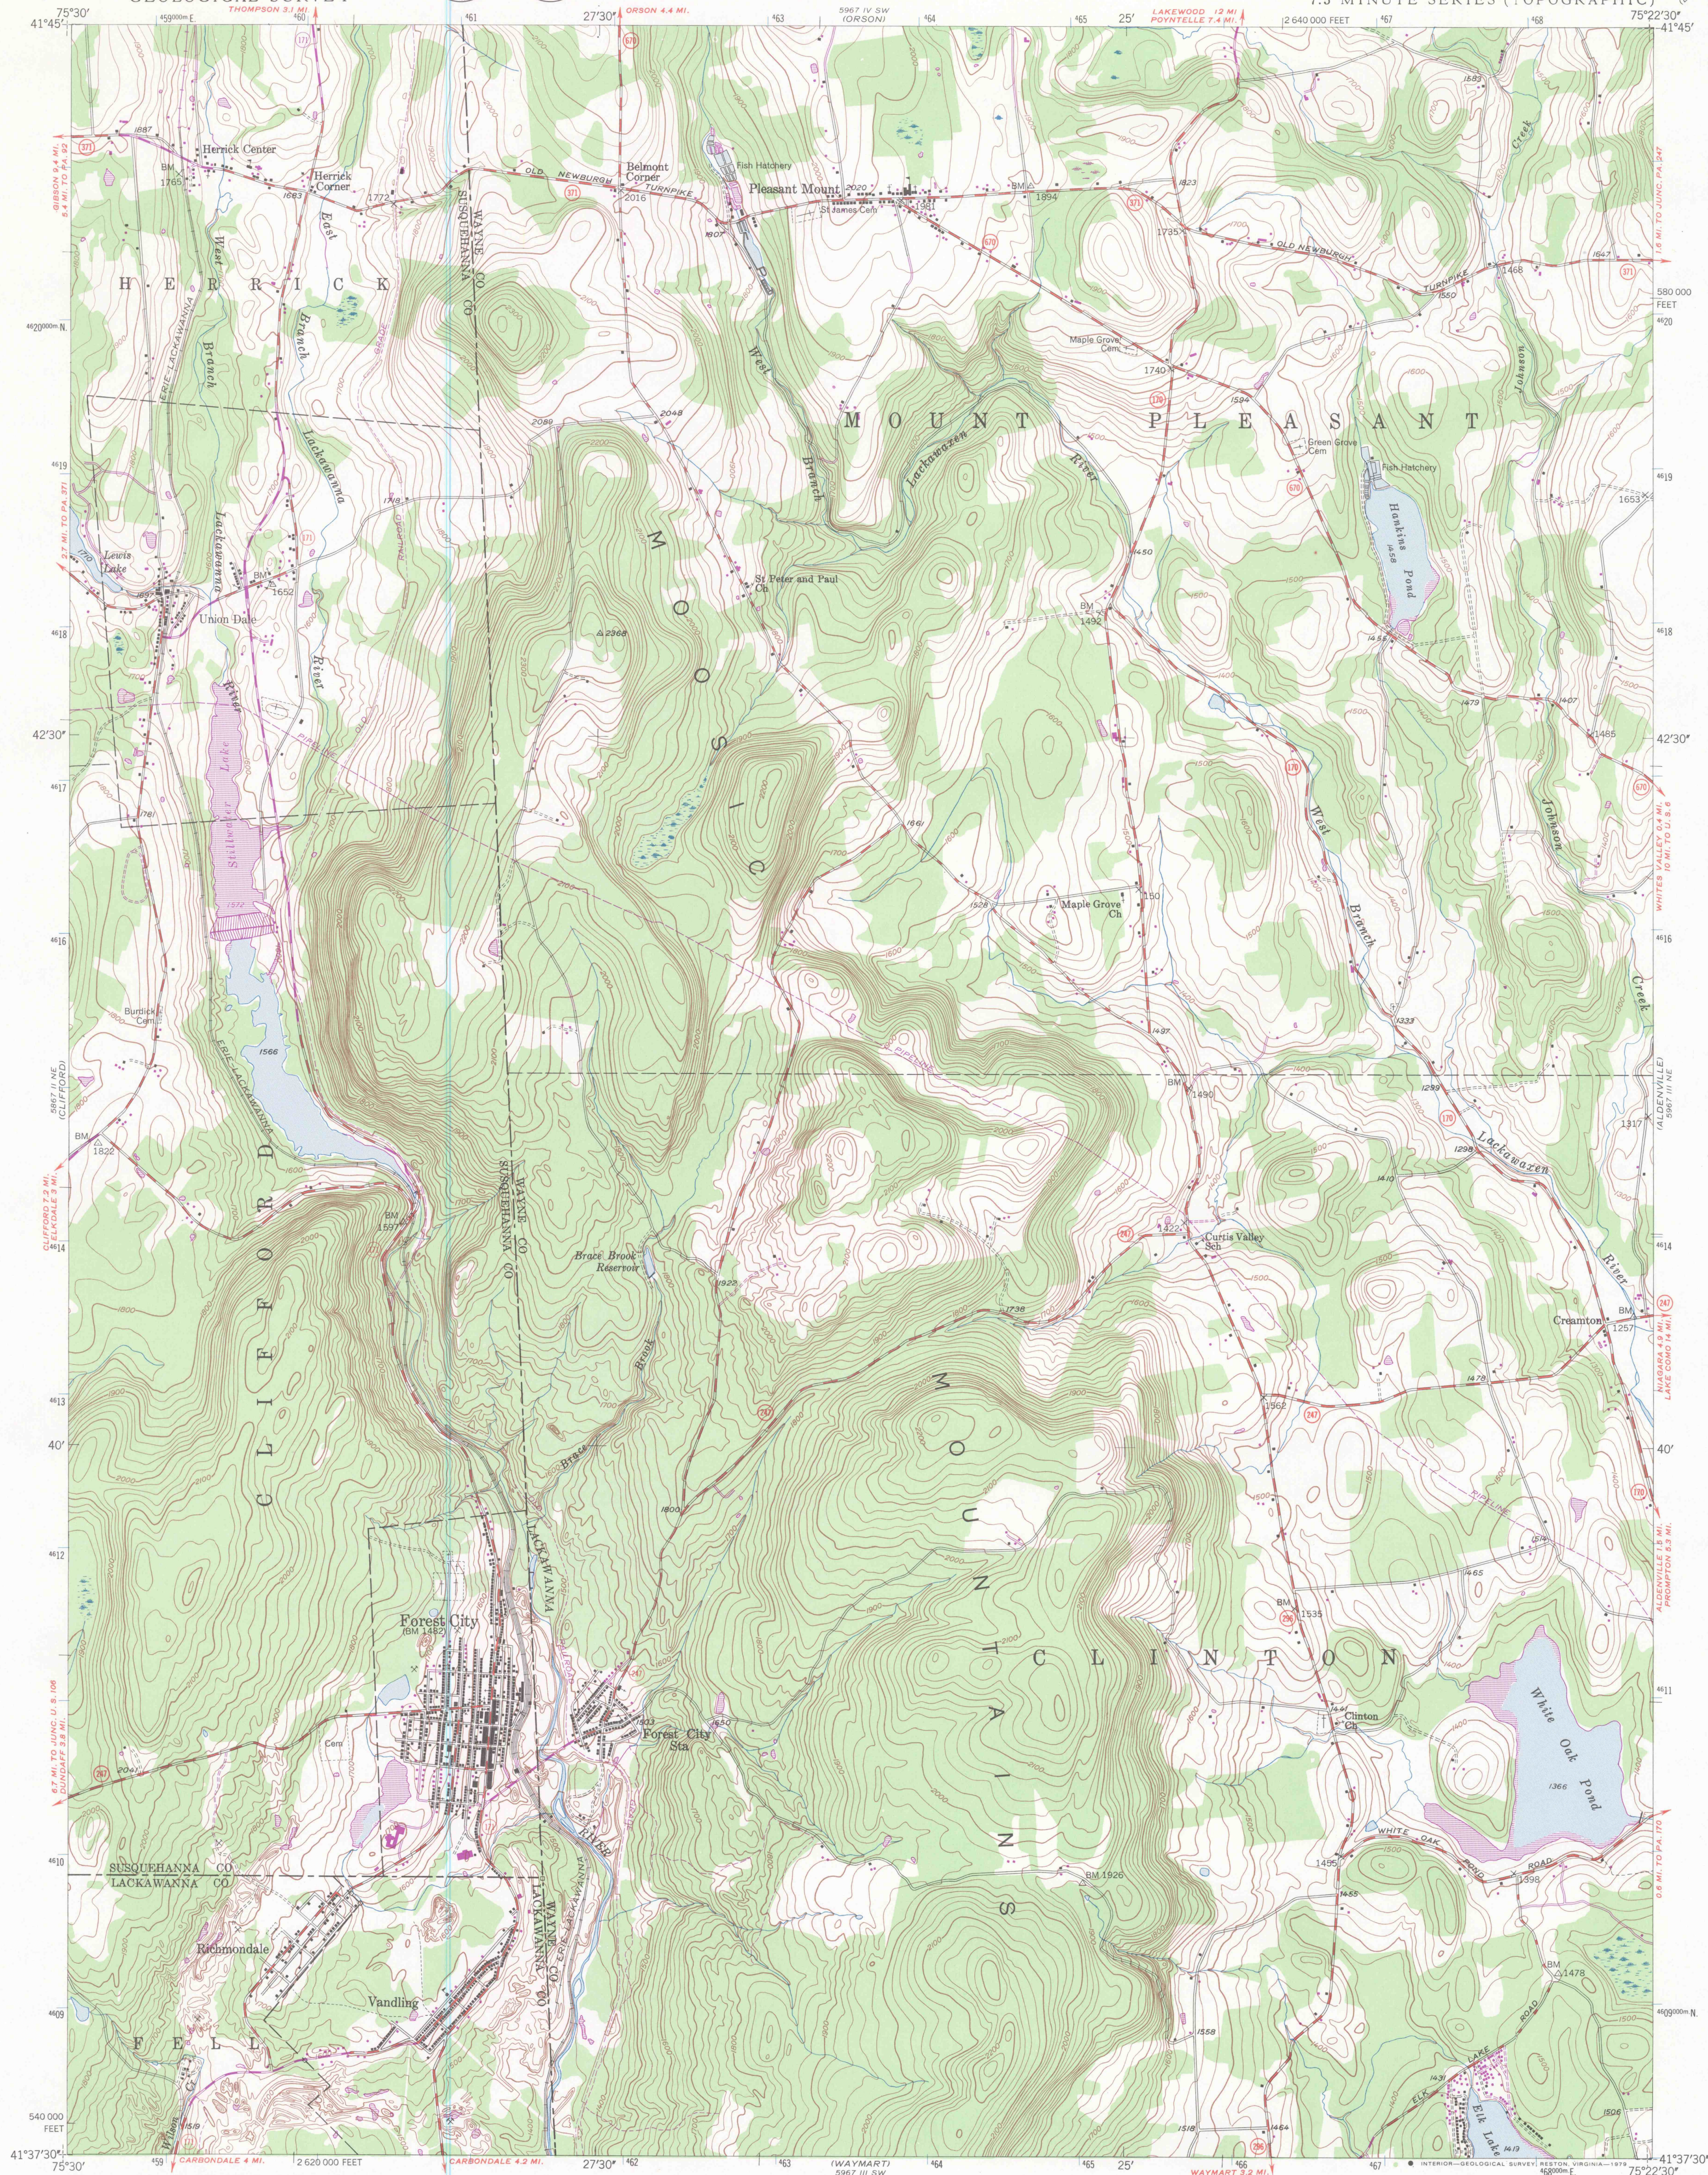

Mapped, edited, and published by the Geological Survey
Control by USGS and USC&GS
Topography from aerial photographs by multiplex methods
Aerial photographs taken 1942. Field check 1946
Polyconic projection. 1927 North American datum
10,000-foot grid based on Pennsylvania coordinate system,
north zone.
Contours in strip mine areas compiled from 1942 photography
1000-meter Universal Transverse Mercator grid ticks,
zone 18, shown in blue.
To place on the predicted North American datum 1983
move the projection lines 5 meters south and
31 meters west as shown by dashed corner ticks

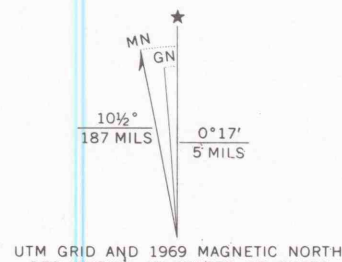

SCALE 1:24,000


GREEN SHEET
Office Copy
A-03

NOT TO BE TAKEN FROM THE OFFICE

A FOLDER FOR EACH QUADRANGLE MAP AND SYMBOLS IS AVAILABLE ON REQUEST

ROAD CLASSIFICATION

HARD-SURFACE ALL WEATHER ROADS
Heavy-duty — 4 LANE LANE
Medium-duty — 4 LANE LANE
Loose-surface, graded, or narrow hard-surface —
U. S. Route
DRY WEATHER ROADS
Improved dirt —
Unimproved dirt —
State Route

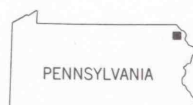

FOREST CITY, PA.
N4137.5—W7522.5/7.5

1946
PHOTOREVISED 1969
AMS 5967 III NW—SERIES V831

Revisions shown in purple compiled in cooperation with
State of Pennsylvania agencies, from aerial photographs
taken 1969. This information not field checked
Stillwater Lake is subject to inundation to 1621 feet

IMAPS#19020