


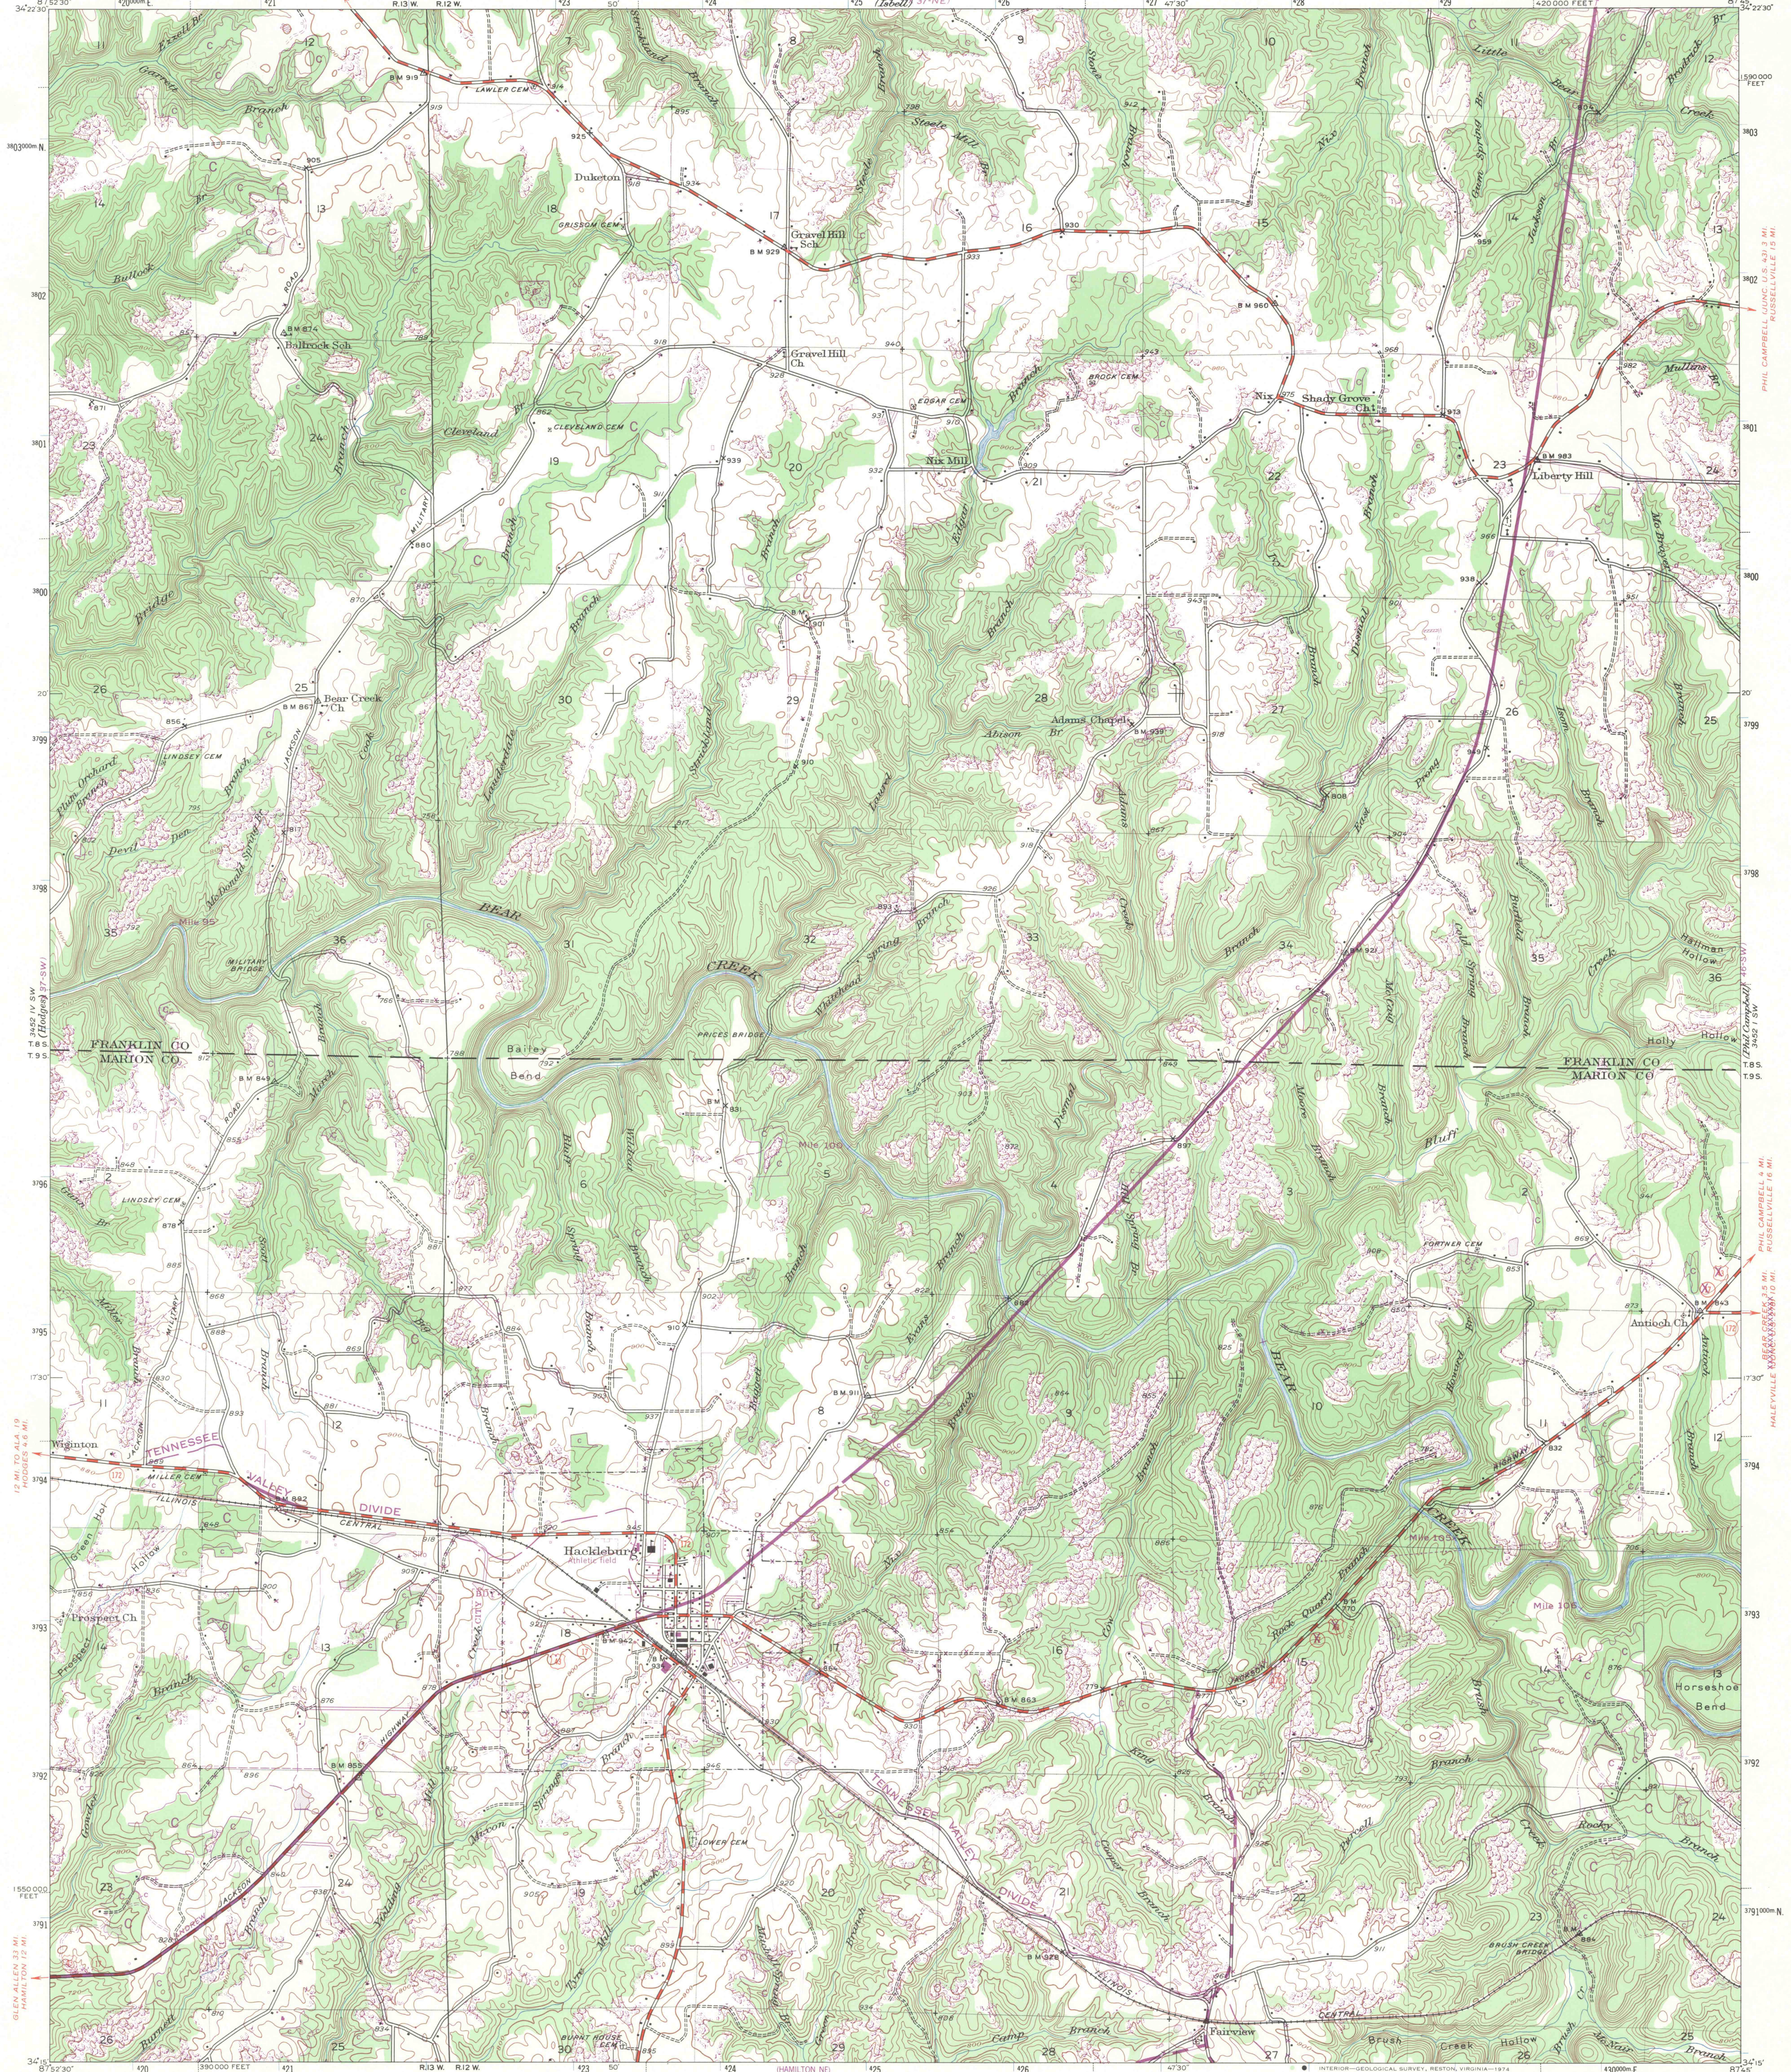

ROAD CLASSIFICATION
Medium-duty ——— Light-duty ———
Unimproved dirt ———
U. S. Route ——— State Route ———

Revisions in purple compiled by TVA, December 1967 from April 1967 photography without field examination

UTM GRID AND 1946 MAGNETIC NORTH DECLINATION AT CENTER OF SHEET
1967
0° 27' 30" N
8° 15' 00" W
Larger scale topographic maps available from TVA

SCALE 1:24,000
1 1000 0 1000 2000 3000 4000 5000 6000 7000 FEET
1 KILOMETER
CONTOUR INTERVAL 20 FEET
DATUM IS MEAN SEA LEVEL

FOR SALE BY U. S. GEOLOGICAL SURVEY, RESTON, VIRGINIA 22092
A FOLDER DESCRIBING TOPOGRAPHIC MAPS AND SYMBOLS IS AVAILABLE ON REQUEST
U. S. TENNESSEE VALLEY AUTHORITY, CHATTANOOGA, TENN. 37401 OR KNOXVILLE, TENN. 37902.

Revisions overprinted by TVA April 1969
LEGEND
Fence and field line ———
Stream ———
Pond and dam ———
Woodland (formerly clearing) ———
Clearing (formerly woodland) ———
Orchard ———
General deletion ———
Heavy-duty road ———
Wagon and jeep track ———
Foot trail ———

QUADRANGLE LOCATION
MISS. ALA. GA. S.C.
KENTUCKY
TENNESSEE
N.C.
VA.

HACKLEBURG, ALA.
N3415-W8745/7.5
1946
AMS 3452 IV SE-SERIES V844