




Mapped, edited, and published by the Geological Survey
Control by USGS

Topography from aerial photographs by multiplex methods
Aerial photographs taken 1944 Field check, 1946

Polyconic projection. 1927 North American datum
10 000-foot grid based on Pennsylvania coordinate system,
North zone
1000-meter Universal Transverse Mercator grid ticks, zone 18,
shown in blue

Area below elevation 937 is subject to controlled
inundation by Alvin R. Bush Dam

Revisions shown in purple compiled in cooperation with State of
Pennsylvania agencies from aerial photographs taken 1971. This
information not field checked

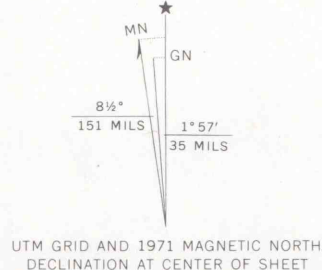


SCALE 1:24 000
0 1000 2000 3000 4000 5000 6000 7000 FEET
1 MILE
LOMETER

GREEN SHEET
Office Copy

A-04

NOT TO BE TAKEN FROM THE OFFICE

ROAD CLASSIFICATION
HARD-SURFACE ALL WEATHER ROADS DRY WEATHER ROADS
Heavy-duty... Improved dirt...
Medium-duty... Unimproved dirt...
Loose-surface, graded, or narrow hard-surface
State Route

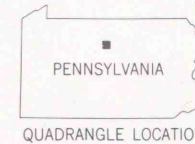

IMAPS 1914 HAMMERSLEY FORK, PA.
NW/4 RENOV WEST 15' QUADRANGLE
N4122.5-W7752.5/7.5

1946
PHOTOREVISED 1971
AMS 5466 IV NW-SERIES V831