



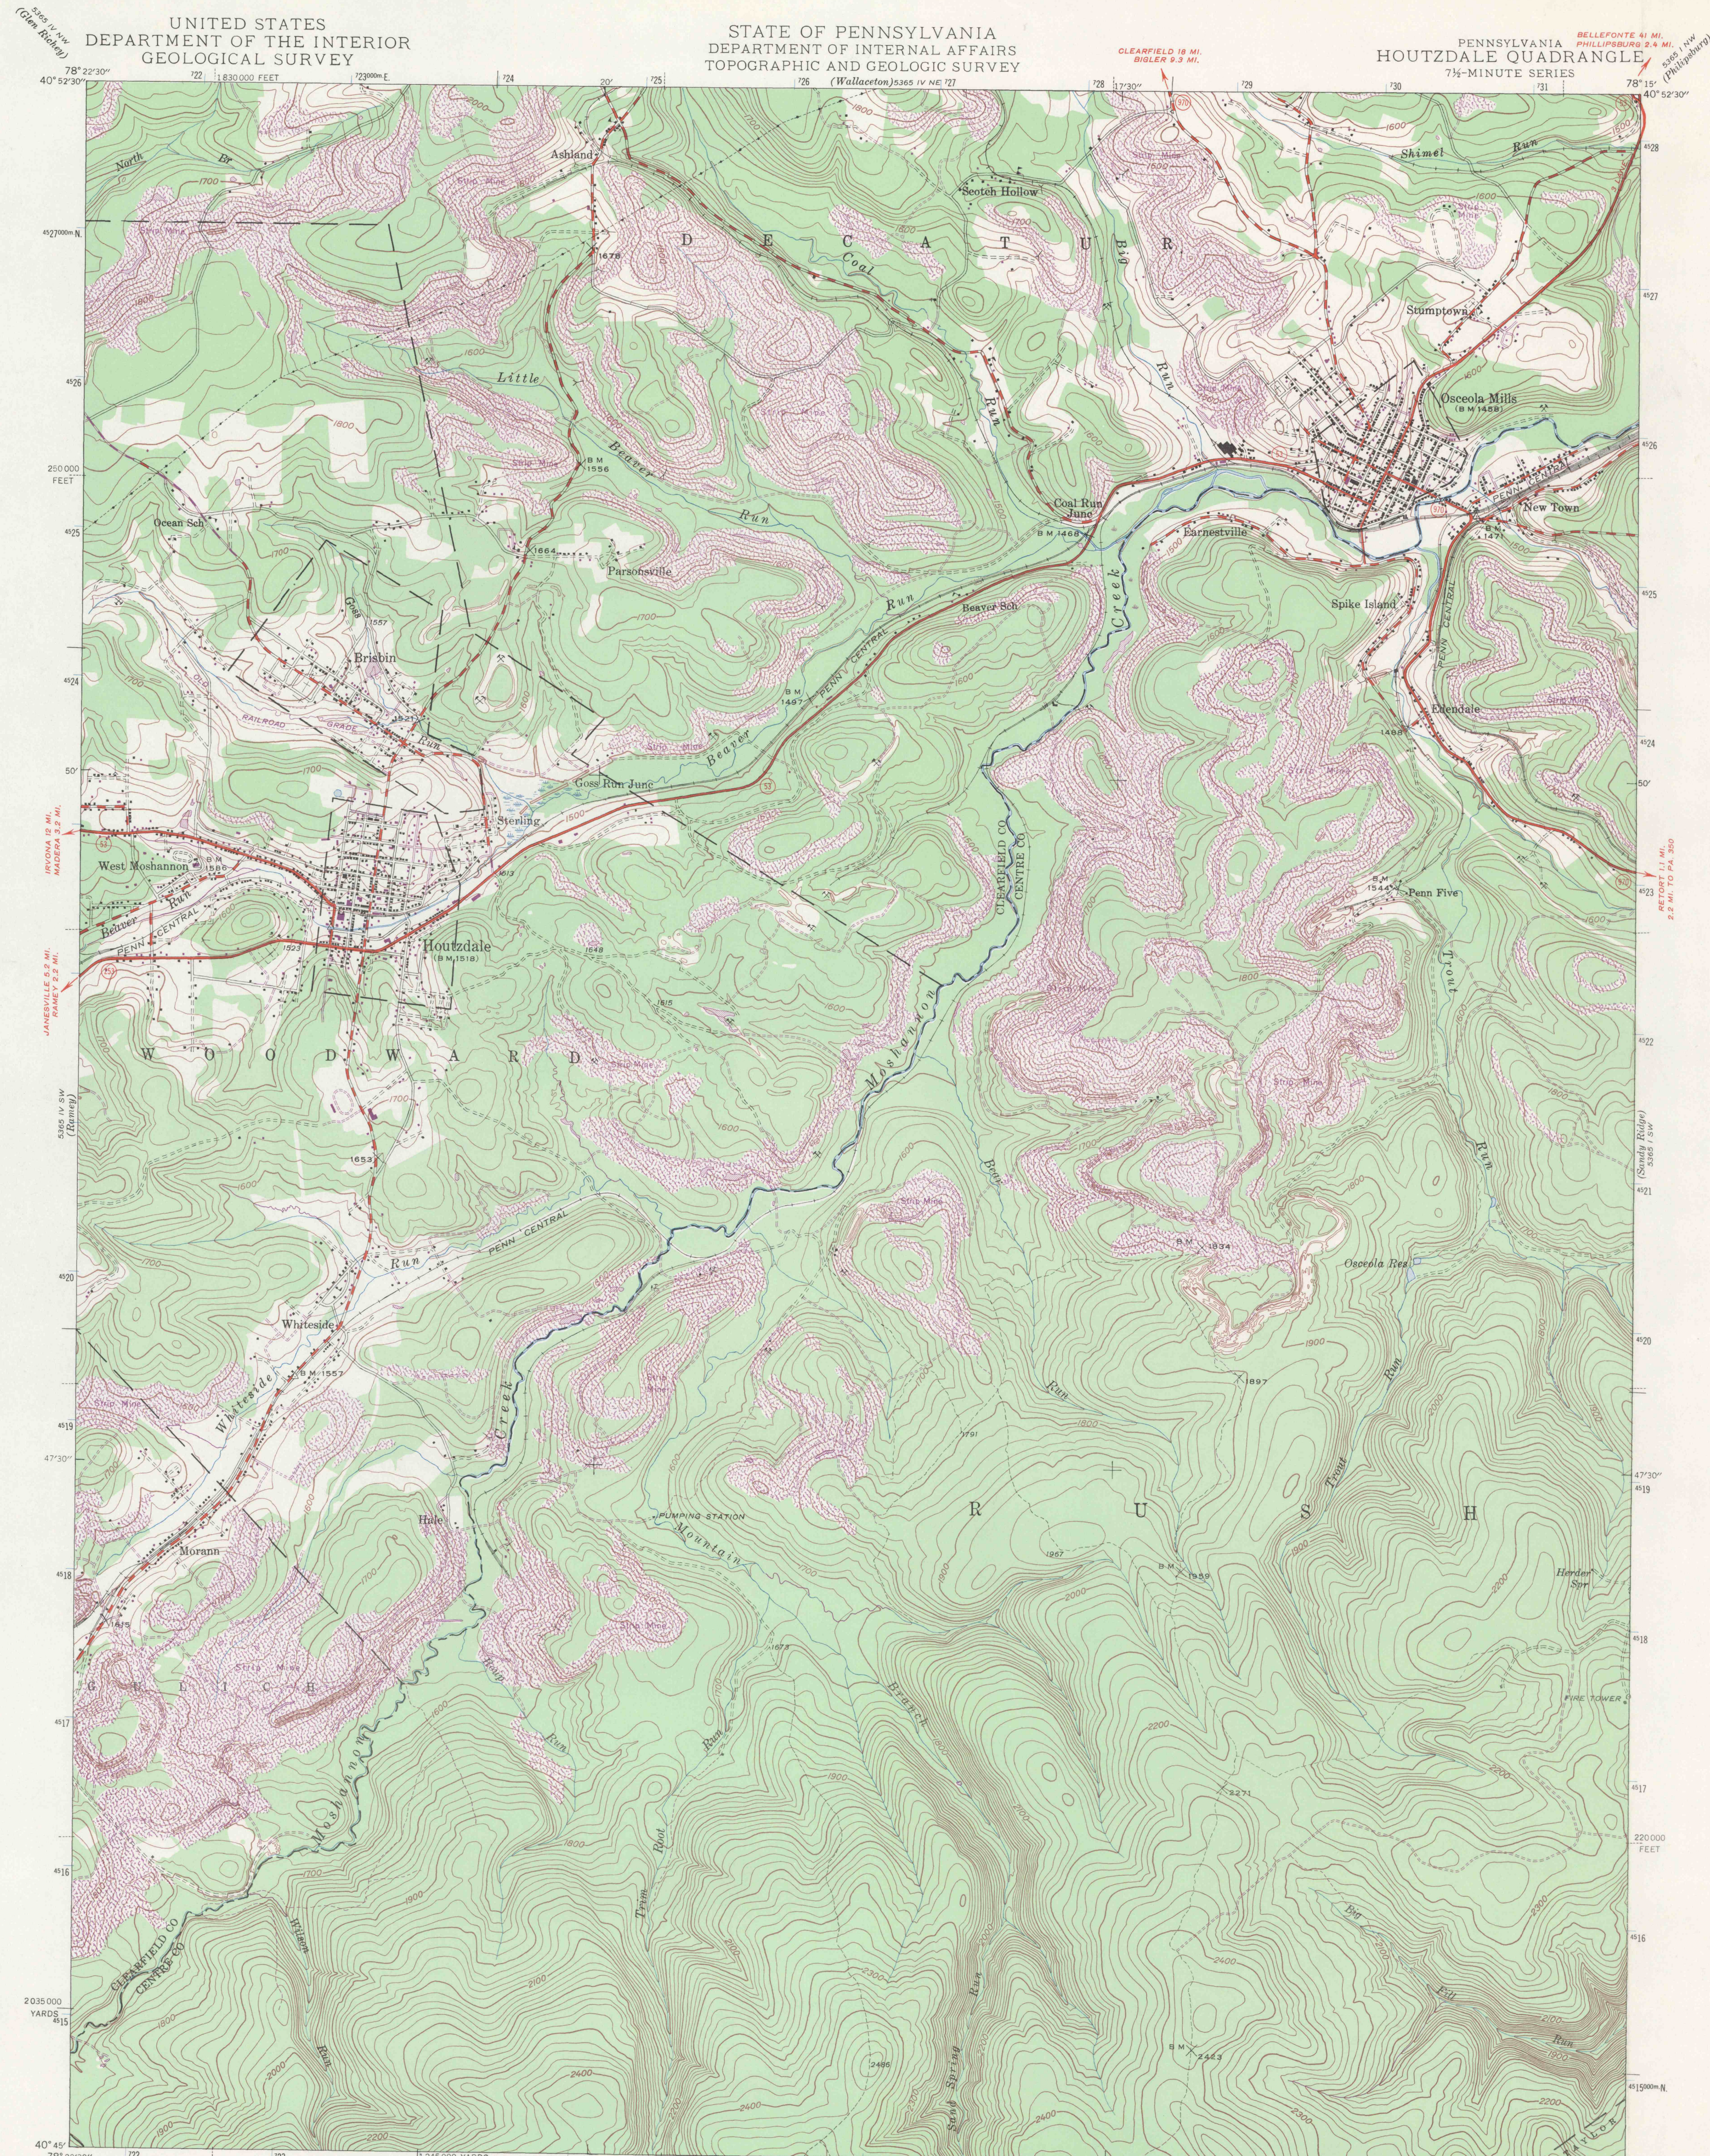

Map by the Geological Survey
1944

Revisions shown in purple compiled in cooperation with
state of Pennsylvania agencies from aerial photographs
taken 1969. This information not field checked

IMAPS 19059

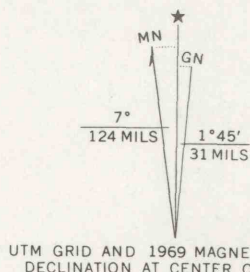


SCALE 1:24,000
1 1000 0 1 MILE

GREEN SHEET
Office Copy

A-03

NOT TO BE TAKEN FROM OFFICE

Polyconic projection, 1927 North American datum
5000 yard grid based on U. S. zone system, B
10000 foot grid based on Pennsylvania (North)
rectangular coordinate system
1000-meter Universal Transverse Mercator grid ticks,
zone 17, shown in blue

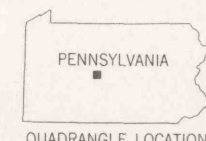

ROAD CLASSIFICATION
Heavy-duty 4 LANE 6 LANE Light-duty
Medium-duty 4 LANE 6 LANE Unimproved dirt
U. S. Route State Route

HOUTZDALE, PA.

N4045-W7815/7.5

1944
AMS 5365 IV SE-SERIES V831