

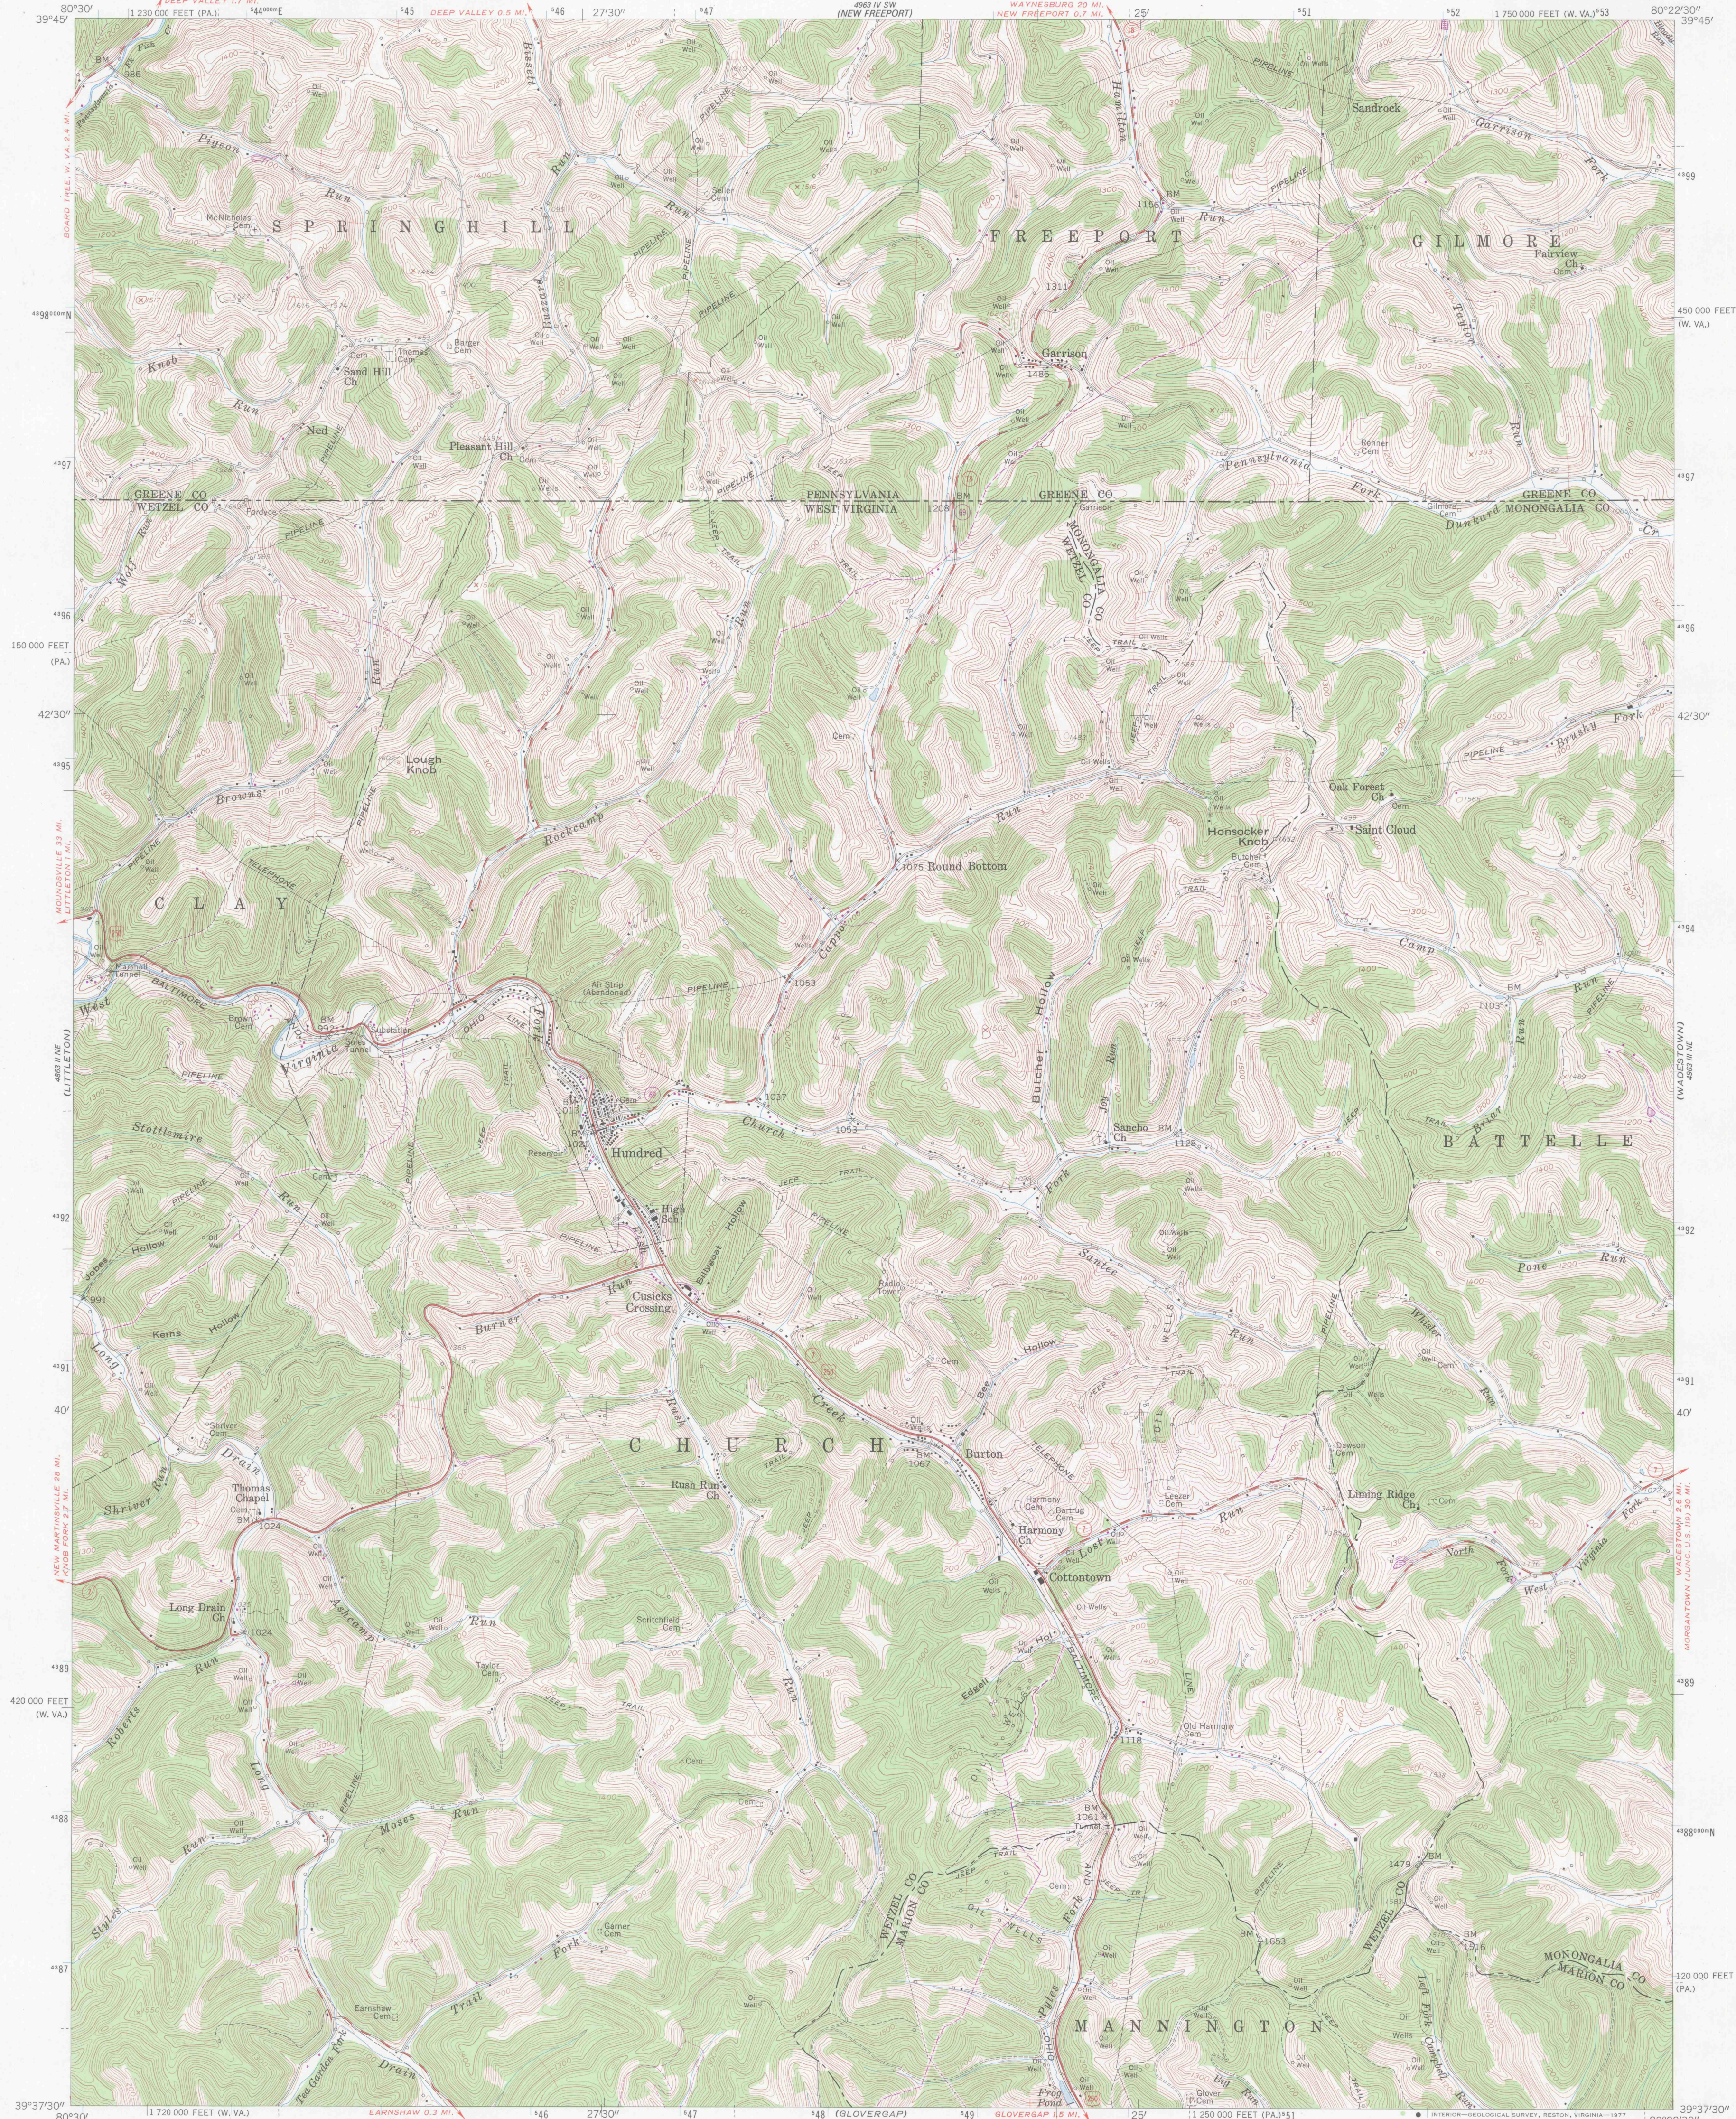


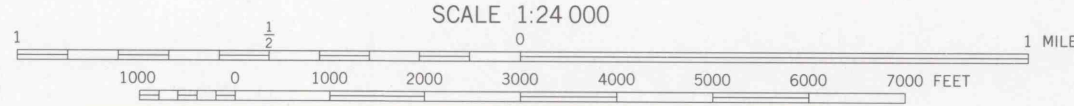

Mapped, edited, and published by the Geological Survey
Control by USGS and USCGS
Topography from aerial photographs by photogrammetric methods
Aerial photographs taken 1956. Field check 1958
Polyconic projection, 1927 North American datum
10,000-foot grids based on West Virginia coordinate system,
north zone, and Pennsylvania coordinate system, south zone
1000-meter Universal Transverse Mercator grid ticks,
zone 17, shown in blue
Fine red dashed lines indicate selected fence and field lines
visible on aerial photographs. This information is unchecked
Unlabelled wells are gas wells
Unchecked elevations are shown in brown

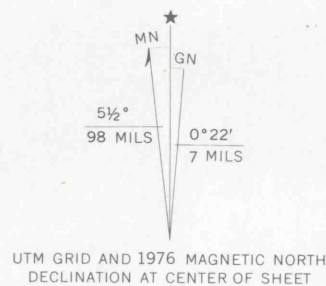

GREEN SHEET
Office Copy

H-07
THIS MAP COMPILED FROM AERIAL PHOTOGRAPHS TAKEN 1976.
FOR SALE BY U.S. GEOLOGICAL SURVEY, RESTON, VIRGINIA 20192
A FOLDER DESCRIBING TOPOGRAPHIC MAPS AND SYMBOLS IS AVAILABLE ON REQUEST
NOT TO BE TAKEN FROM THE OFFICE

IMAPS 19061



ROAD CLASSIFICATION
Heavy-duty ——— Light-duty ———
Medium-duty ——— Unimproved dirt ———
U.S. Route ——— State Route ———

HUNDRED, W. VA.—PA.
NW/4 MANNINGTON 15' QUADRANGLE
N 3937.5—W 8022.5/7.5

1958
PHOTOREVISED 1976
AMS 4963 III NW—SERIES V854