









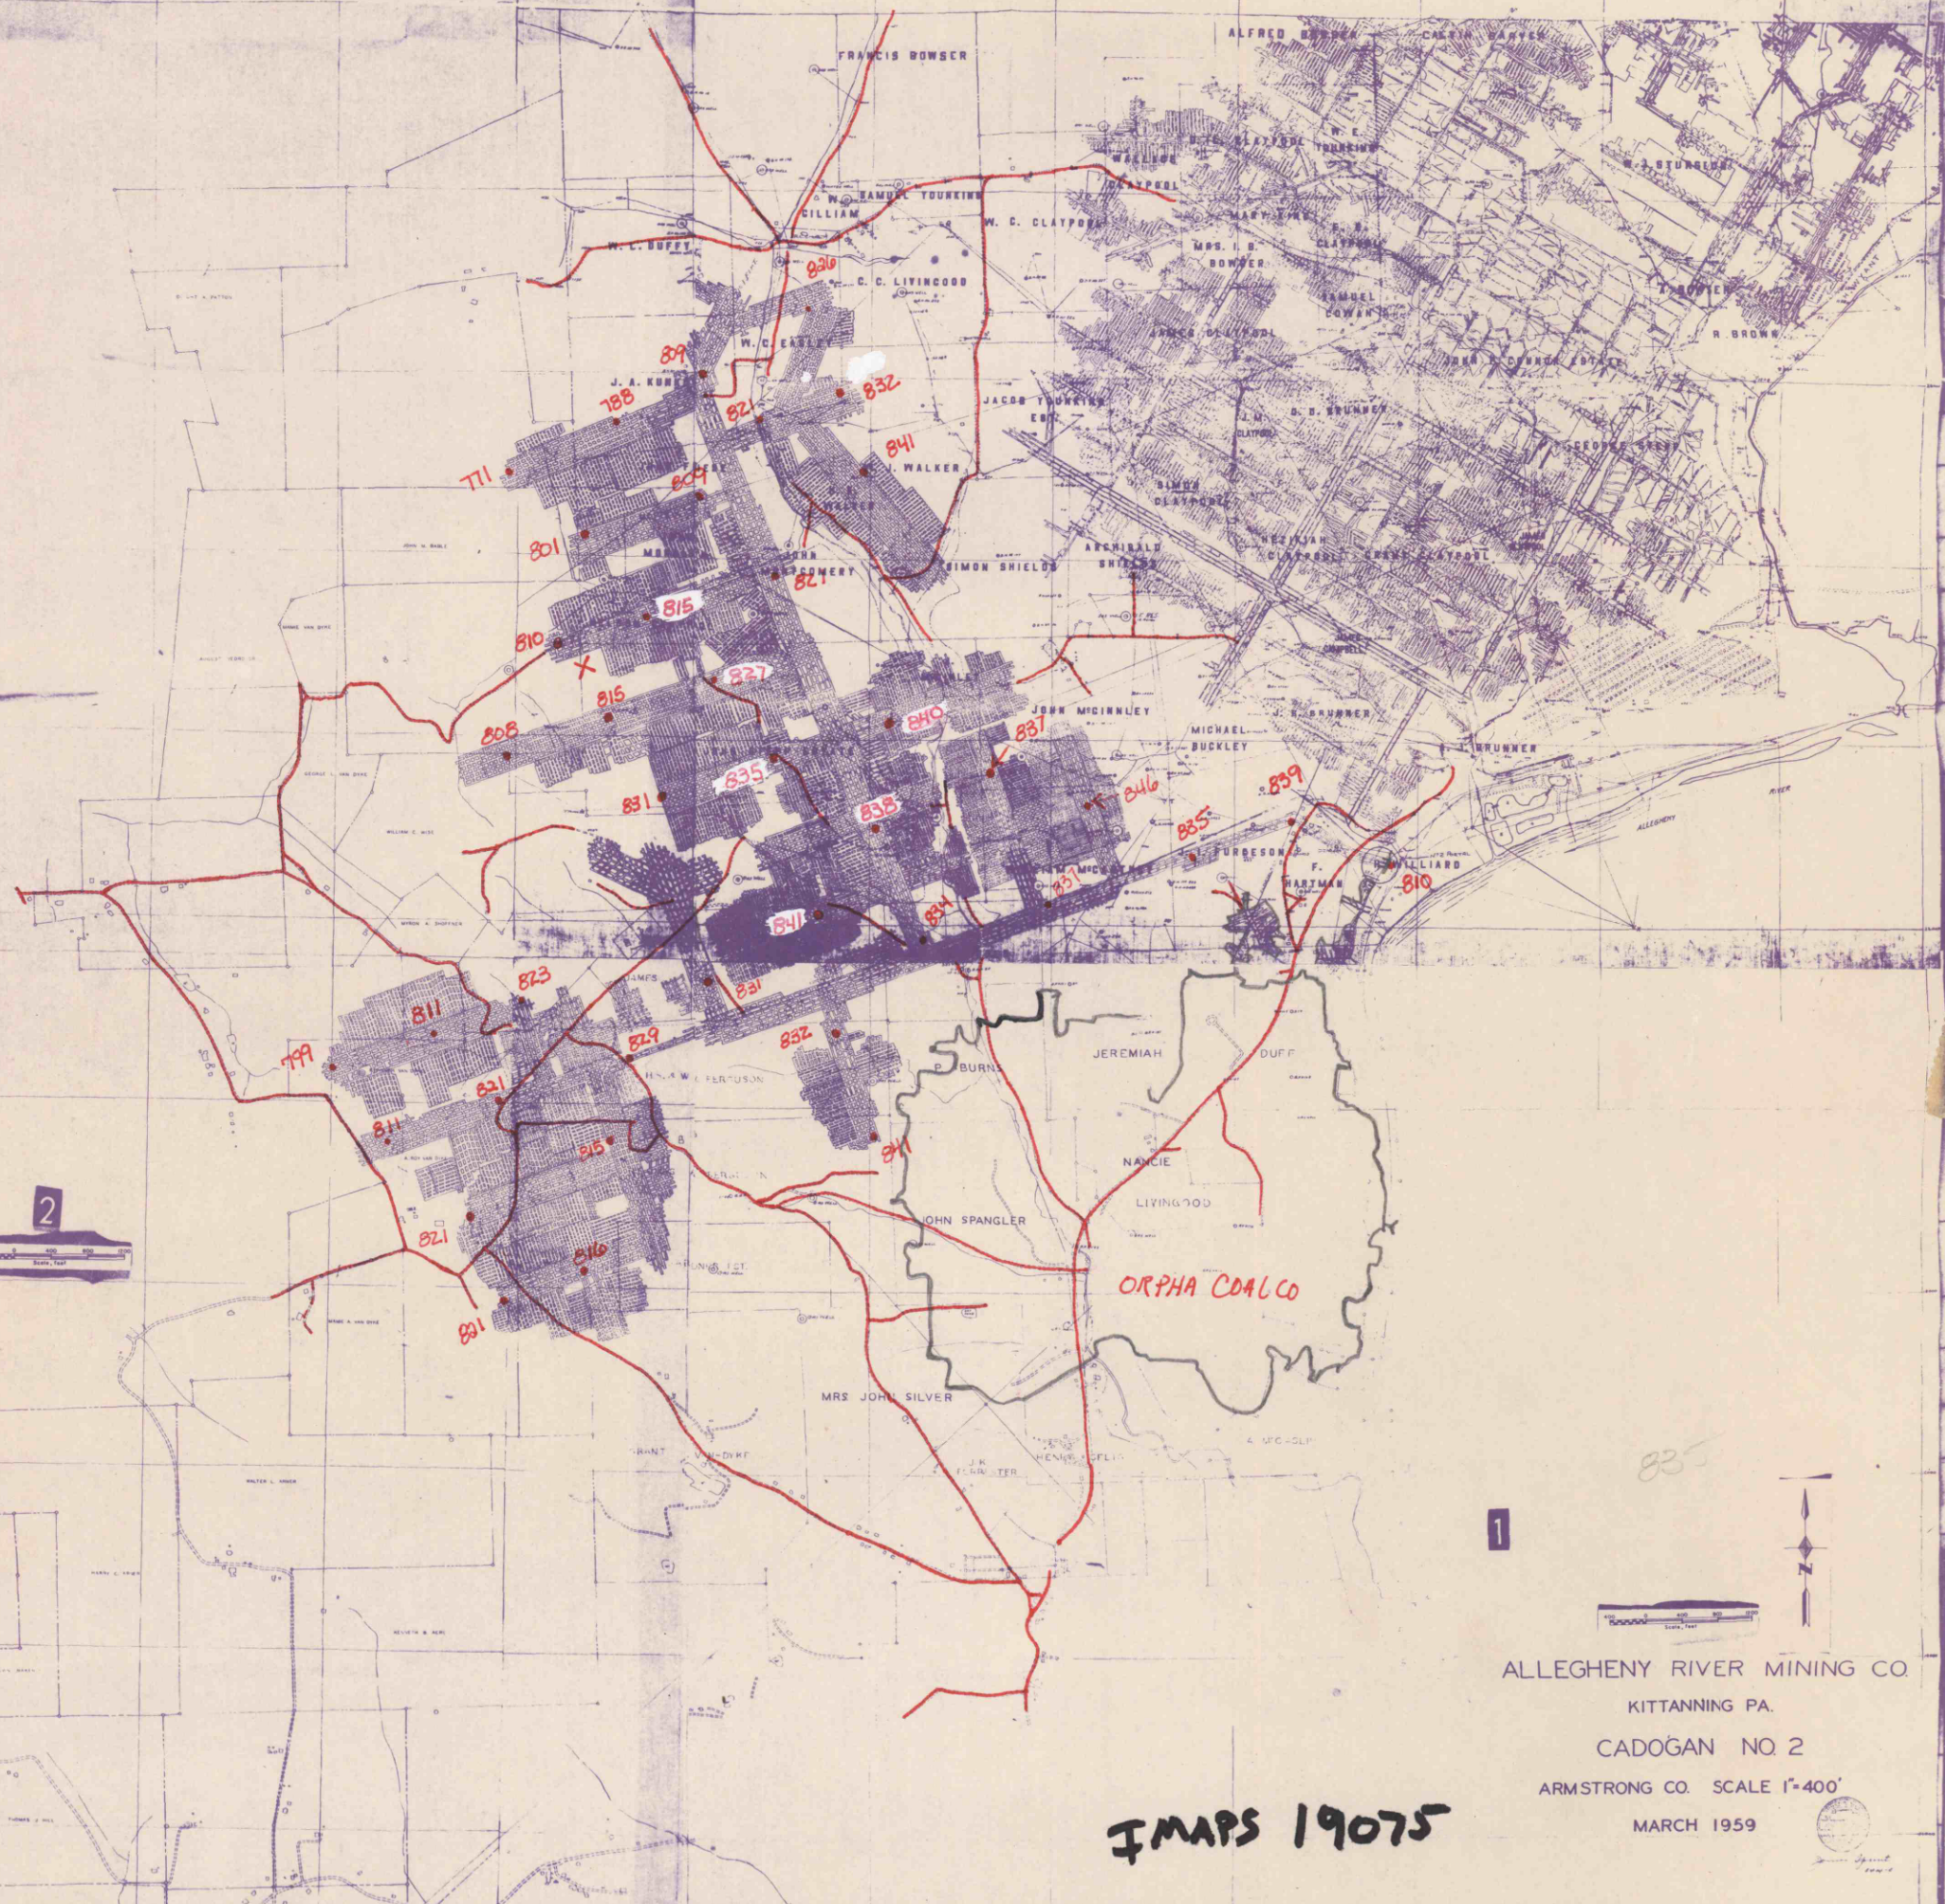

ALLEGHENY RIVER MINING CO.
KITTANNING PA.
CADOGAN NO. 2
ARMSTRONG CO. SCALE 1"=400'
MARCH 1959

MAPS 19075

PPWMS 03055 36X 319341

DATE - 2/25/70
FILED
E.N.P.