


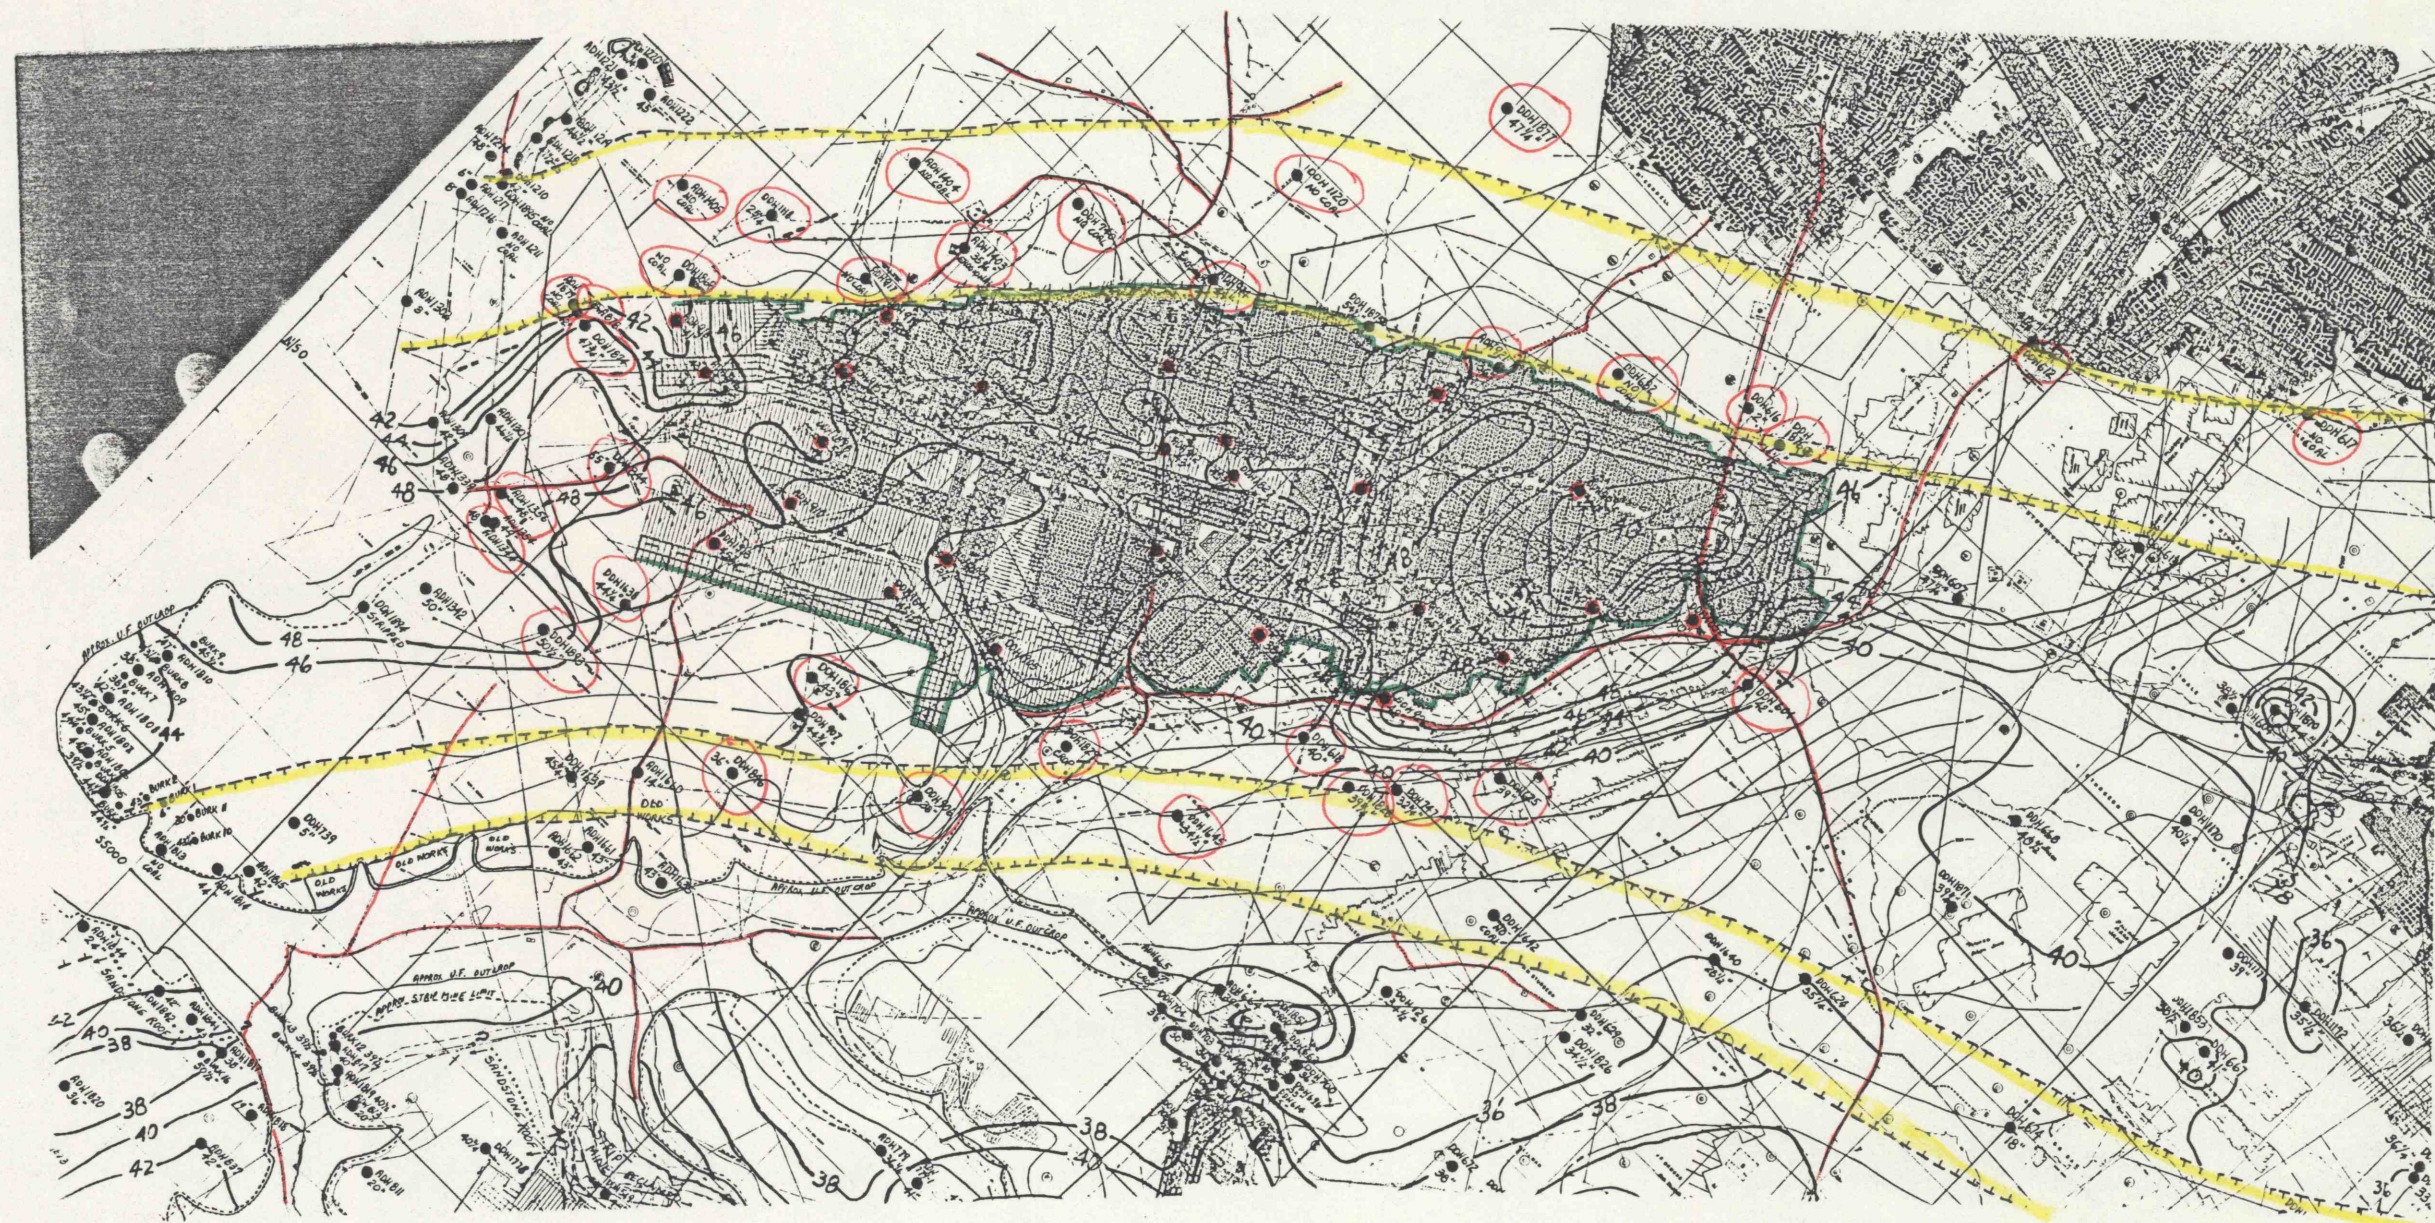

IMAPS # 19080