


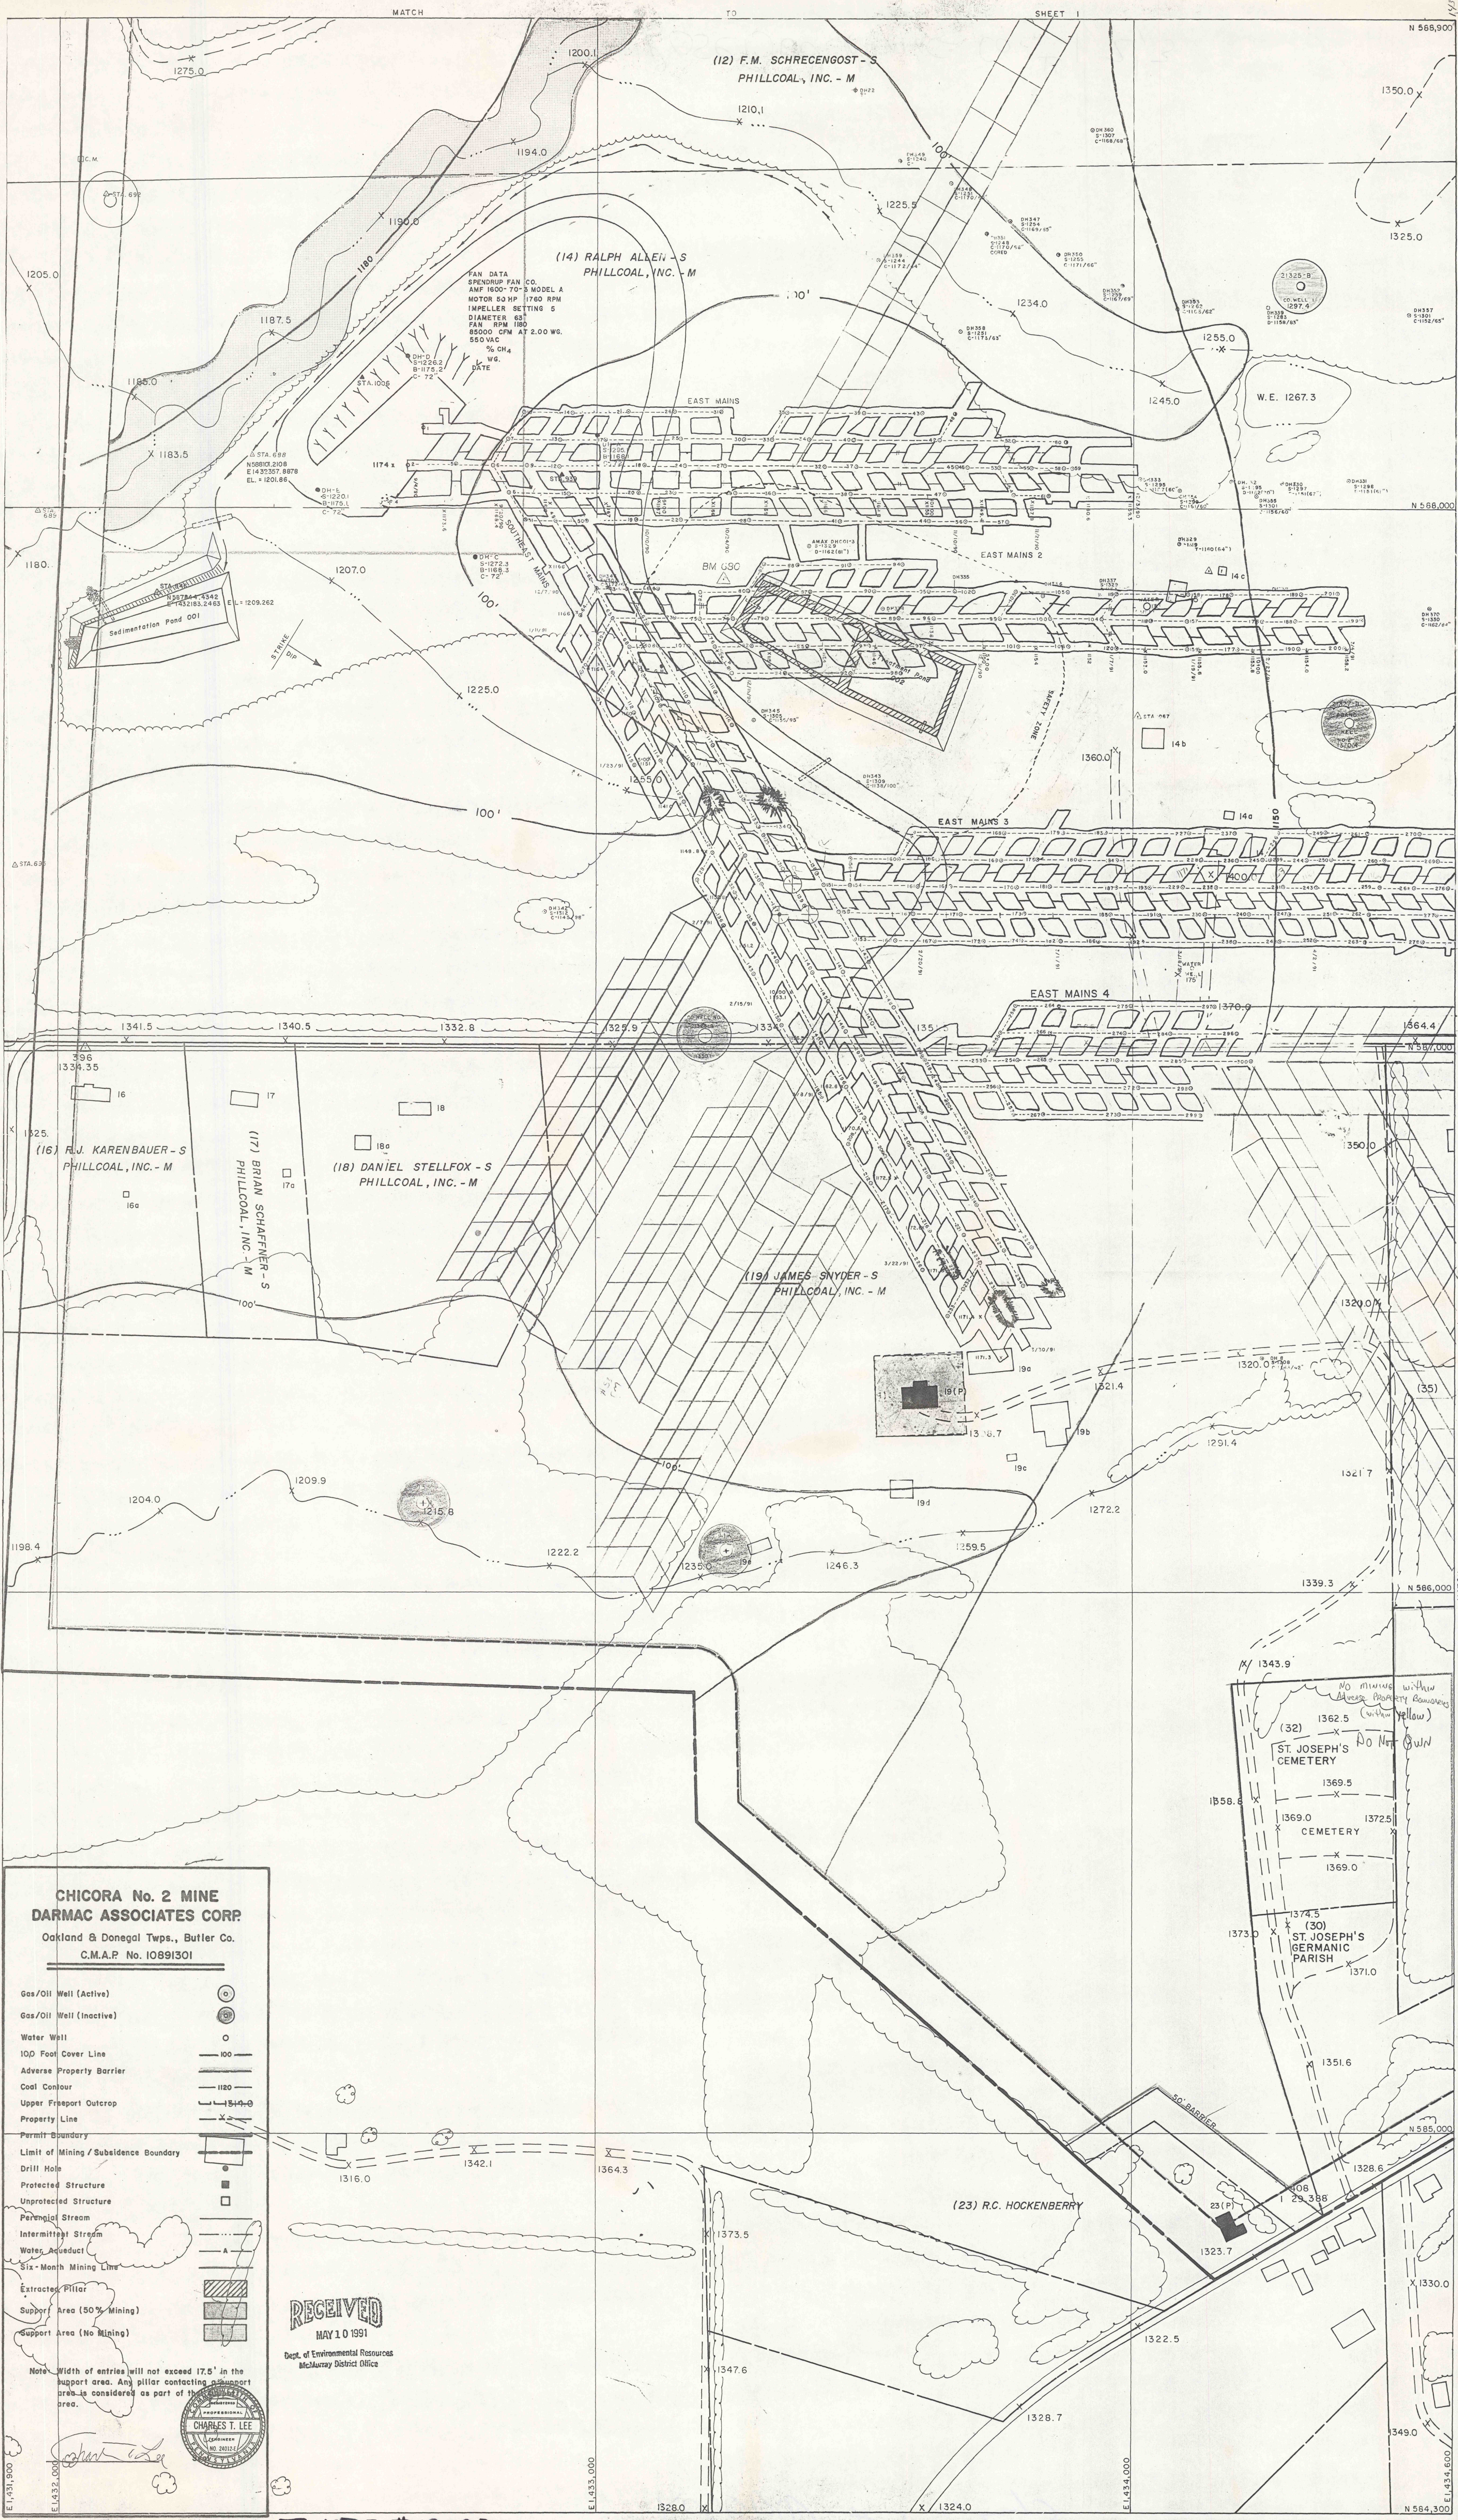

CHICORA No. 2 MINE
DARMAC ASSOCIATES CORP
Oakland & Donegal Twp., Butler Co.
C.M.A.P. No. 10891301

Gas/Oil Well (Active)

Gas/Oil Well (Inactive)

Water Well

100' Foot Cover Line

Adverse Property Barrier

Coal Contour

Upper Freeport Outcrop

Property Line

Permit Boundary

Limit of Mining / Subsidence Boundary

Drill Hole

Protected Structure

Unprotected Structure

Perennial Stream

Intermittent Stream

Water Aqueduct

Six-Month Mining Line

Extracted Pillar

Support Area (50% Mining)

Support Area (No Mining)

Note: Width of entries will not exceed 17.5' in the support area. Any pillar contacting a support area is considered as part of the support area.

RECEIVED
MAY 10 1991
Dept. of Environmental Resources
McMurray District Office

CHARLES T. LEE
Professional Engineer
No. 26012