



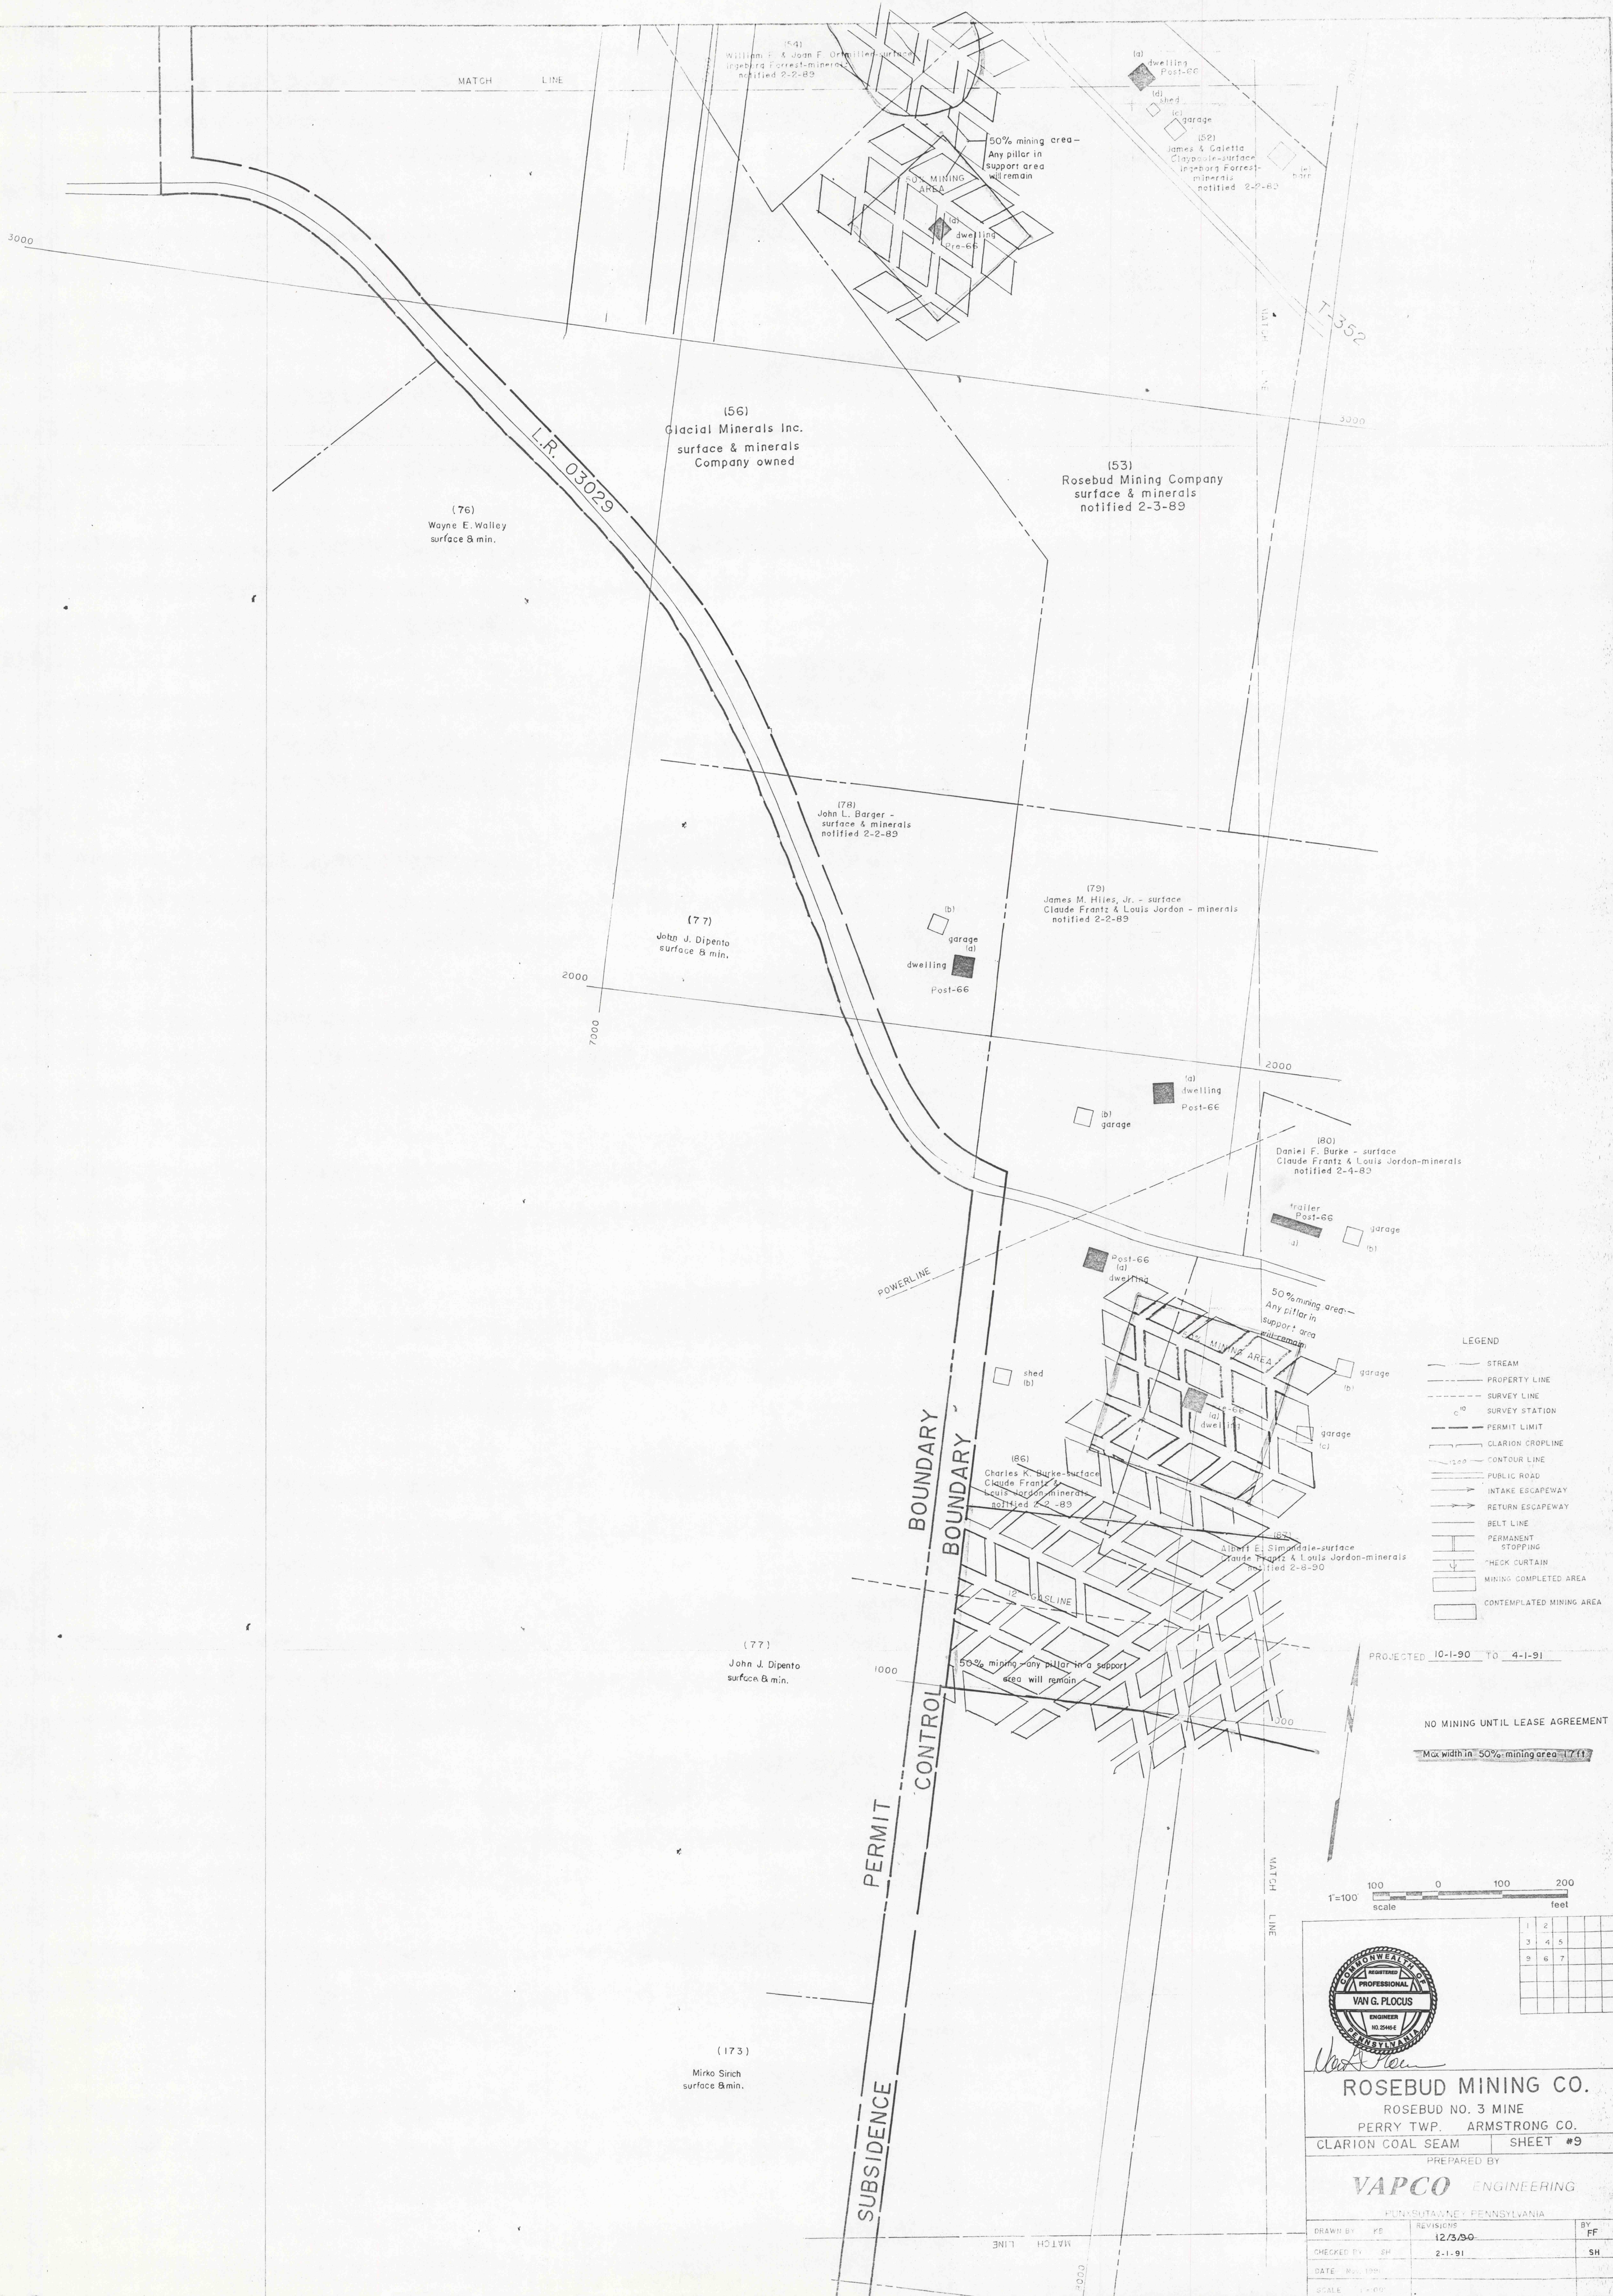


- LEGEND
- STREAM
 - PROPERTY LINE
 - SURVEY LINE
 - SURVEY STATION
 - PERMIT LIMIT
 - CLARION CROPLINE
 - CONTOUR LINE
 - PUBLIC ROAD
 - INTAKE ESCAPEWAY
 - RETURN ESCAPEWAY
 - BELT LINE
 - PERMANENT STOPPING
 - CHECK CURTAIN
 - MINING COMPLETED AREA
 - CONTEMPLATED MINING AREA

PROJECTED 10-1-90 TO 4-1-91

NO MINING UNTIL LEASE AGREEMENT

Max width in 50% mining area 17 ft

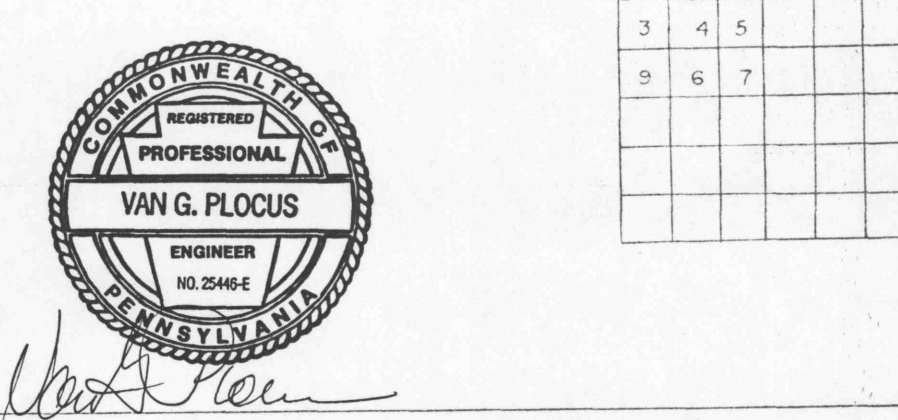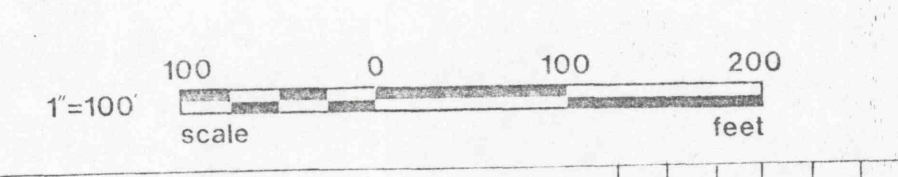

ROSEBUD MINING CO.
ROSEBUD NO. 3 MINE
PERRY TWP. ARMSTRONG CO.
CLARION COAL SEAM SHEET #9

PREPARED BY
VAPCO ENGINEERING
PUN: SUTAWNE: PENNSYLVANIA

DRAWN BY	REVISIONS	BY
KE	12/3/90	FF
SH	2-1-91	SH

DATE: 12/3/90
SCALE: 1"=100'

IMAPS 19086