


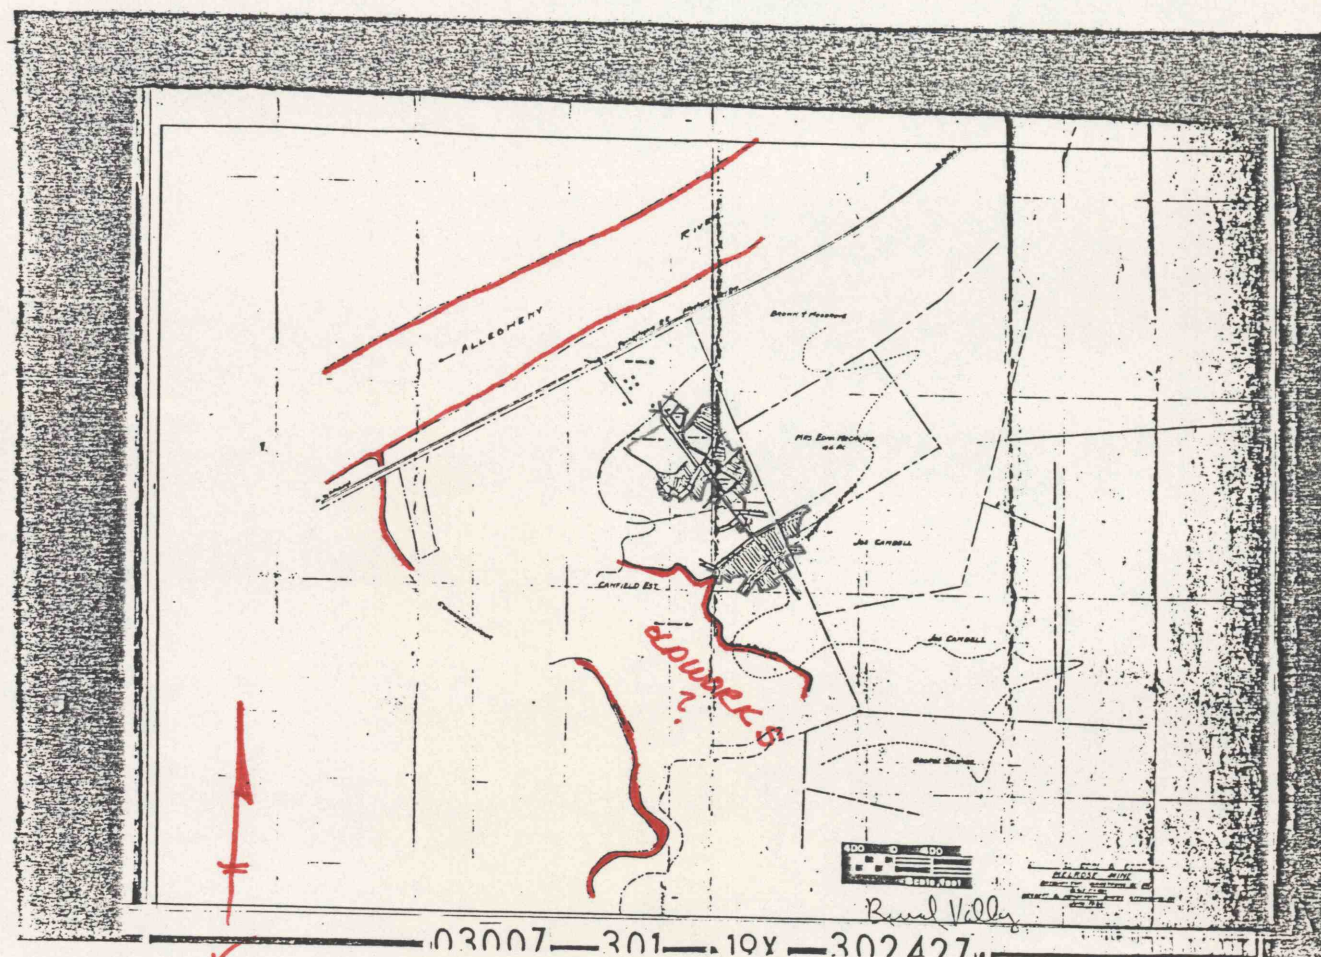

Whitesburg

Jawer Kittanning

1"=2000

1 MAPS 19089