


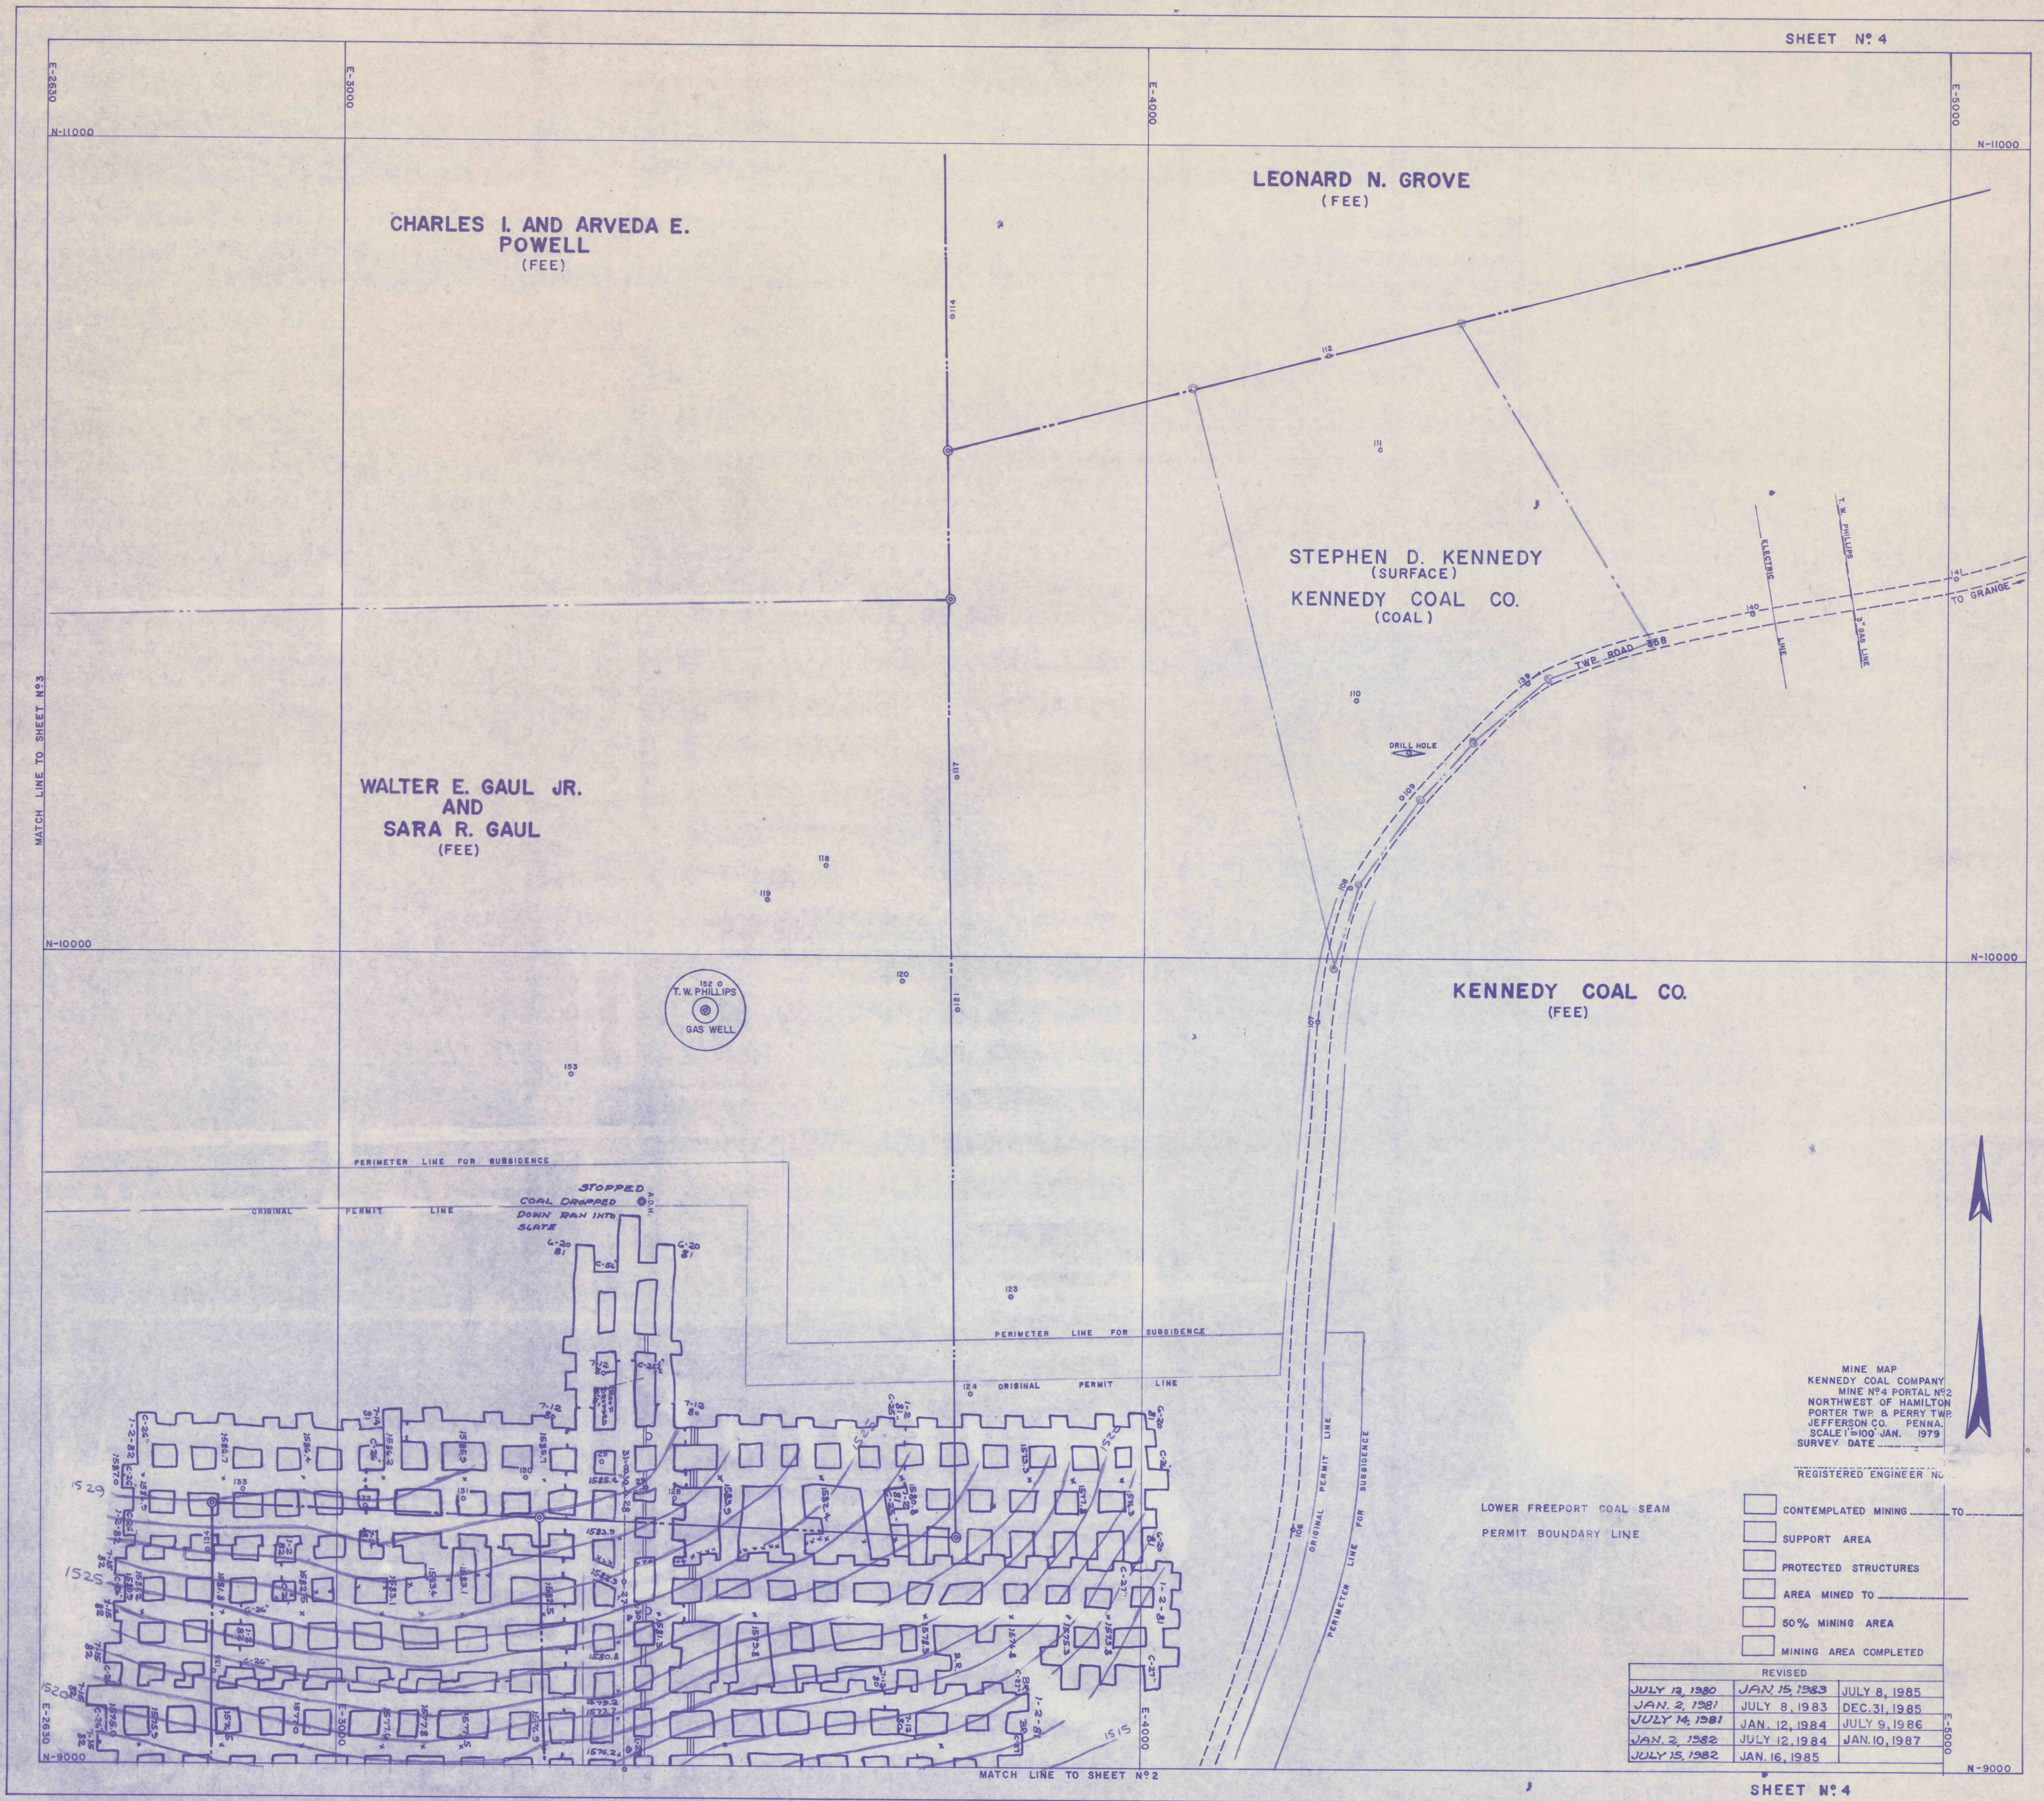

IMAPS # 19093