


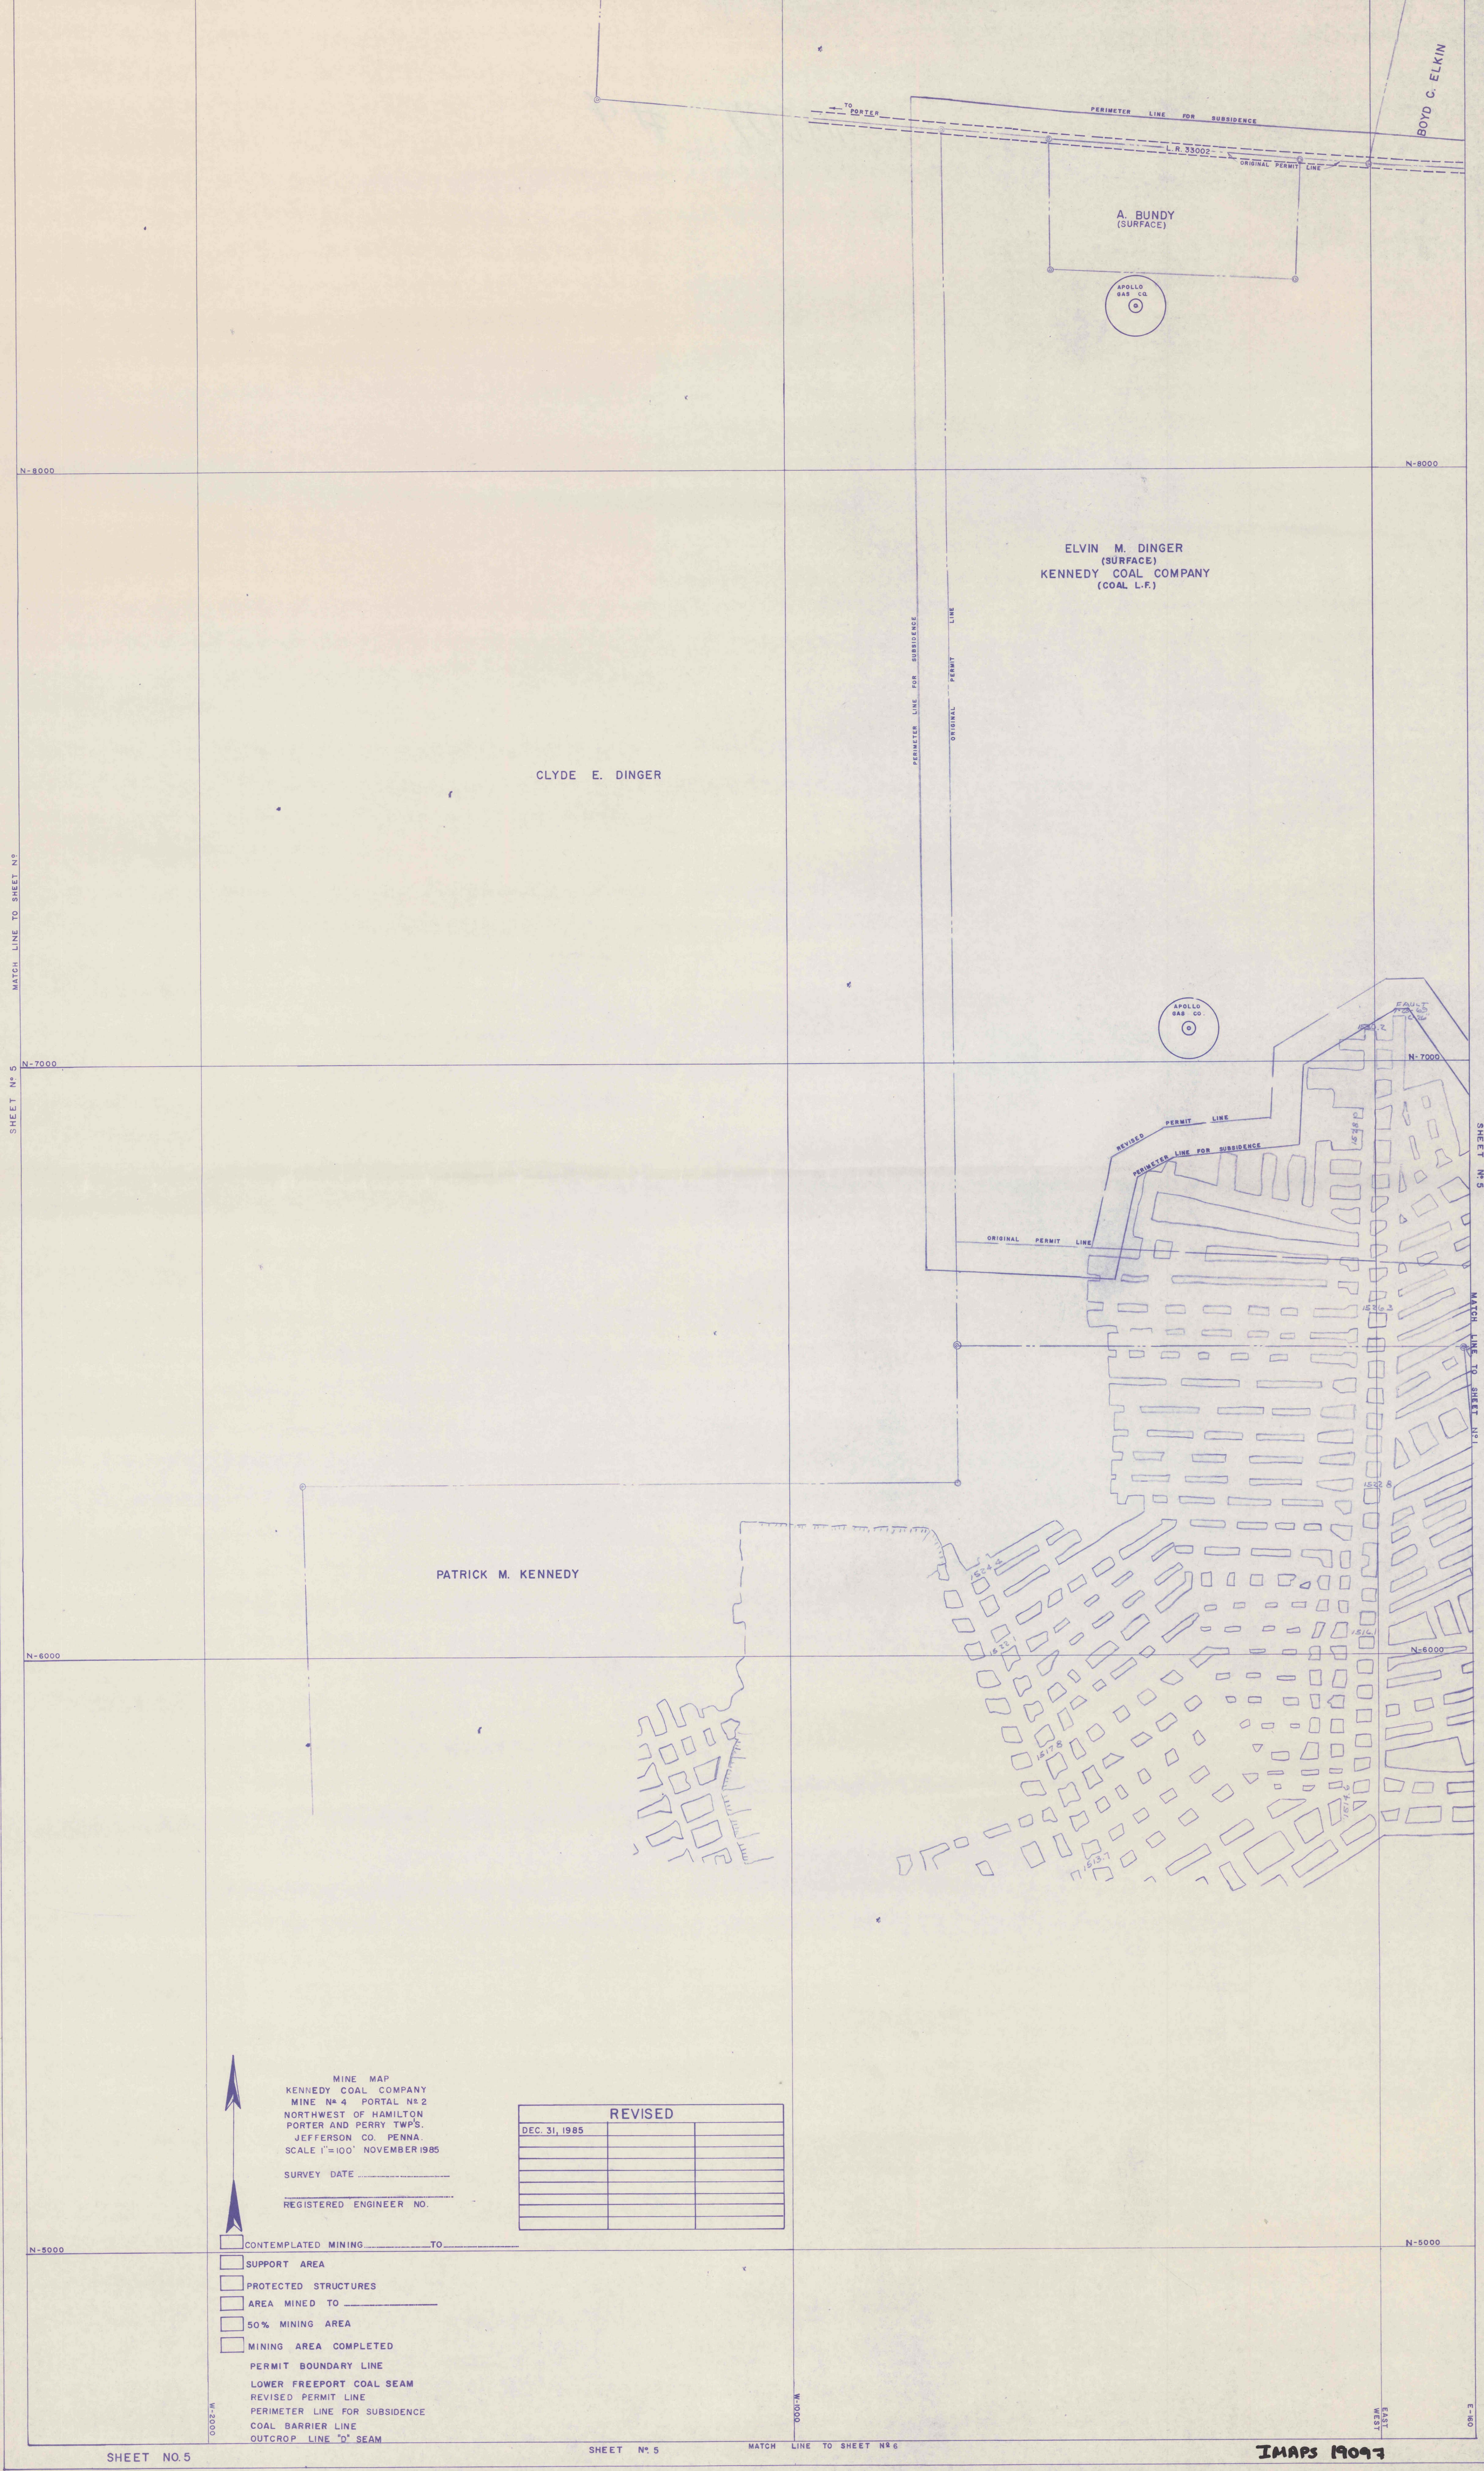

MINE MAP
KENNEDY COAL COMPANY
MINE No 4 PORTAL No 2
NORTHWEST OF HAMILTON
PORTER AND PERRY TOWNSHIPS,
JEFFERSON CO. PENNA.
SCALE 1"=100' NOVEMBER 1985

SURVEY DATE _____

REGISTERED ENGINEER NO. _____

- ☐ CONTEMPLATED MINING _____ TO _____
- ☐ SUPPORT AREA
- ☐ PROTECTED STRUCTURES
- ☐ AREA MINED TO _____
- ☐ 50% MINING AREA
- ☐ MINING AREA COMPLETED
- PERMIT BOUNDARY LINE
- LOWER FREEPORT COAL SEAM
- REVISED PERMIT LINE
- PERIMETER LINE FOR SUBSIDENCE
- COAL BARRIER LINE
- OUTCROP LINE "D" SEAM

REVISED		
DEC. 31, 1985		