

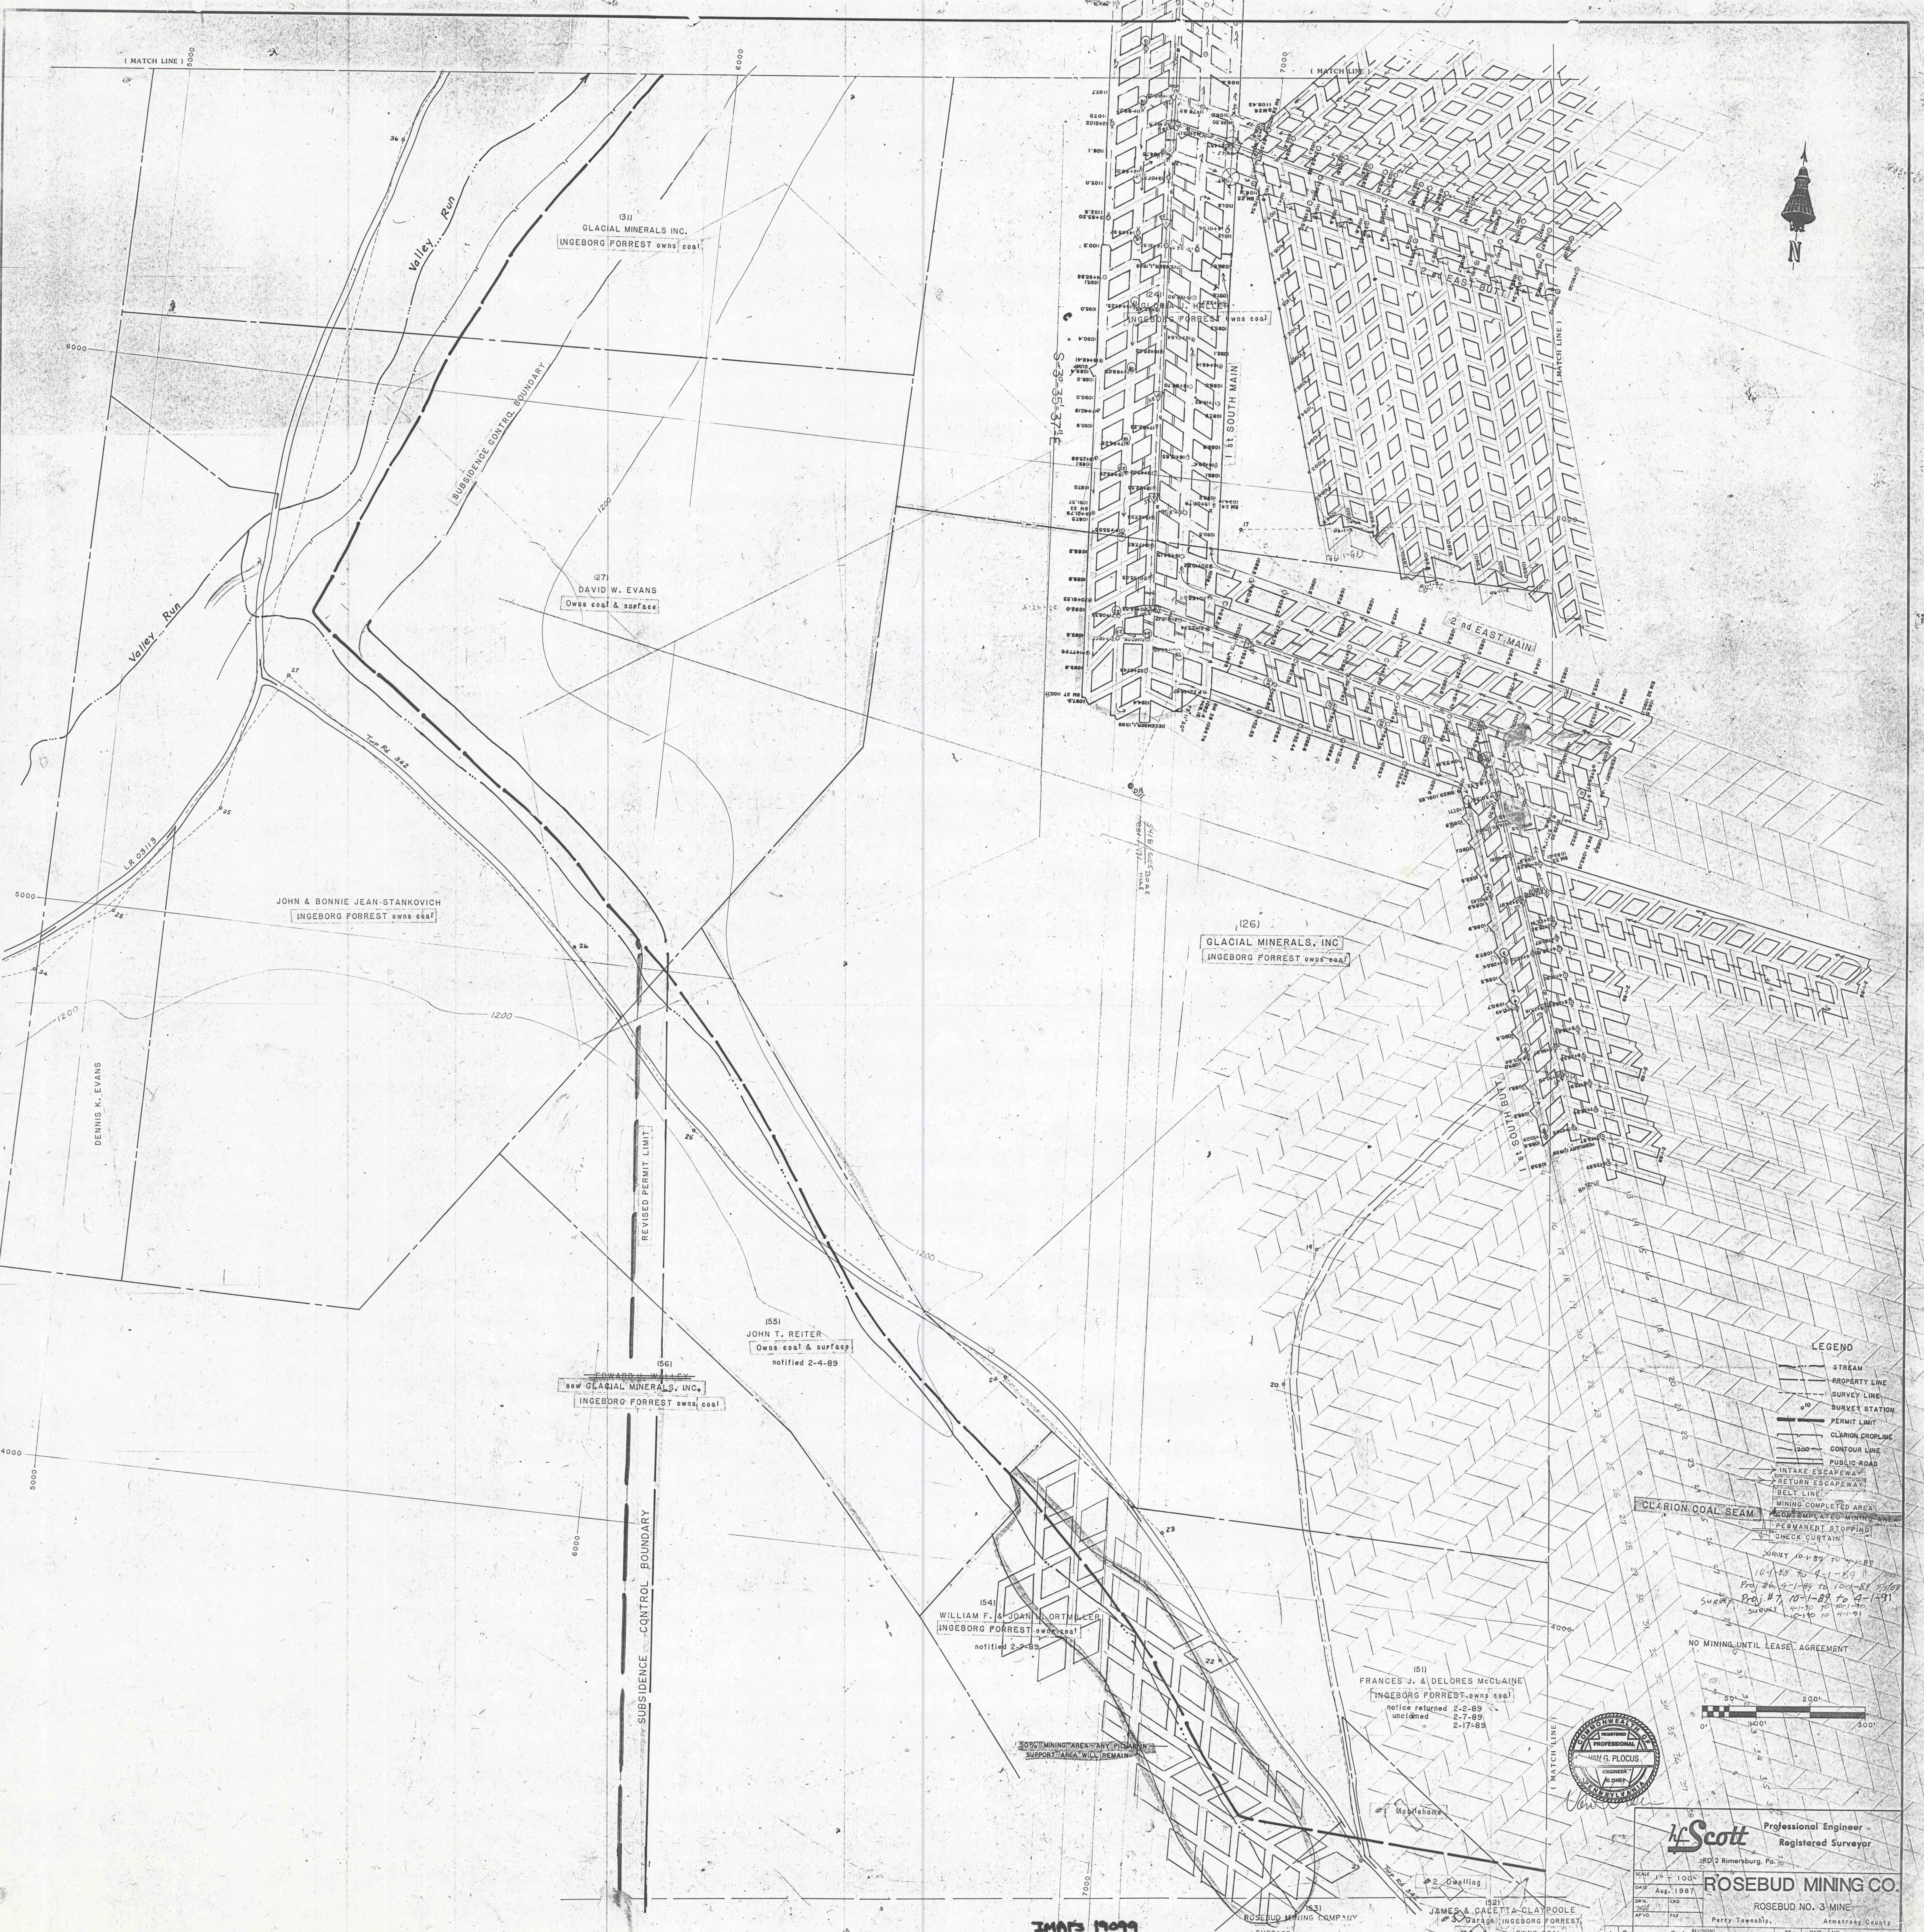
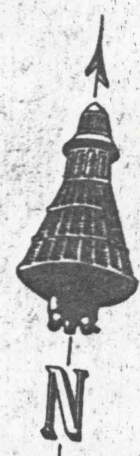


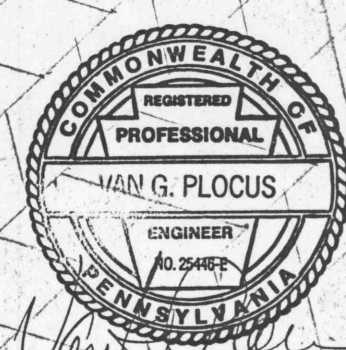

- LEGEND**
- STREAM
 - PROPERTY LINE
 - SURVEY LINE
 - SURVEY STATION
 - PERMIT LIMIT
 - CLARION COAL SEAM
 - CONTOUR LINE
 - PUBLIC ROAD
 - INTAKE ESCAPEWAY
 - RETURN ESCAPEWAY
 - BELT LINE
 - MINING COMPLETED AREA
 - PERMANENT STOPPING
 - CHECK CURTAIN

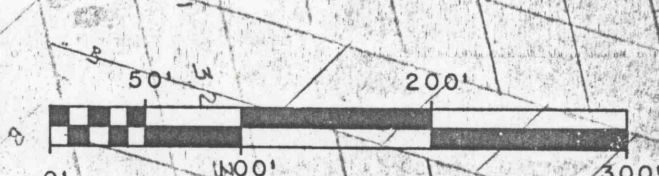

Scott Professional Engineer
Registered Surveyor
RD 2 Rimersburg, Pa.

ROSEBUD MINING CO.
ROSEBUD NO. 3 MINE
Armstrong County

Scale 1" = 100'
Date Aug. 1987
Project 12-3-89
Vapco Engineering

3445 1989

ROSEBUD MINING COMPANY
SURFACE AND COAL
notified 2-3-89

JAMES & CALETTA CLAYPOOLE
Garage INGEBOG FORREST
Barn OWNS COAL
notified 2-2-89

(155) JOHN T. REITER
OWNS coal & surface
notified 2-4-89

(156) EDWARD W. WILEY
now GLACIAL MINERALS, INC.
INGEBOG FORREST owns coal

(154) WILLIAM F. & JOAN W. PORTMEYER
INGEBOG FORREST owns coal
notified 2-2-89

(151) FRANCES J. & DELORES McCLAIN
INGEBOG FORREST owns coal
notice returned 2-2-89
unclaimed 2-7-89
2-17-89

(131) GLACIAL MINERALS, INC.
INGEBOG FORREST owns coal

(127) DAVID W. EVANS
OWNS coal & surface

JOHN & BONNIE JEAN STANKOVICH
INGEBOG FORREST owns coal

(126) GLACIAL MINERALS, INC.
INGEBOG FORREST owns coal