




- LEGEND
- STREAM
 - PROPERTY LINE
 - SURVEY LINE
 - SURVEY STATION
 - PERMIT LIMIT
 - CLARION CROPLINE
 - CONTOUR LINE
 - PUBLIC ROAD
 - INTAKE ESCAPEWAY
 - RETURN ESCAPEWAY
 - BELT LINE
 - PERMANENT STOPPING
 - CHECK CURTAIN
 - MINING COMPLETED AREA
 - CONTEMPLATED MINING AREA

PROJECTED 4-1-90 TO 10-1-90
10-1-90 TO 4-1-91

CLARION COAL SEAM

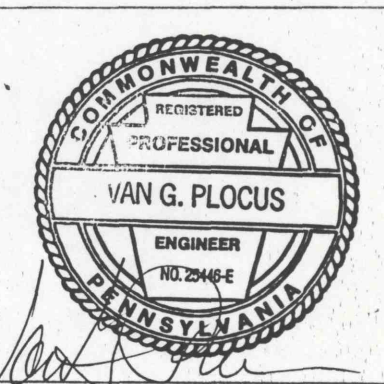

h Scott Professional Engineer
Registered Surveyor
RD 2 Rimersburn Pn.

ROSEBUD MINING CO.
ROSEBUD NO. 3 MINE
Perry Township, Armstrong County

SCALE: 1" = 100'
DATE: 5-19-90
BY: [Signature]
6 MONTH PROJECTIONS BY: [Signature]

5

IMAPD # 19100

