

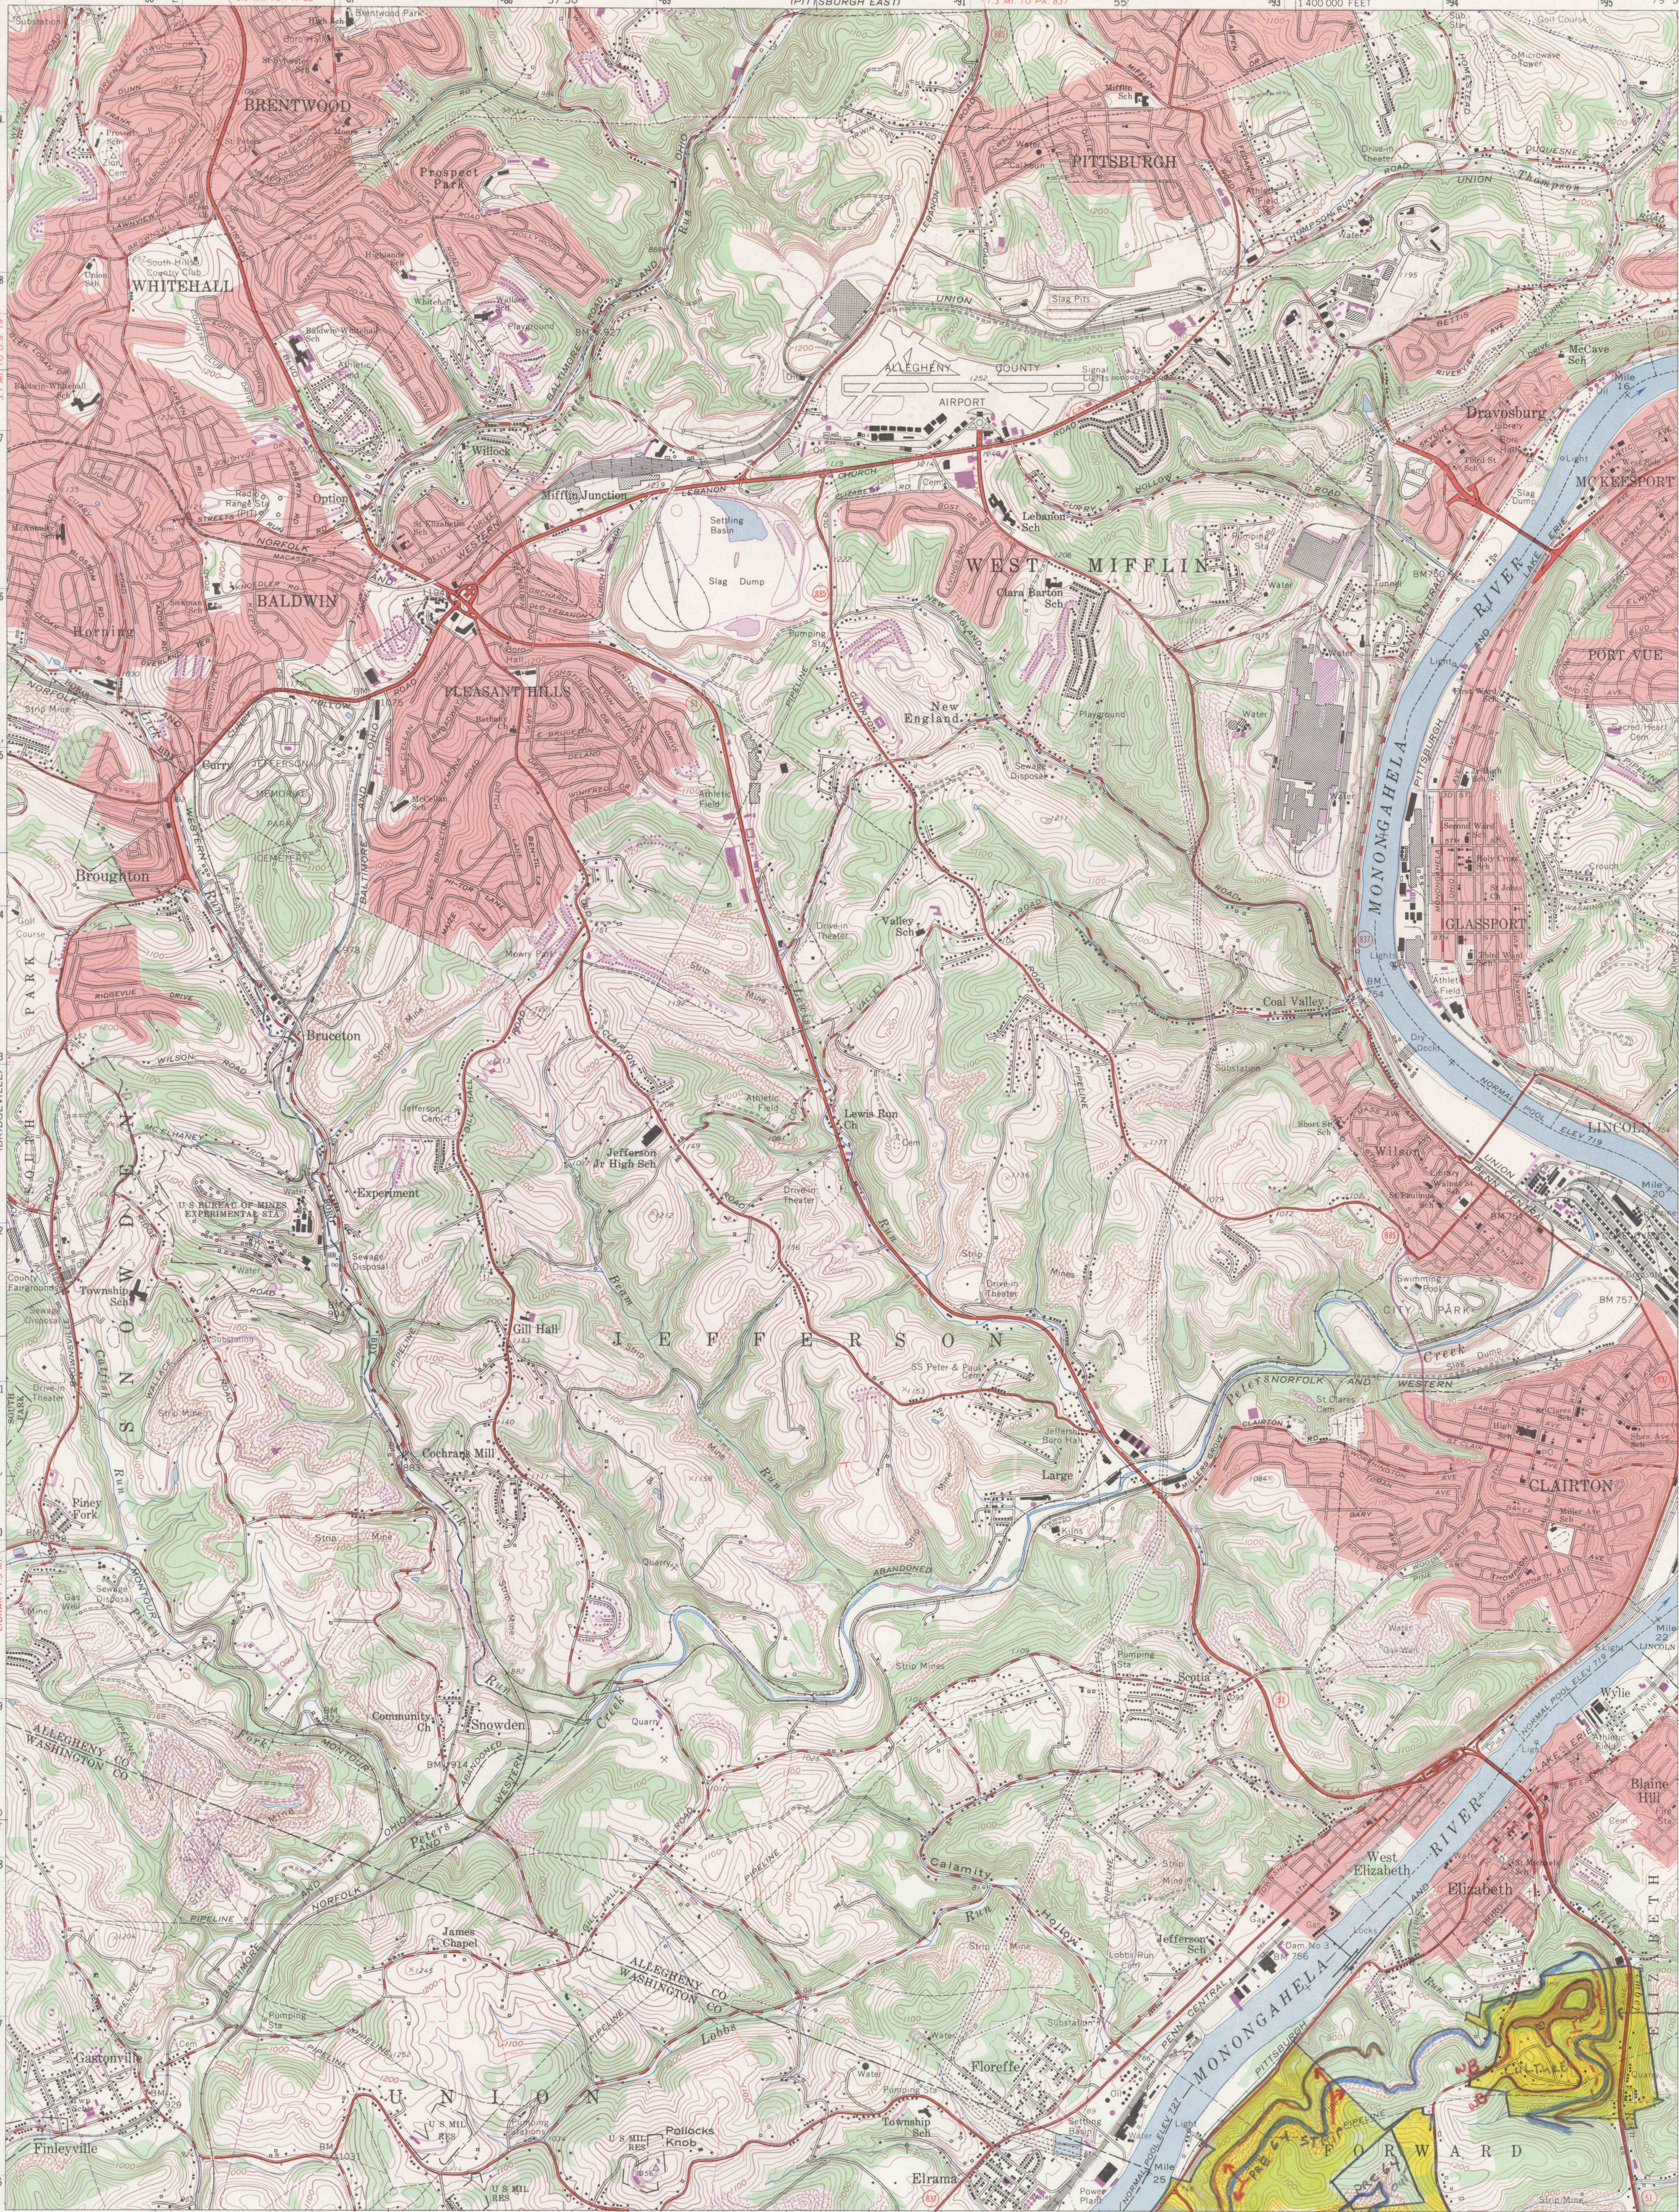


80°00' 40°22'30" 1860000 E WEST END LONG. U.S. 100 5.7 MI. 0.9 MI. TO PA. 88 188 57°30" 189 5064 IV NW (PITTSBURGH EAST) 591 1.3 MI. TO PA. 837 55' 183 1400000 FEET 184 79°52'30" 40°22'30"

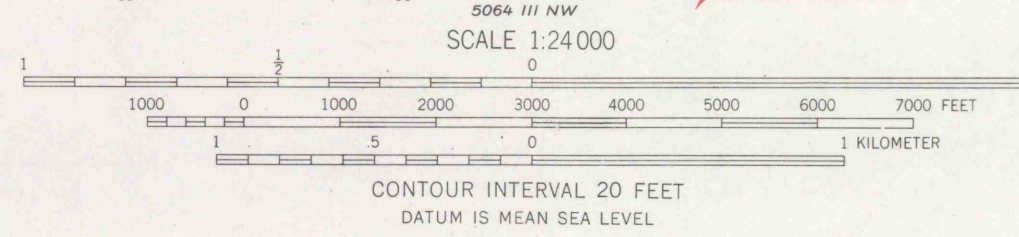

RS-0 AC
WB-2.0'
WB-13 AC →
39000 T

Maped, edited, and published by the Geological Survey
Control by USGS, USC&GS, and City of Pittsburgh
Topography from aerial photographs by photogrammetric methods
Aerial photographs taken 1952. Revised by photogrammetric methods
from aerial photographs taken 1959. Field check 1960
Polyconic projection. 1927 North American datum
10,000-foot grid based on Pennsylvania coordinate system, south zone
1000-meter Universal Transverse Mercator grid ticks,
zone 17, shown in blue
Fine red dashed lines indicate selected fence and field lines where
generally visible on aerial photographs. This information is unchecked
Red tint indicates areas in which only landmark buildings are shown

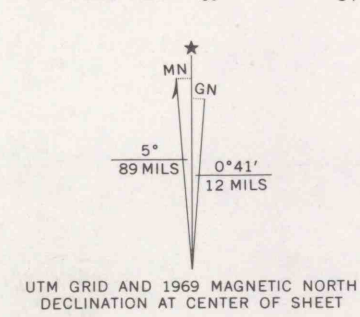

ROAD CLASSIFICATION
Heavy-duty ——— Light-duty ———
Medium-duty ——— Unimproved dirt ———
○ State Route
GLASSPORT, PA.
SW/4 PITTSBURGH 15' QUADRANGLE
N4015—W7952.5/7.5
1960
PHOTO-REVISED 1969
AMS 5064 IV SW—SERIES 8931
IMAPS# 19101

Revisions shown in purple compiled from aerial
photographs taken 1969. This information not
field checked