


13057-31

13057-31

DAVIS Coal Co. No 3 MINE

PROPERTY LINE
COMPLETED MINING
CONTEMPLATED MINING
STRUCTURES
SUPPORT AREA

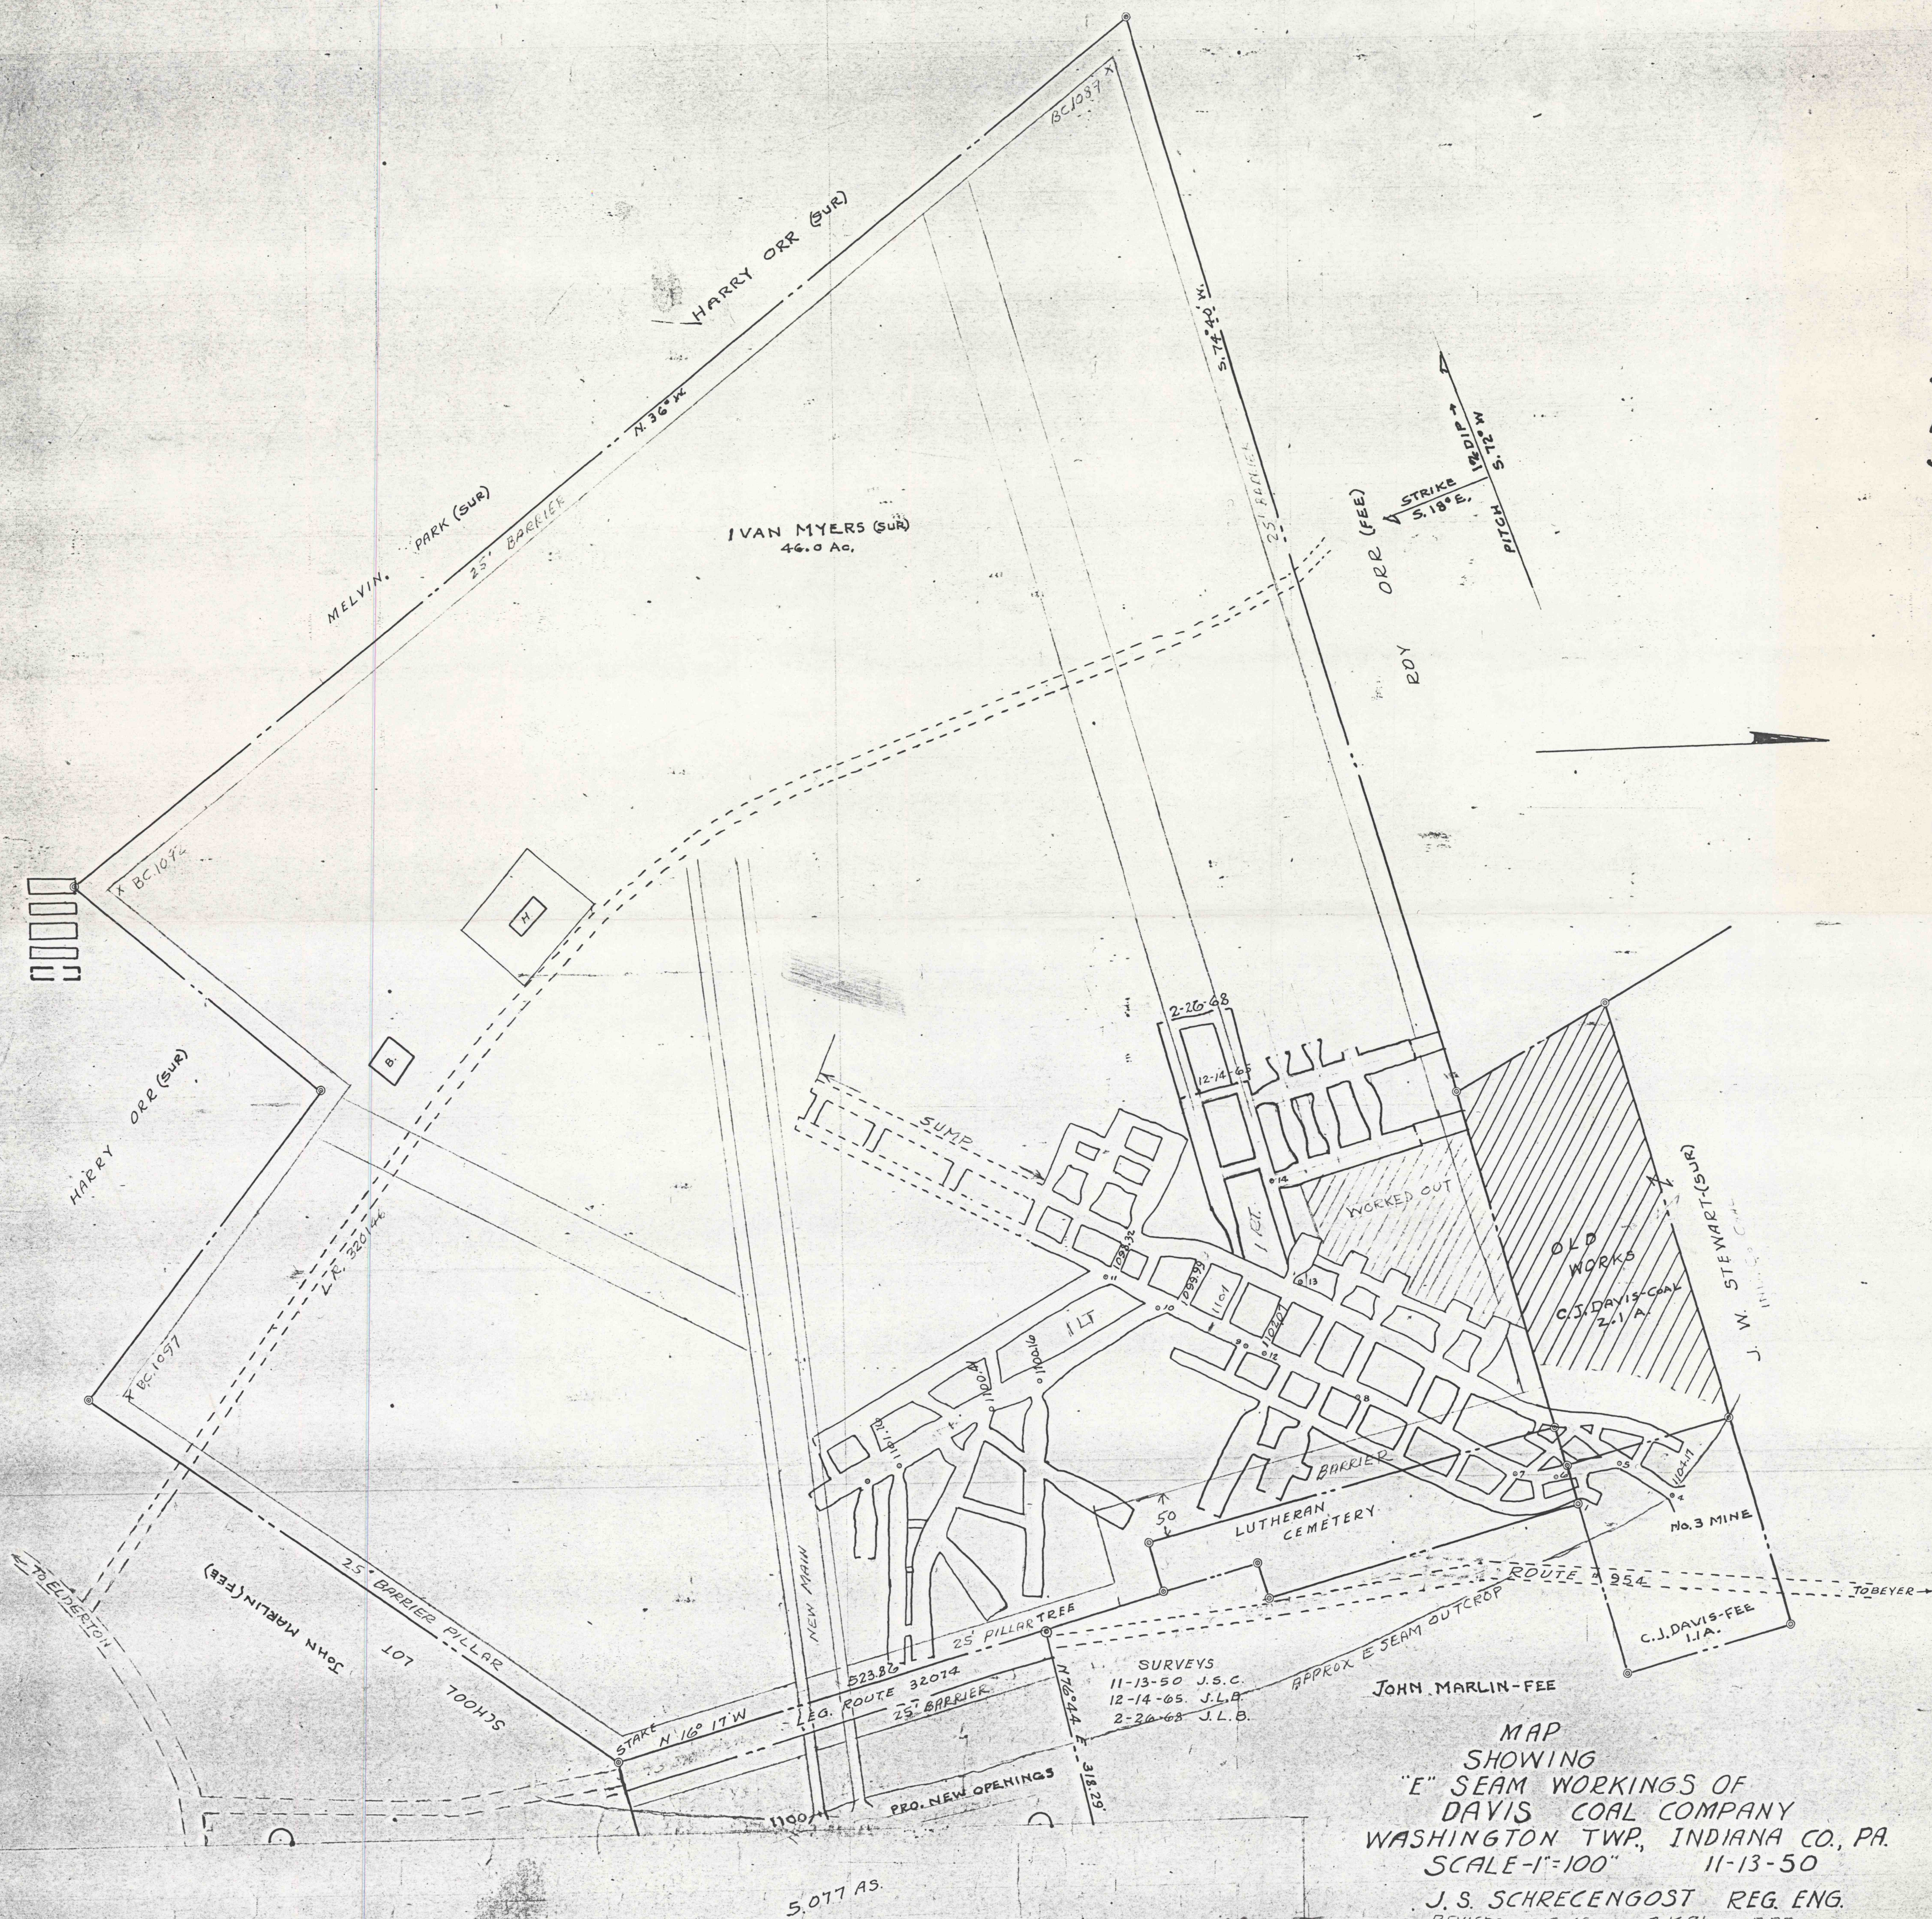

IMAPS 19105