
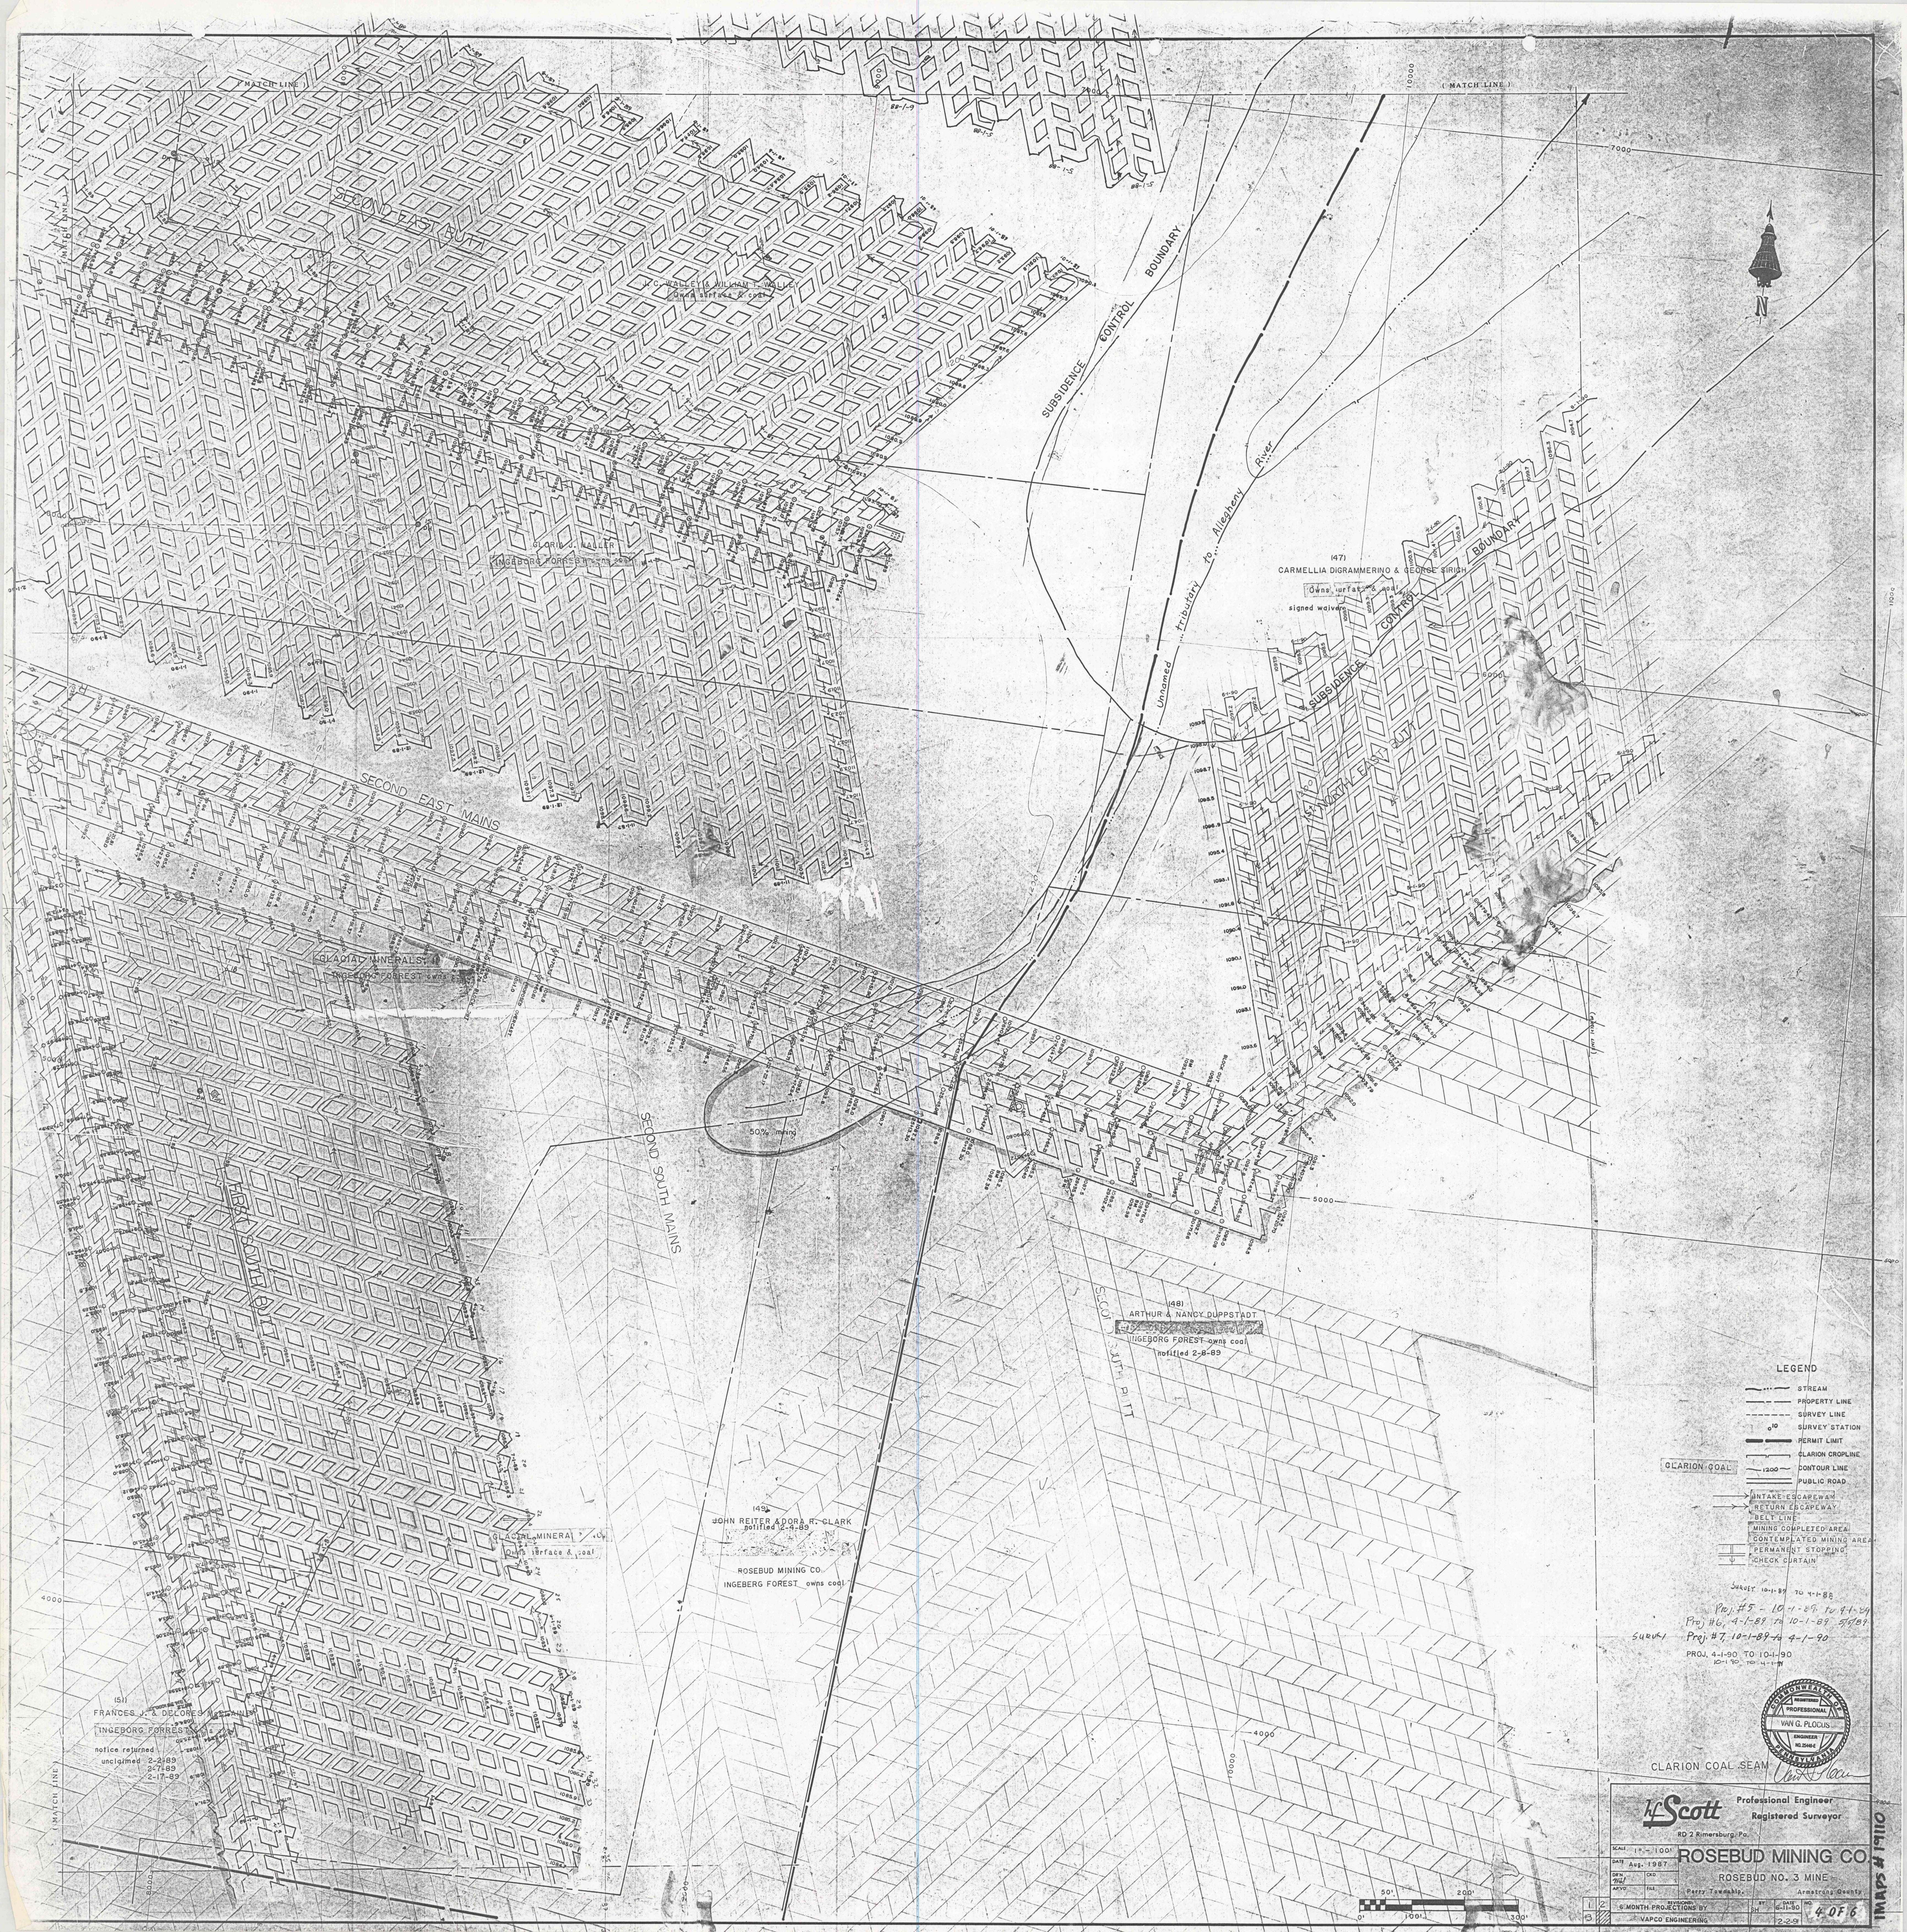


- LEGEND**
- STREAM
 - PROPERTY LINE
 - SURVEY LINE
 - SURVEY STATION
 - PERMIT LIMIT
 - CLARION COAL SEAM
 - CLARION COAL
 - 1200' CONTOUR LINE
 - PUBLIC ROAD
 - INTAKE ESCAPEWAY
 - RETURN ESCAPEWAY
 - DECLINE
 - MINING COMPLETED AREA
 - CONTEMPLATED MINING AREA
 - PERMANENT STOPPING
 - CHECK CURTAIN

SUBJECT 10-1-89 TO 4-1-89
Proj. #5 - 10-1-89 TO 4-1-89
Proj. #6 - 4-1-89 TO 10-1-89 5/89
SUBJECT 10-1-89 TO 4-1-90
Proj. #7 - 10-1-89 TO 4-1-90
PROJ. 4-1-90 TO 10-1-90
10-1-90 TO 4-1-91

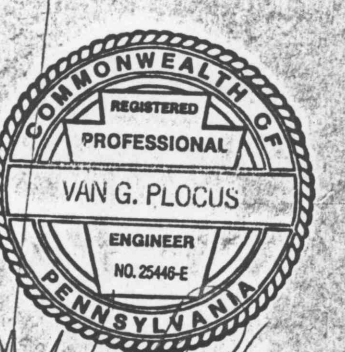

CLARION COAL SEAM

McScott Professional Engineer
Registered Surveyor
RD 2 Rimersburg, Pa.

ROSEBUD MINING CO.
ROSEBUD NO. 3 MINE
Armstrong County, Pa.
Perry Township
2-29
4 OF 6

