

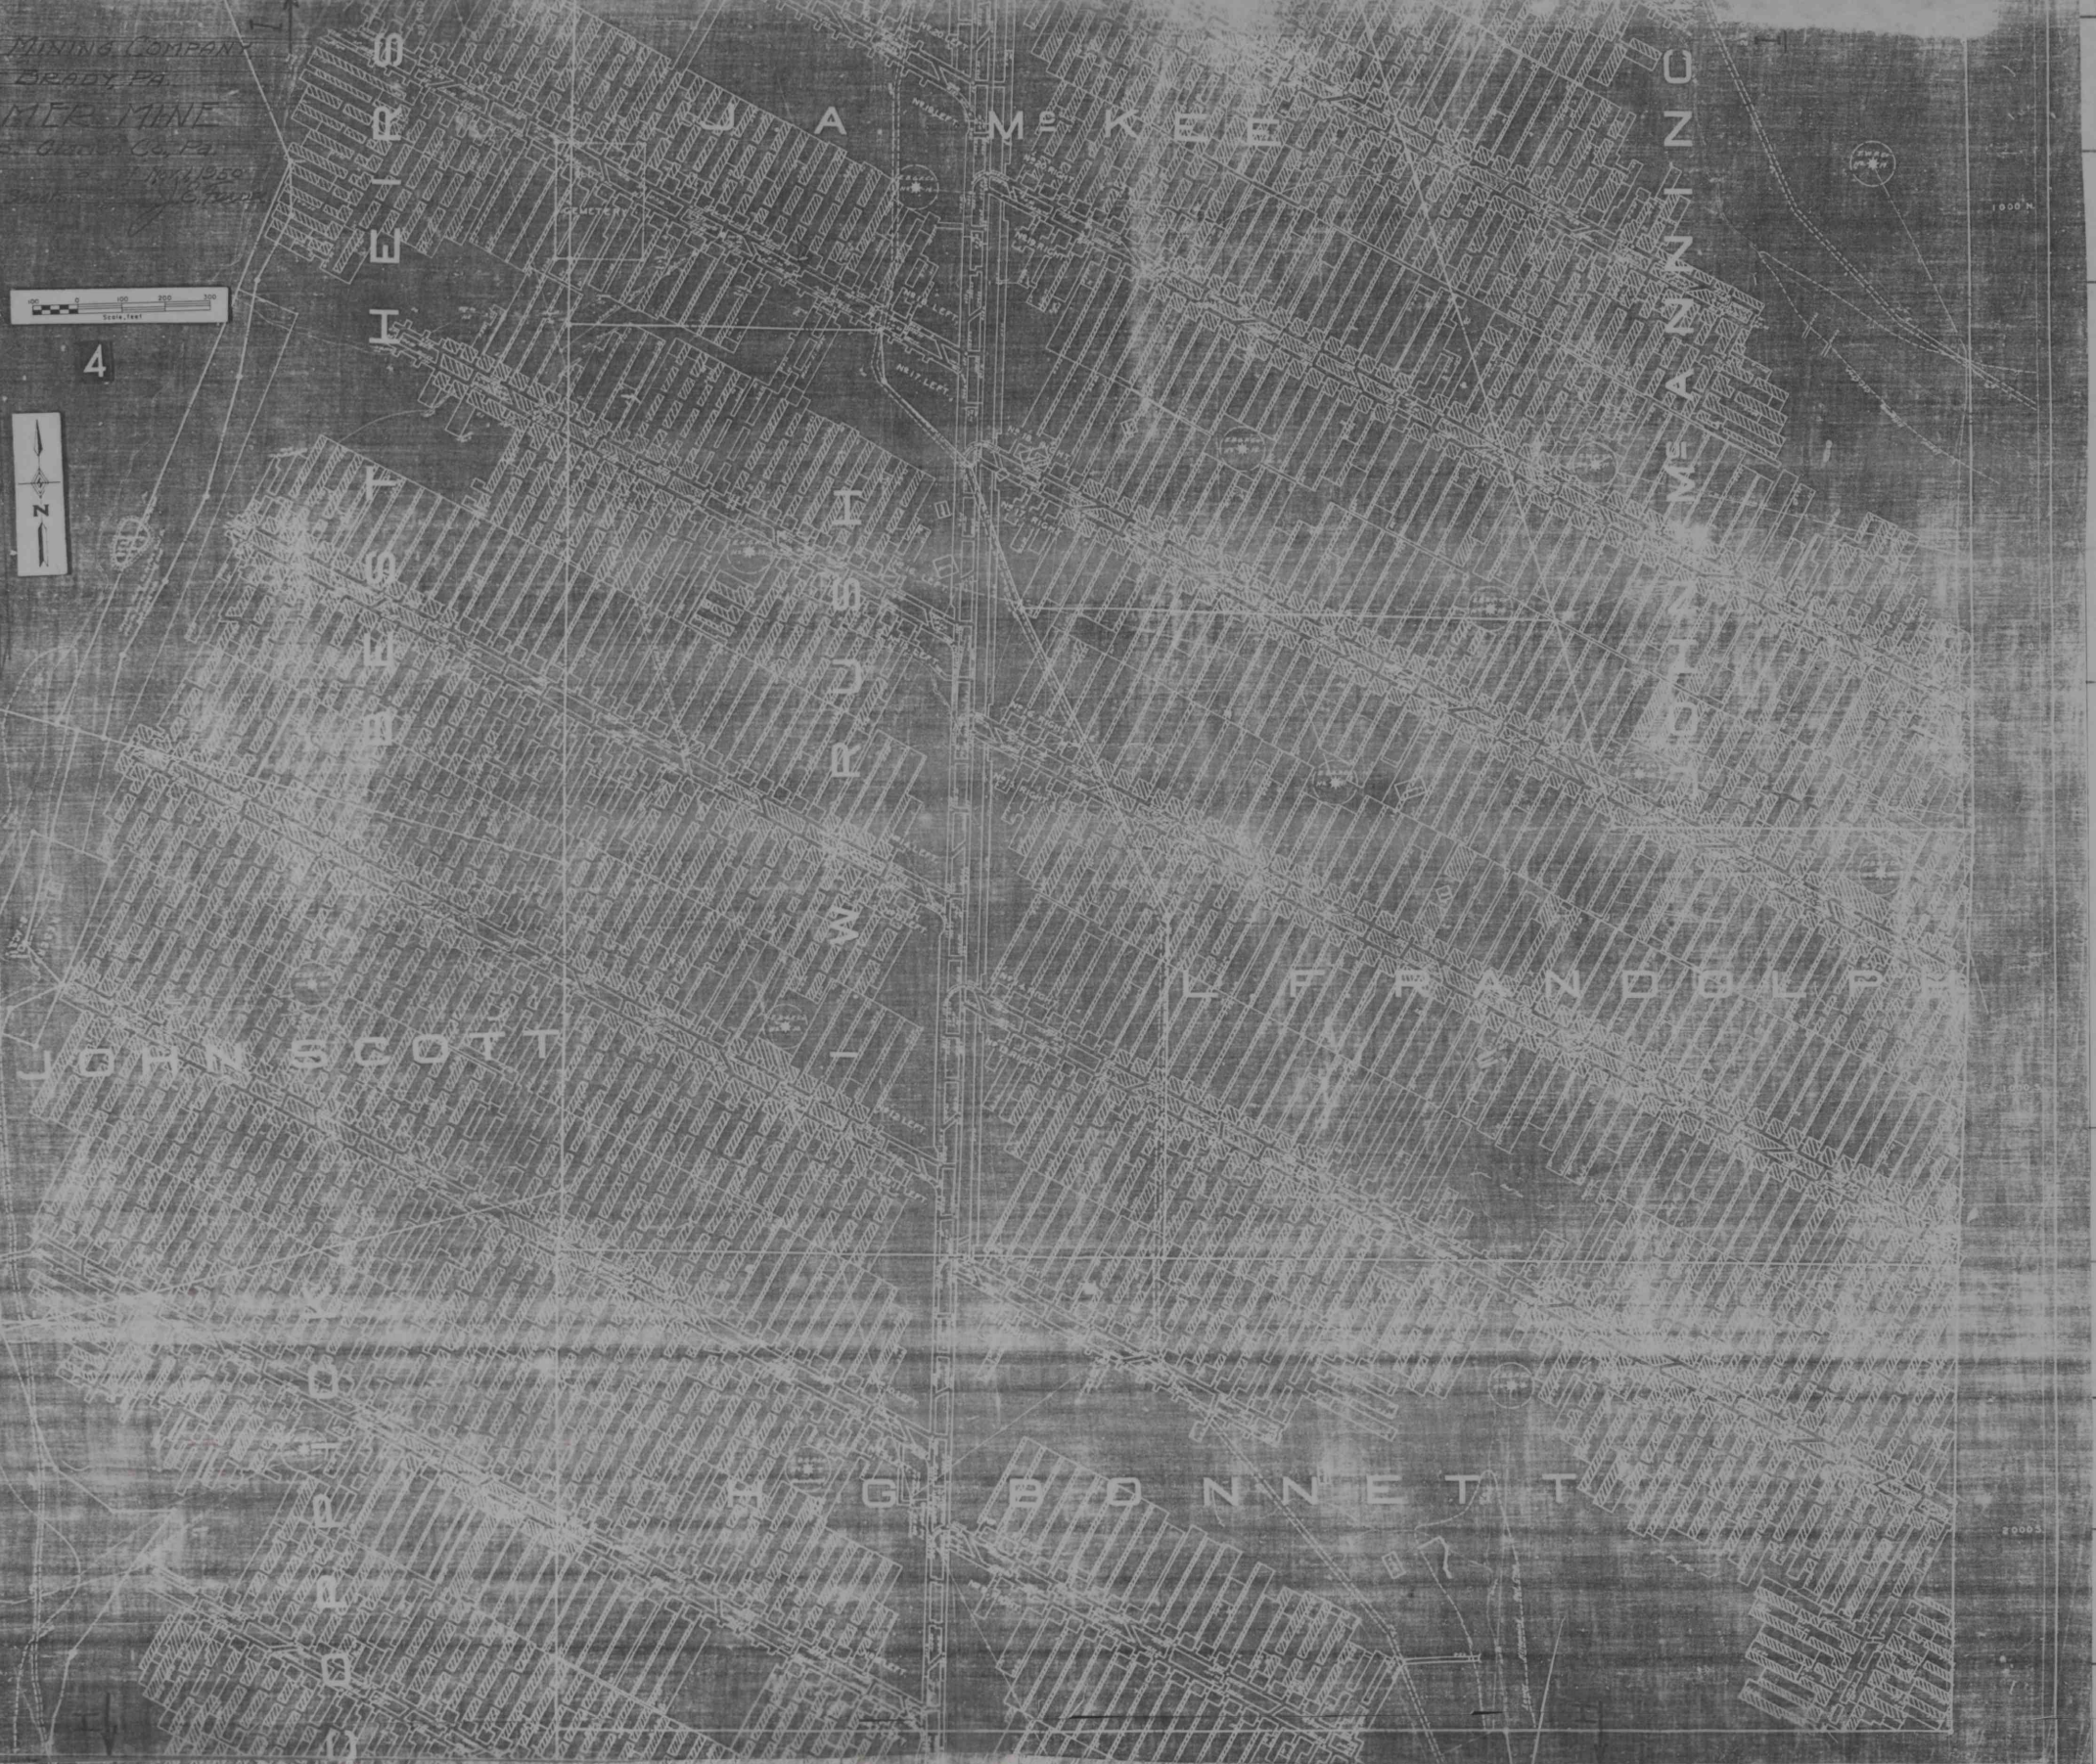


KEYSTONE MINING COMPANY
MORTIMER MINE
Scale 1" = 100'

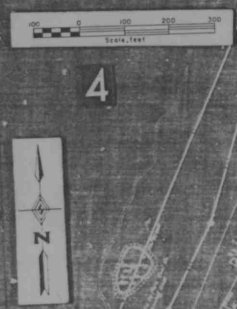

PDWMS
0304429836X 316142
IMV 3# 19112

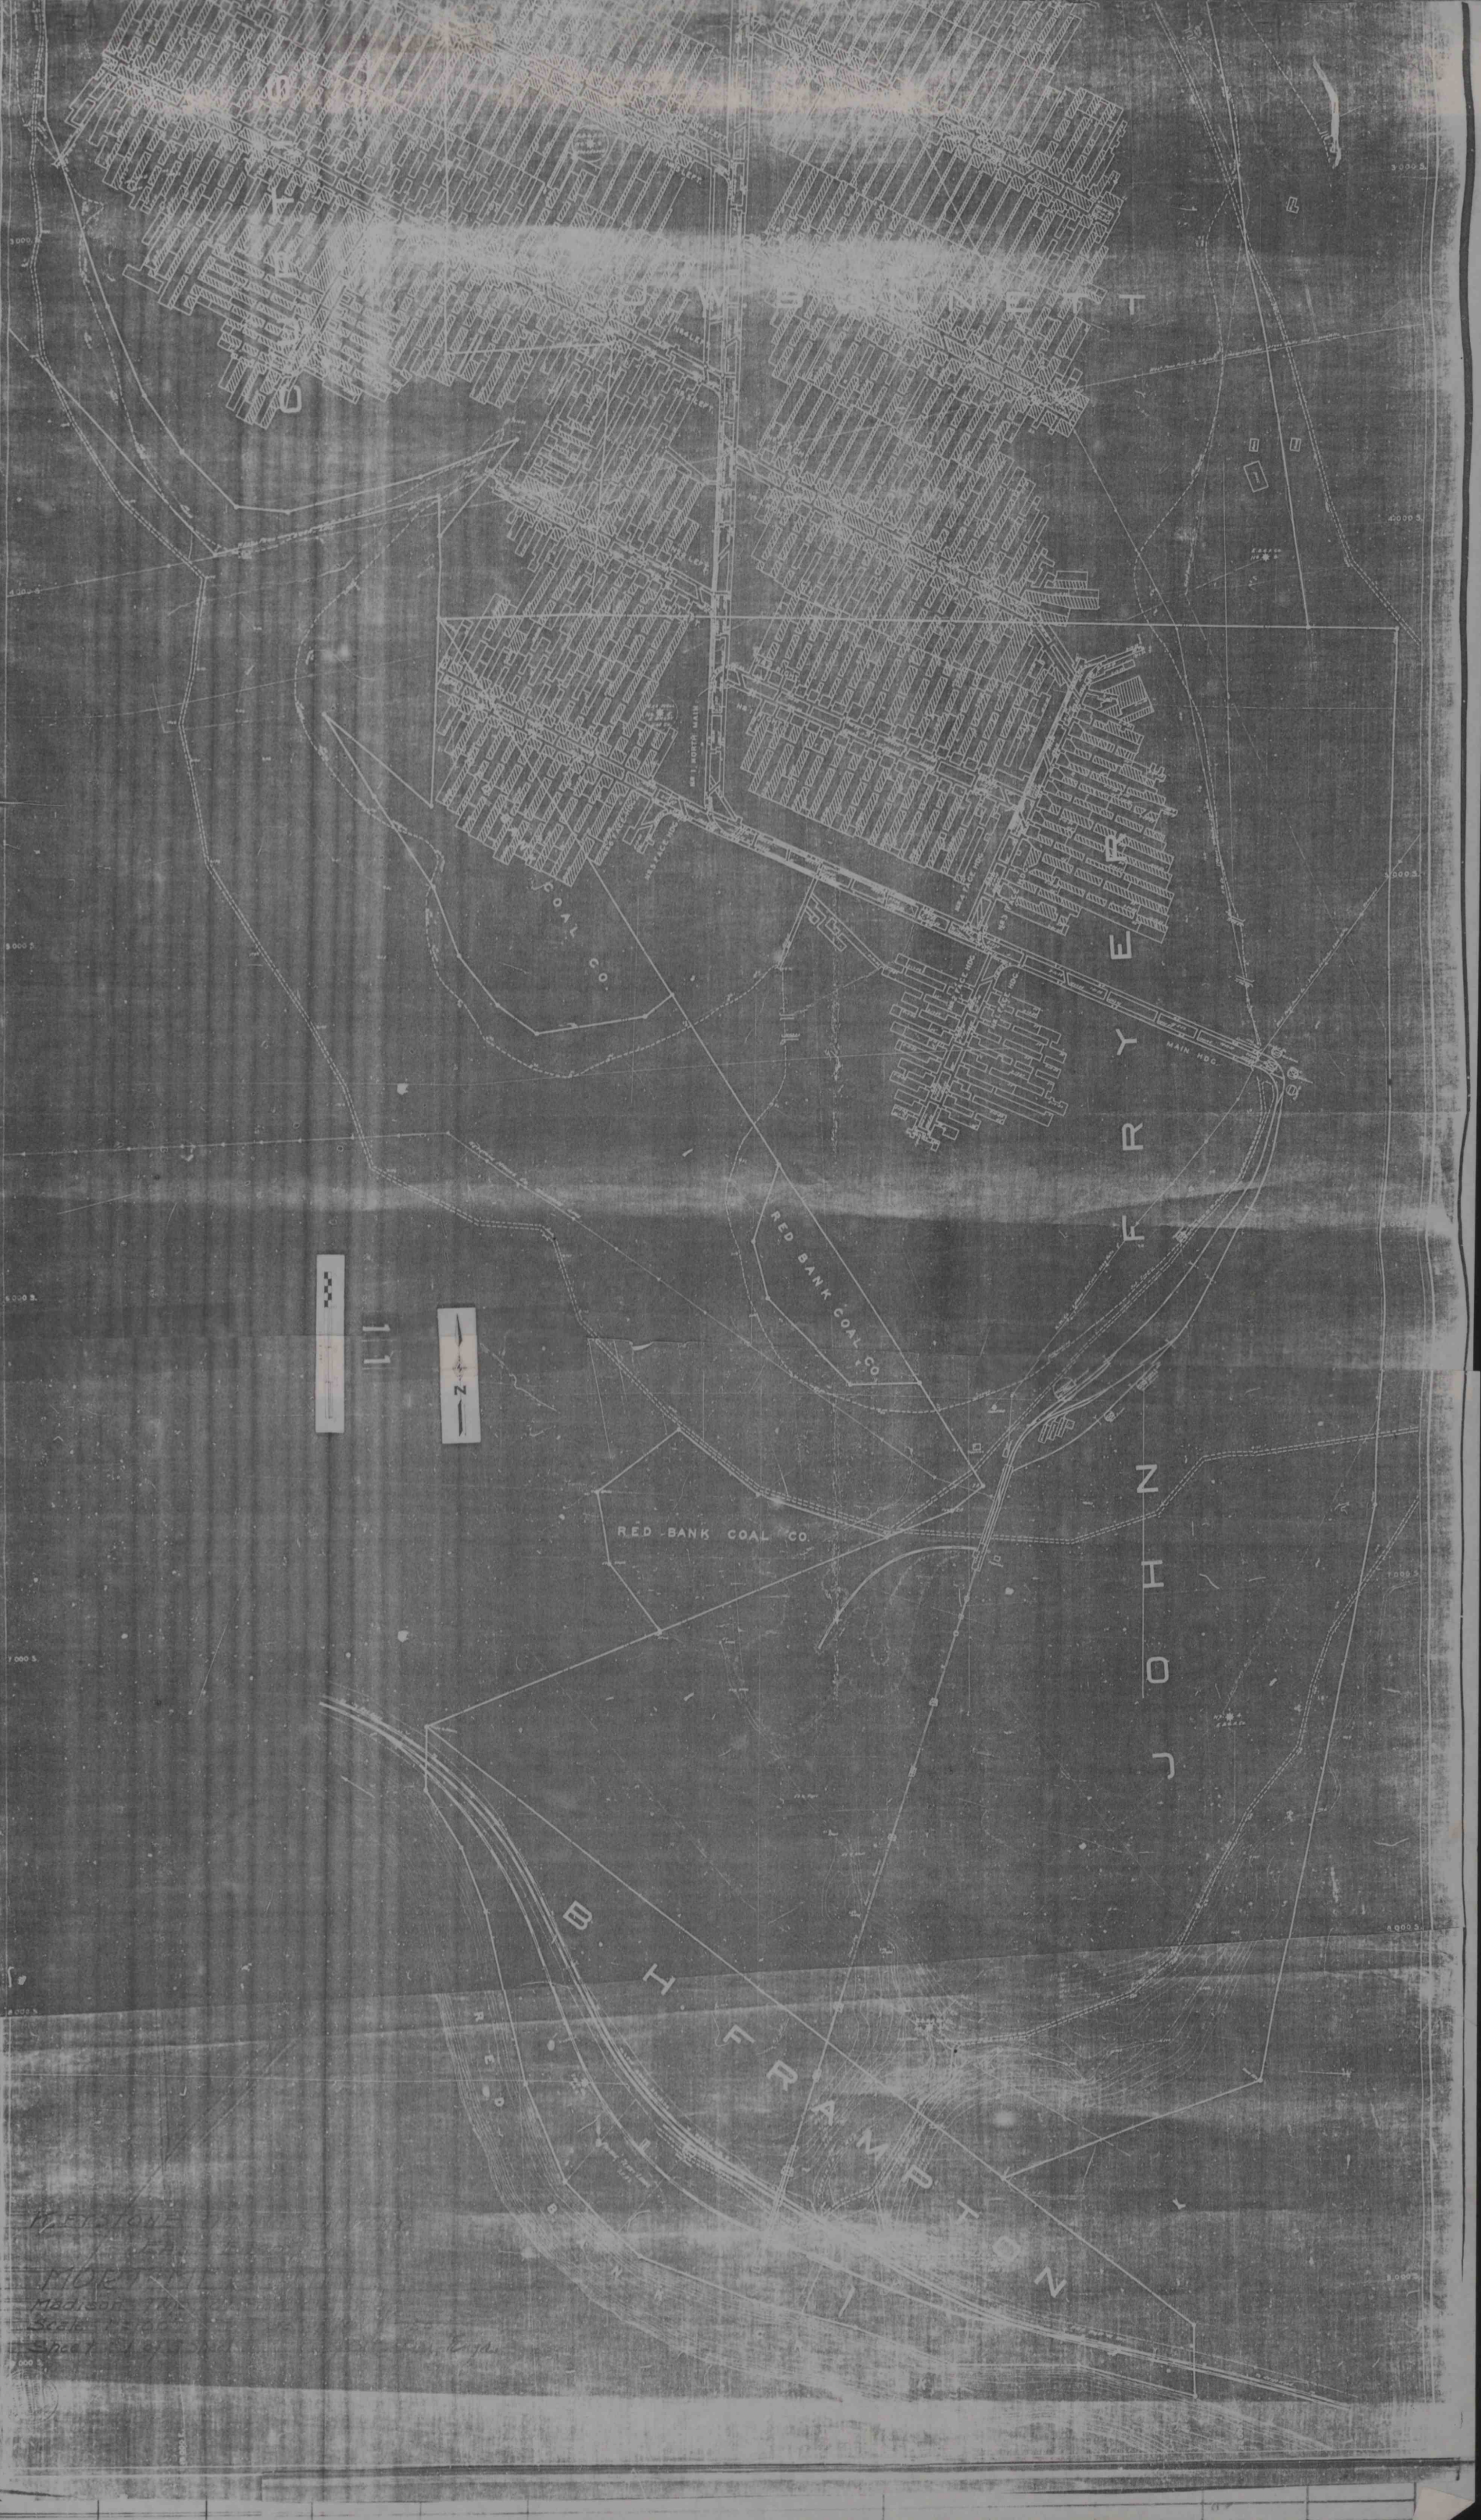

KEYSTONE MINING COMPANY
MORTIMER MINE
Scale 1" = 100'