


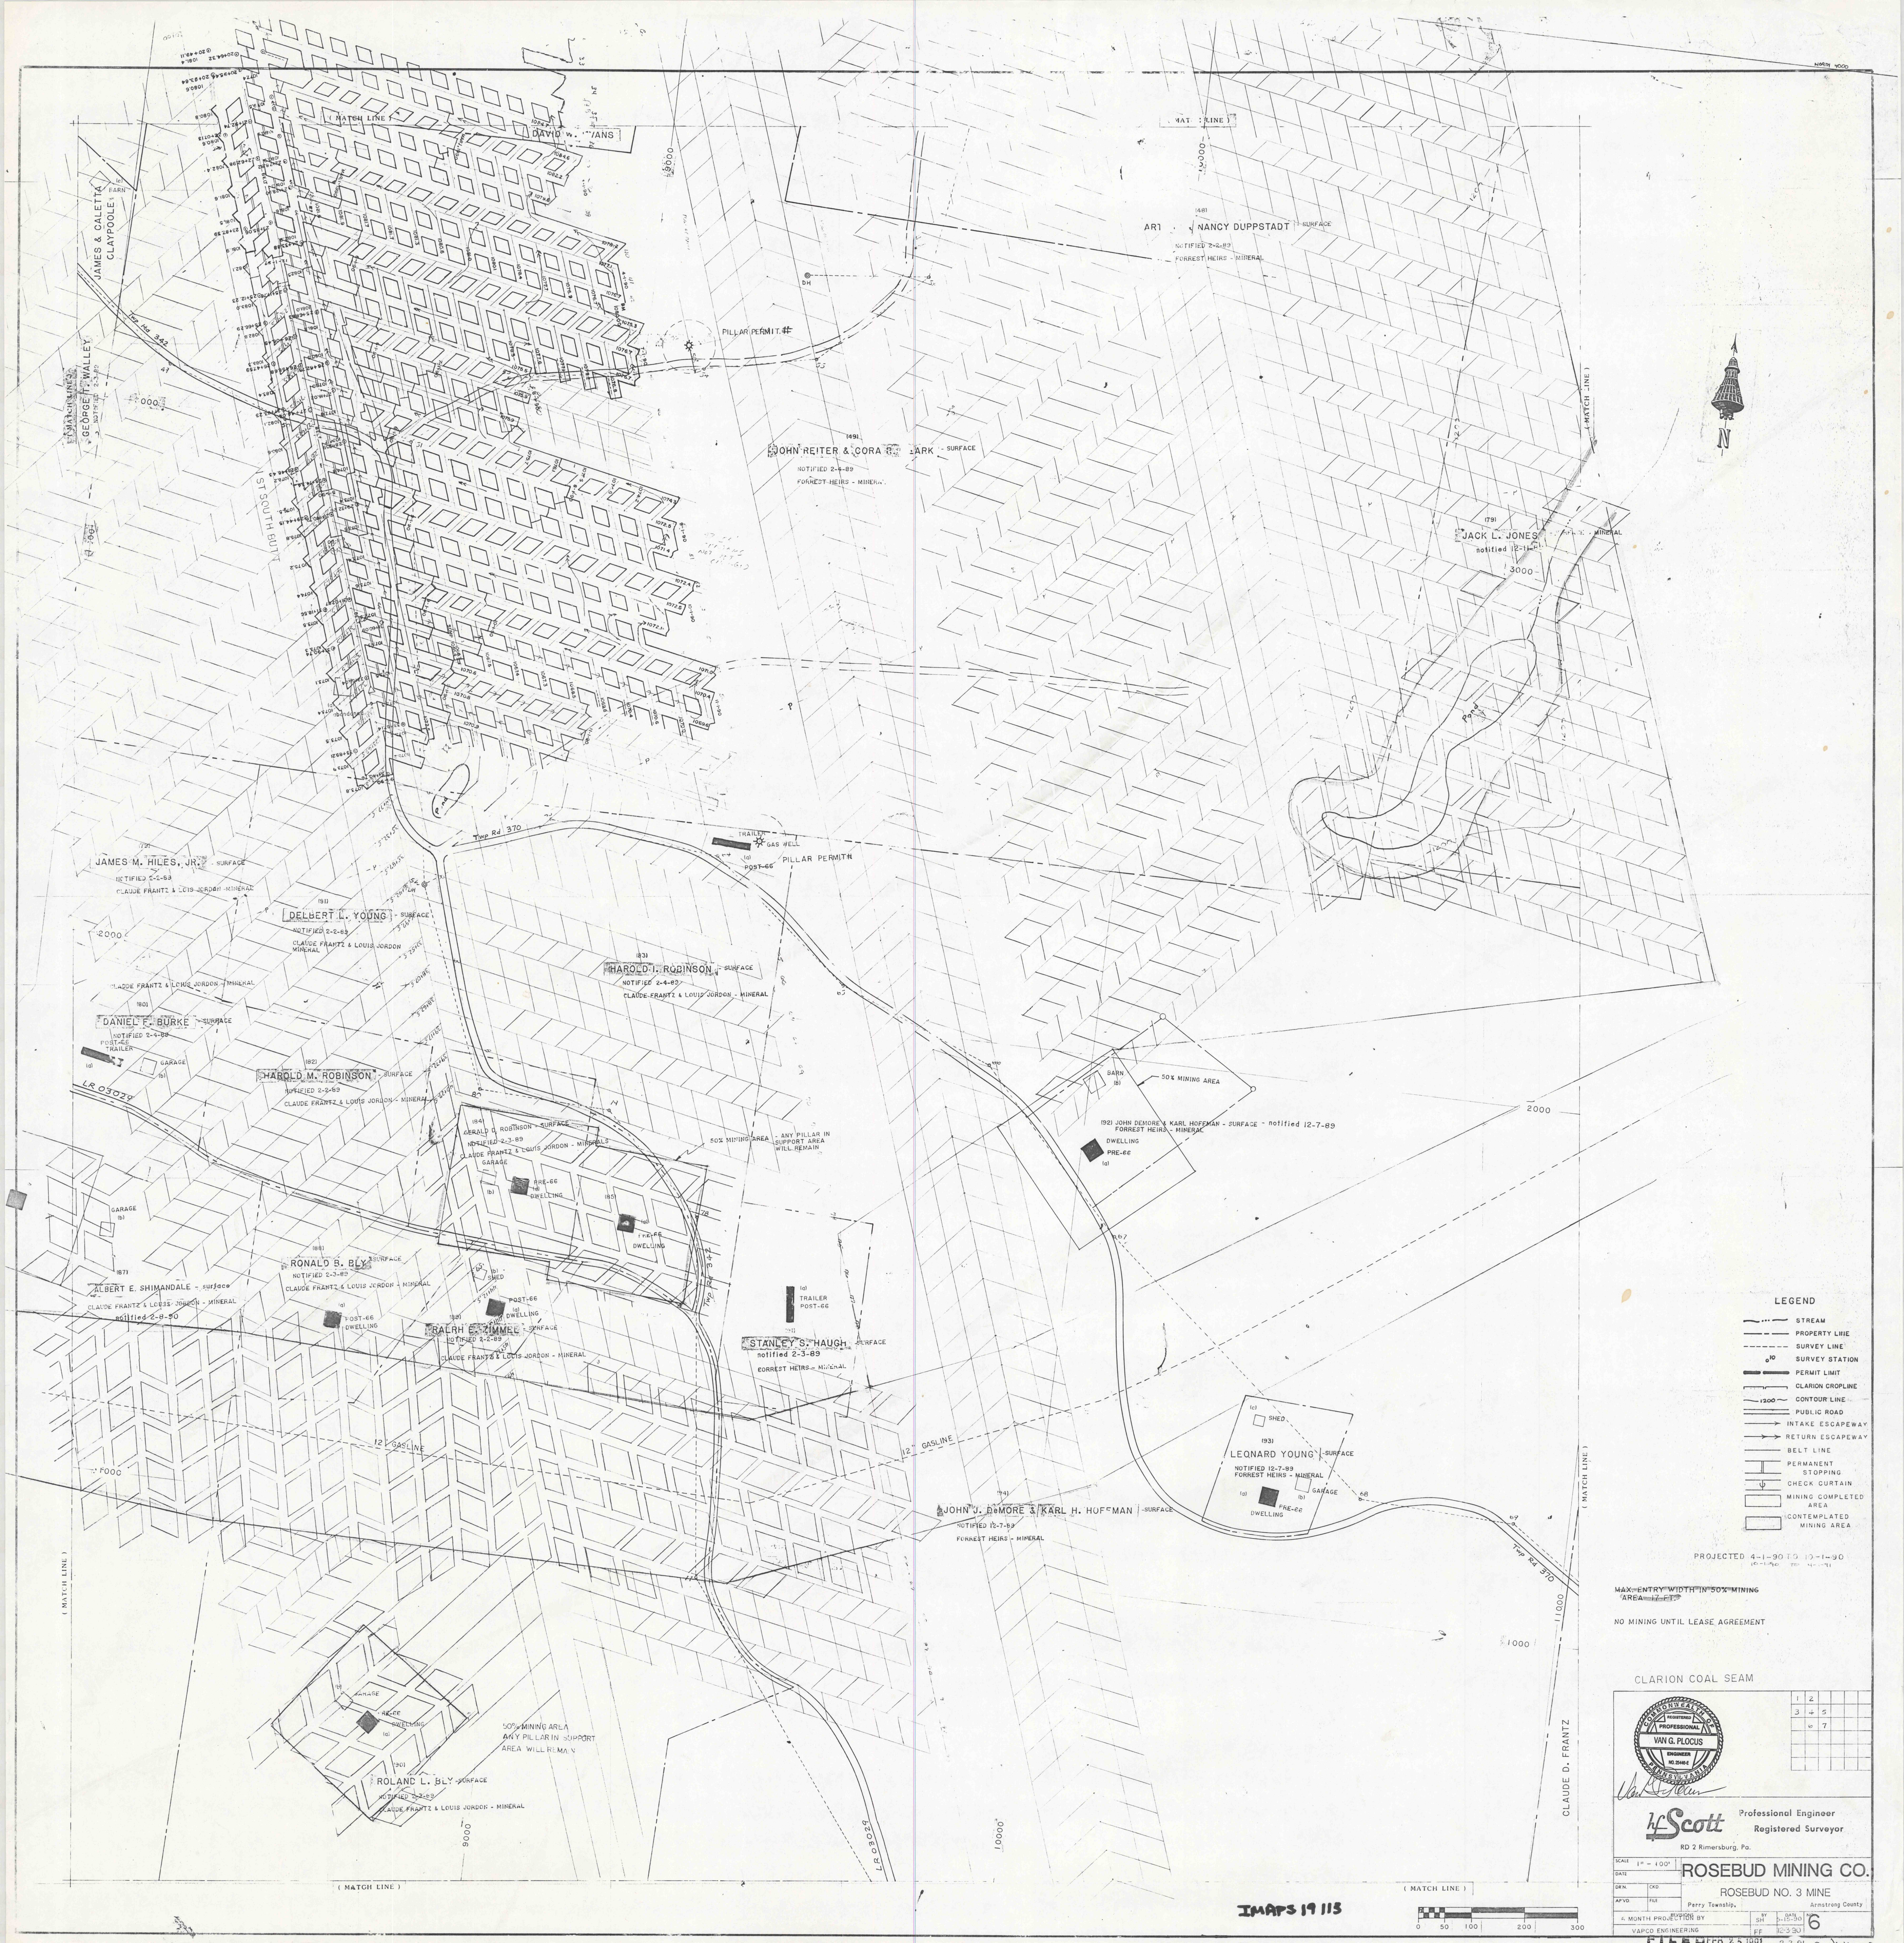

LEGEND


- STREAM
- PROPERTY LINE
- SURVEY LINE
- SURVEY STATION
- PERMIT LIMIT
- CLARION CO. LINE
- CONTOUR LINE
- PUBLIC ROAD
- INTAKE ESCAPEWAY
- RETURN ESCAPEWAY
- BELT LINE
- PERMANENT STOPPING
- CHECK CURTAIN
- MINING COMPLETED AREA
- CONTEMPLATED MINING AREA

PROJECTED 4-1-90 TO 1-1-90

MAX-ENTRY WIDTH IN 50% MINING AREA

NO MINING UNTIL LEASE AGREEMENT

CLARION COAL SEAM

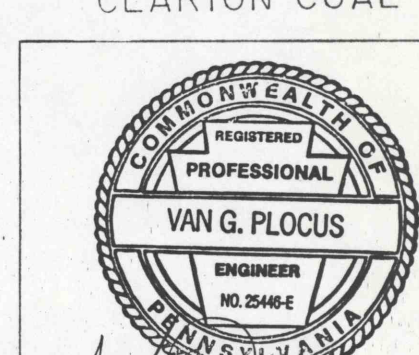

Professional Engineer
Registered Surveyor
RD 2 Rimersburg, Pa.

ROSEBUD MINING CO.
ROSEBUD NO. 3 MINE

APPROVED BY
Perry Township, Armstrong County
6
FILED WITH 25 1991

IMAPS 19 113

