


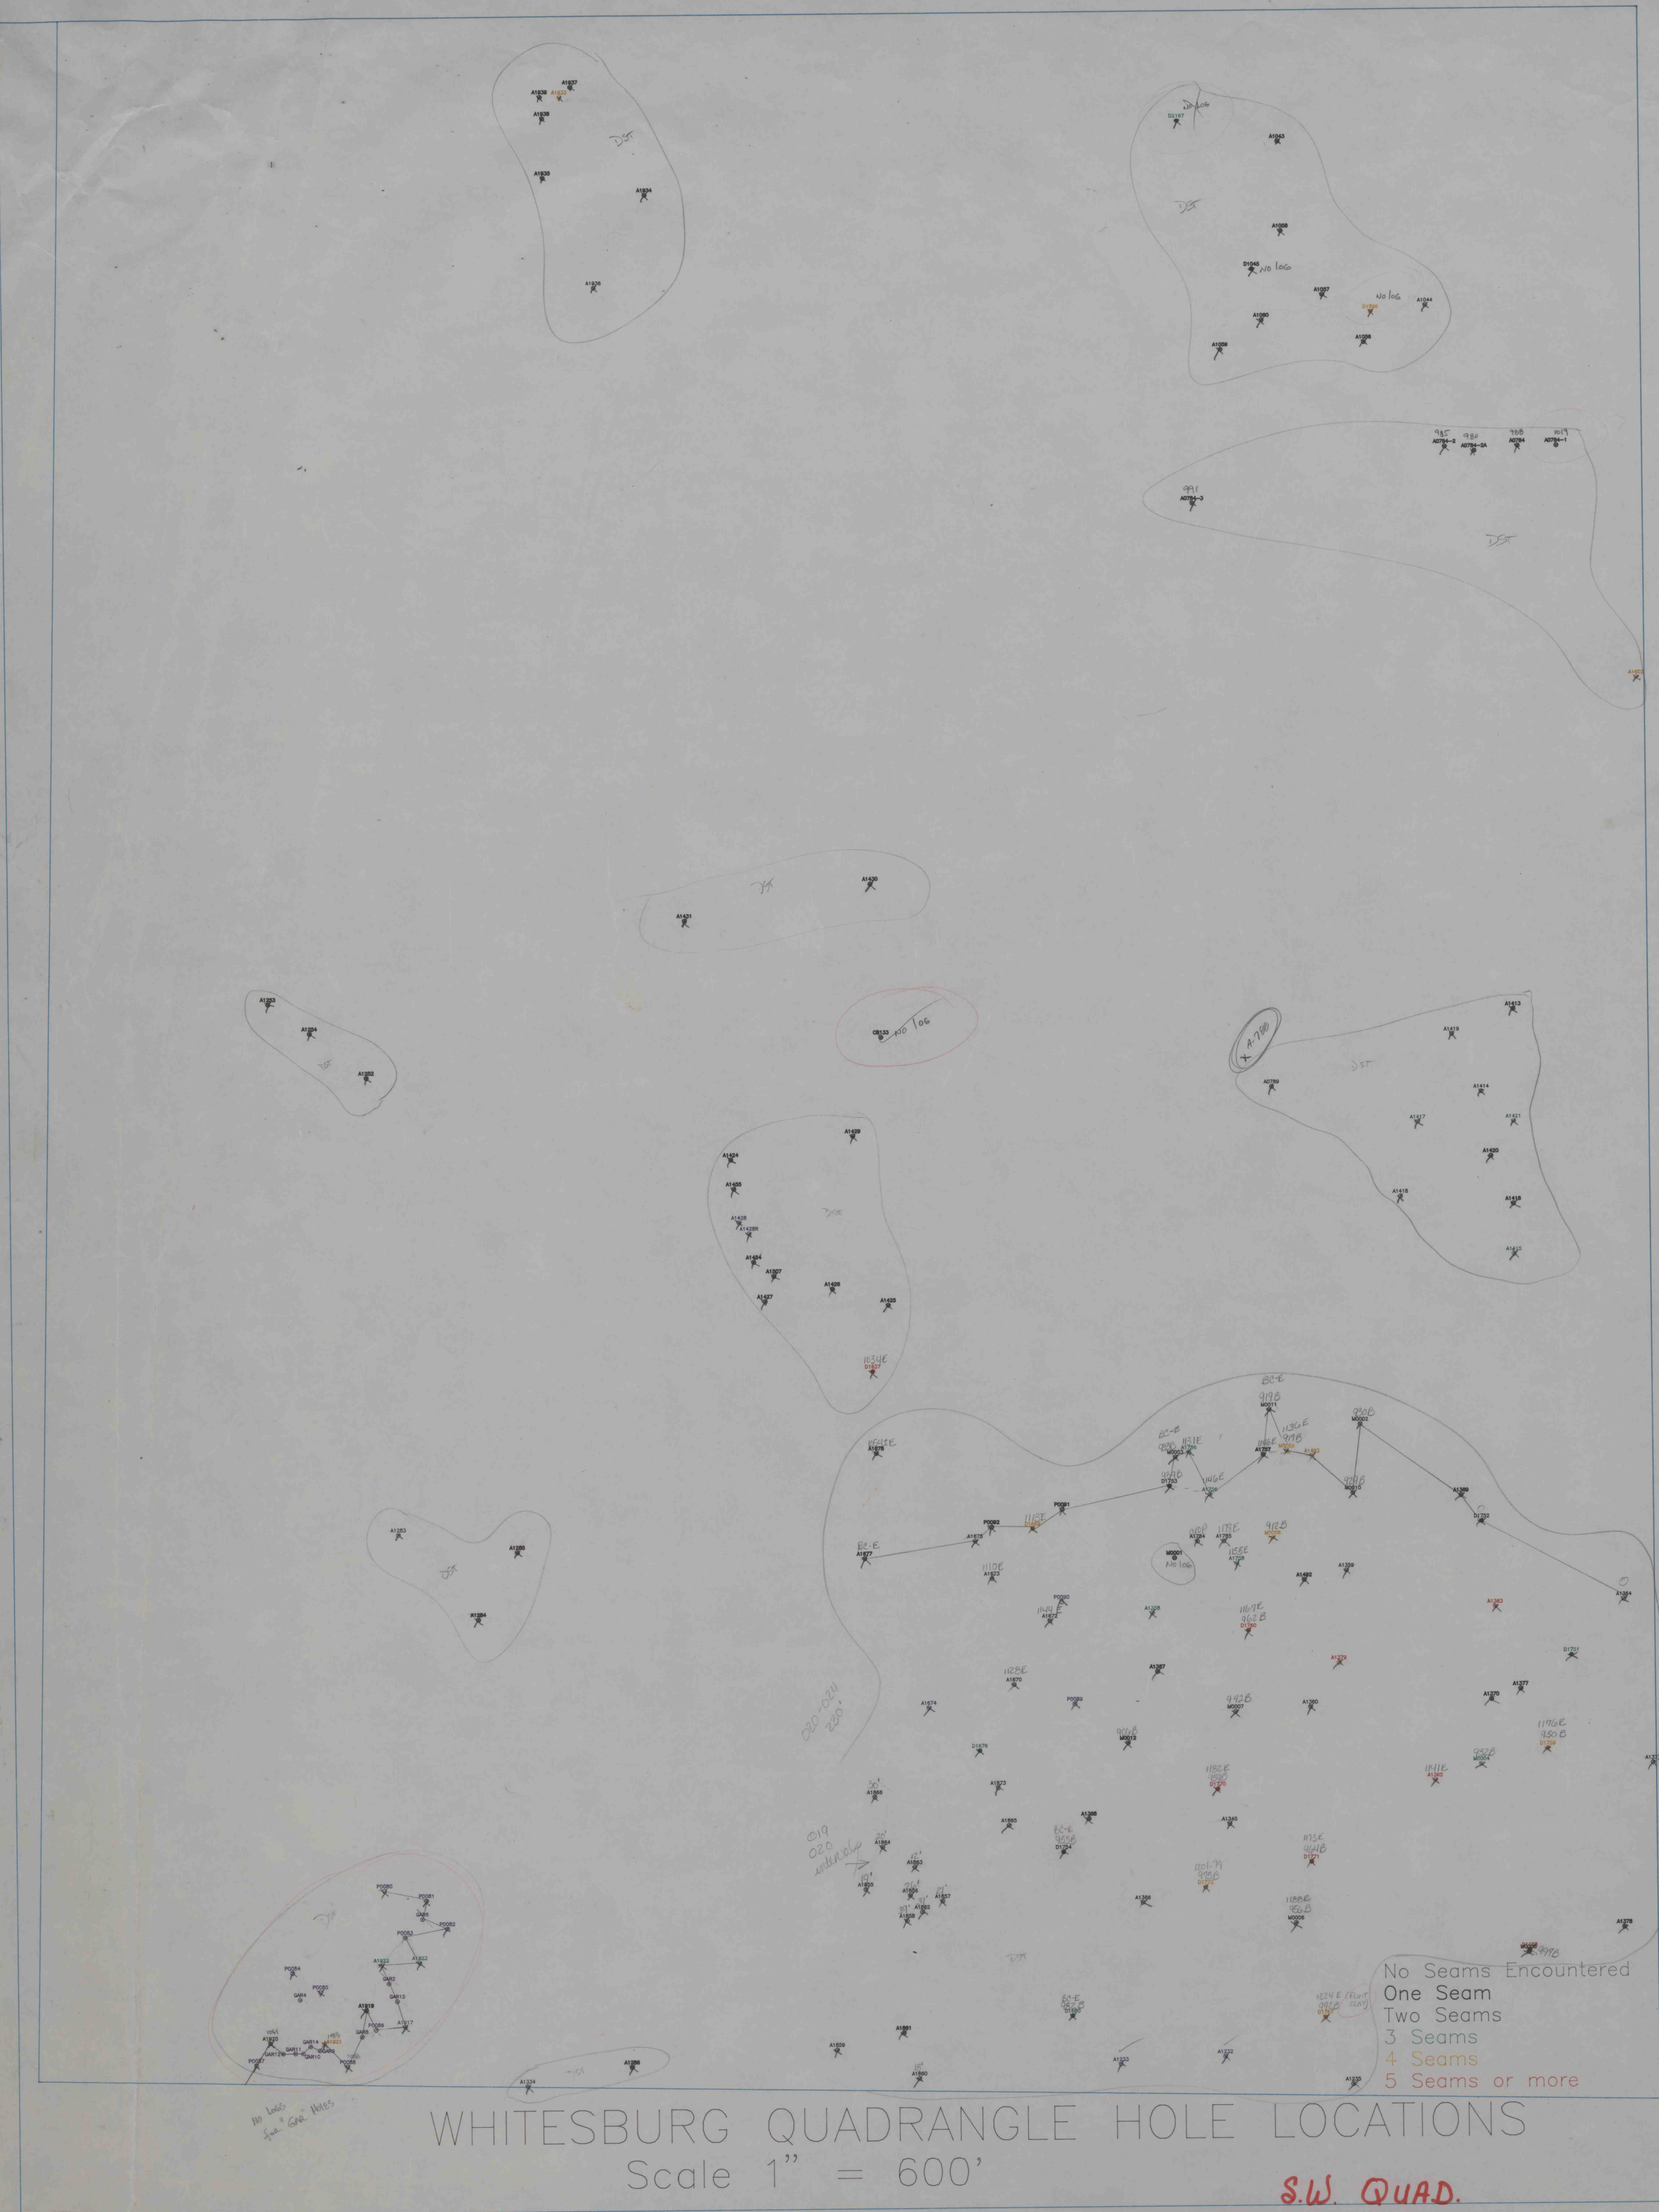



?
?

WHITESBURG QUADRANGLE HOLE LOCATIONS
Scale 1" = 600'

S.W. QUAD.