


Scale 1" = 600'

No Seams Encountered
One Seam
Two Seams
3 Seams
4 Seams
5 Seams or more

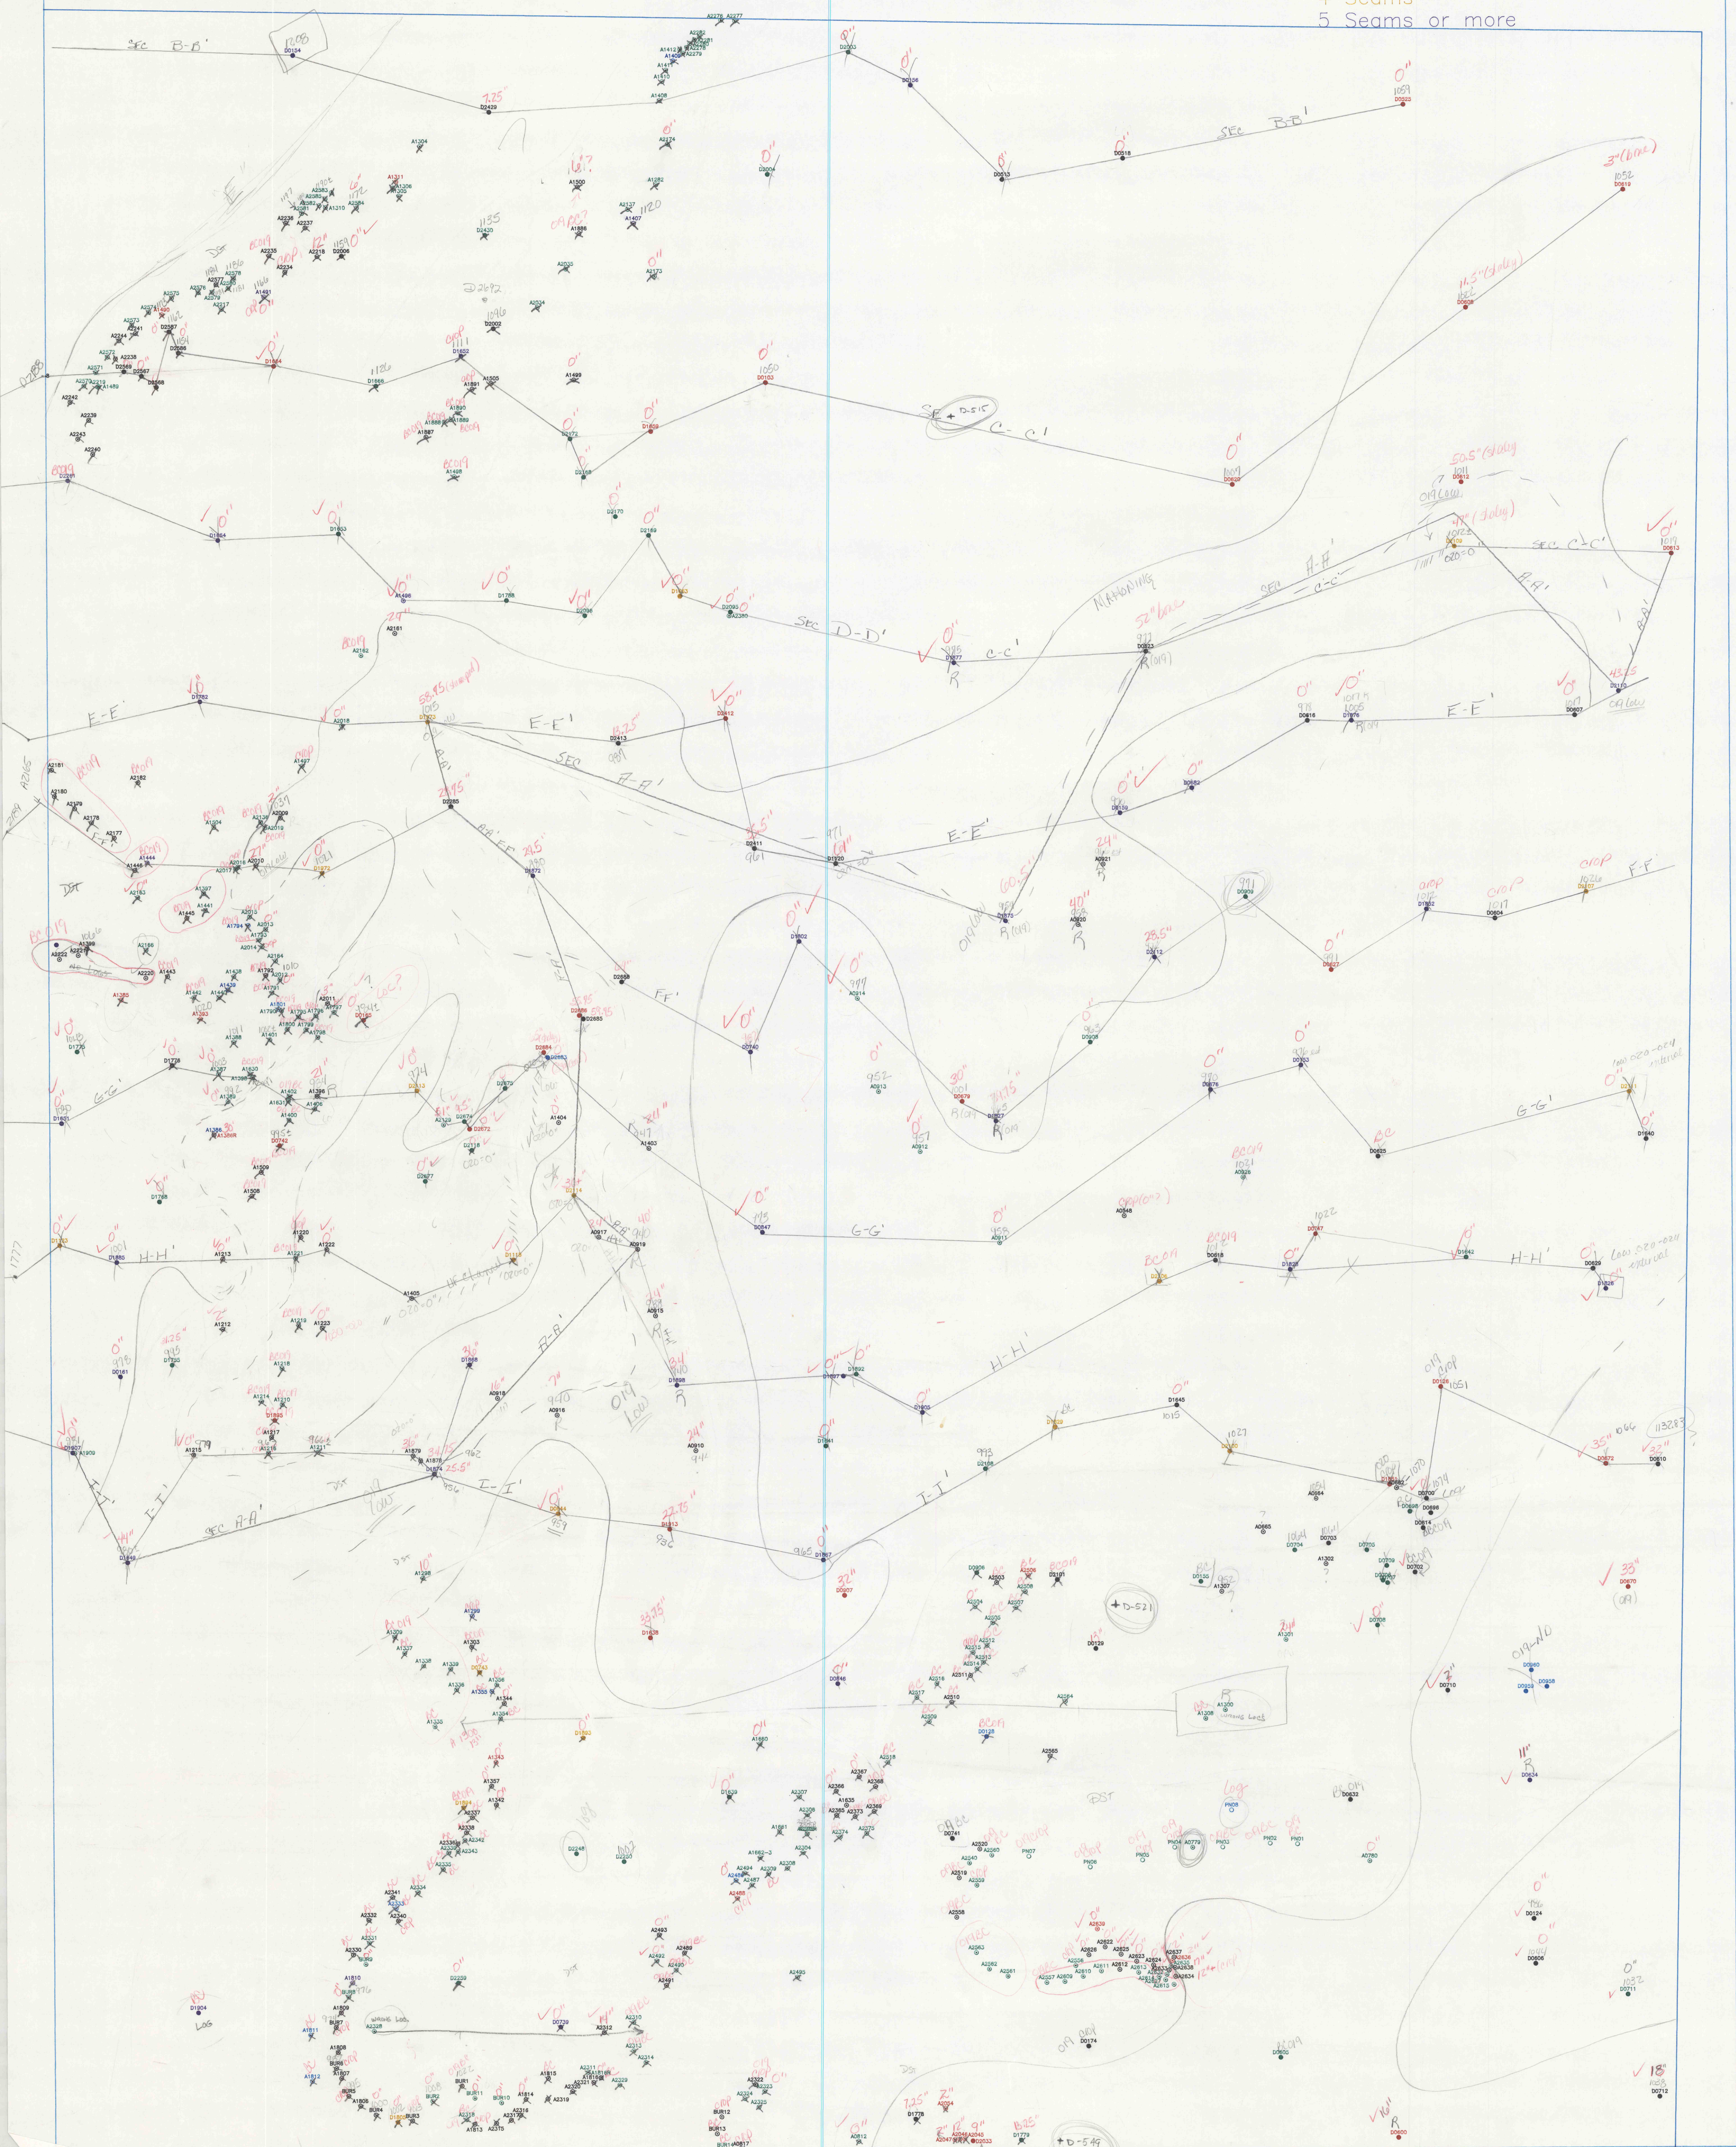

12" - depict 019
slam lbs.

I MAPS # 19116