




**DISTANT DEEP MINE
FINAL MAP**
SCALE 1" = 100'
8/21/89

MON. 2

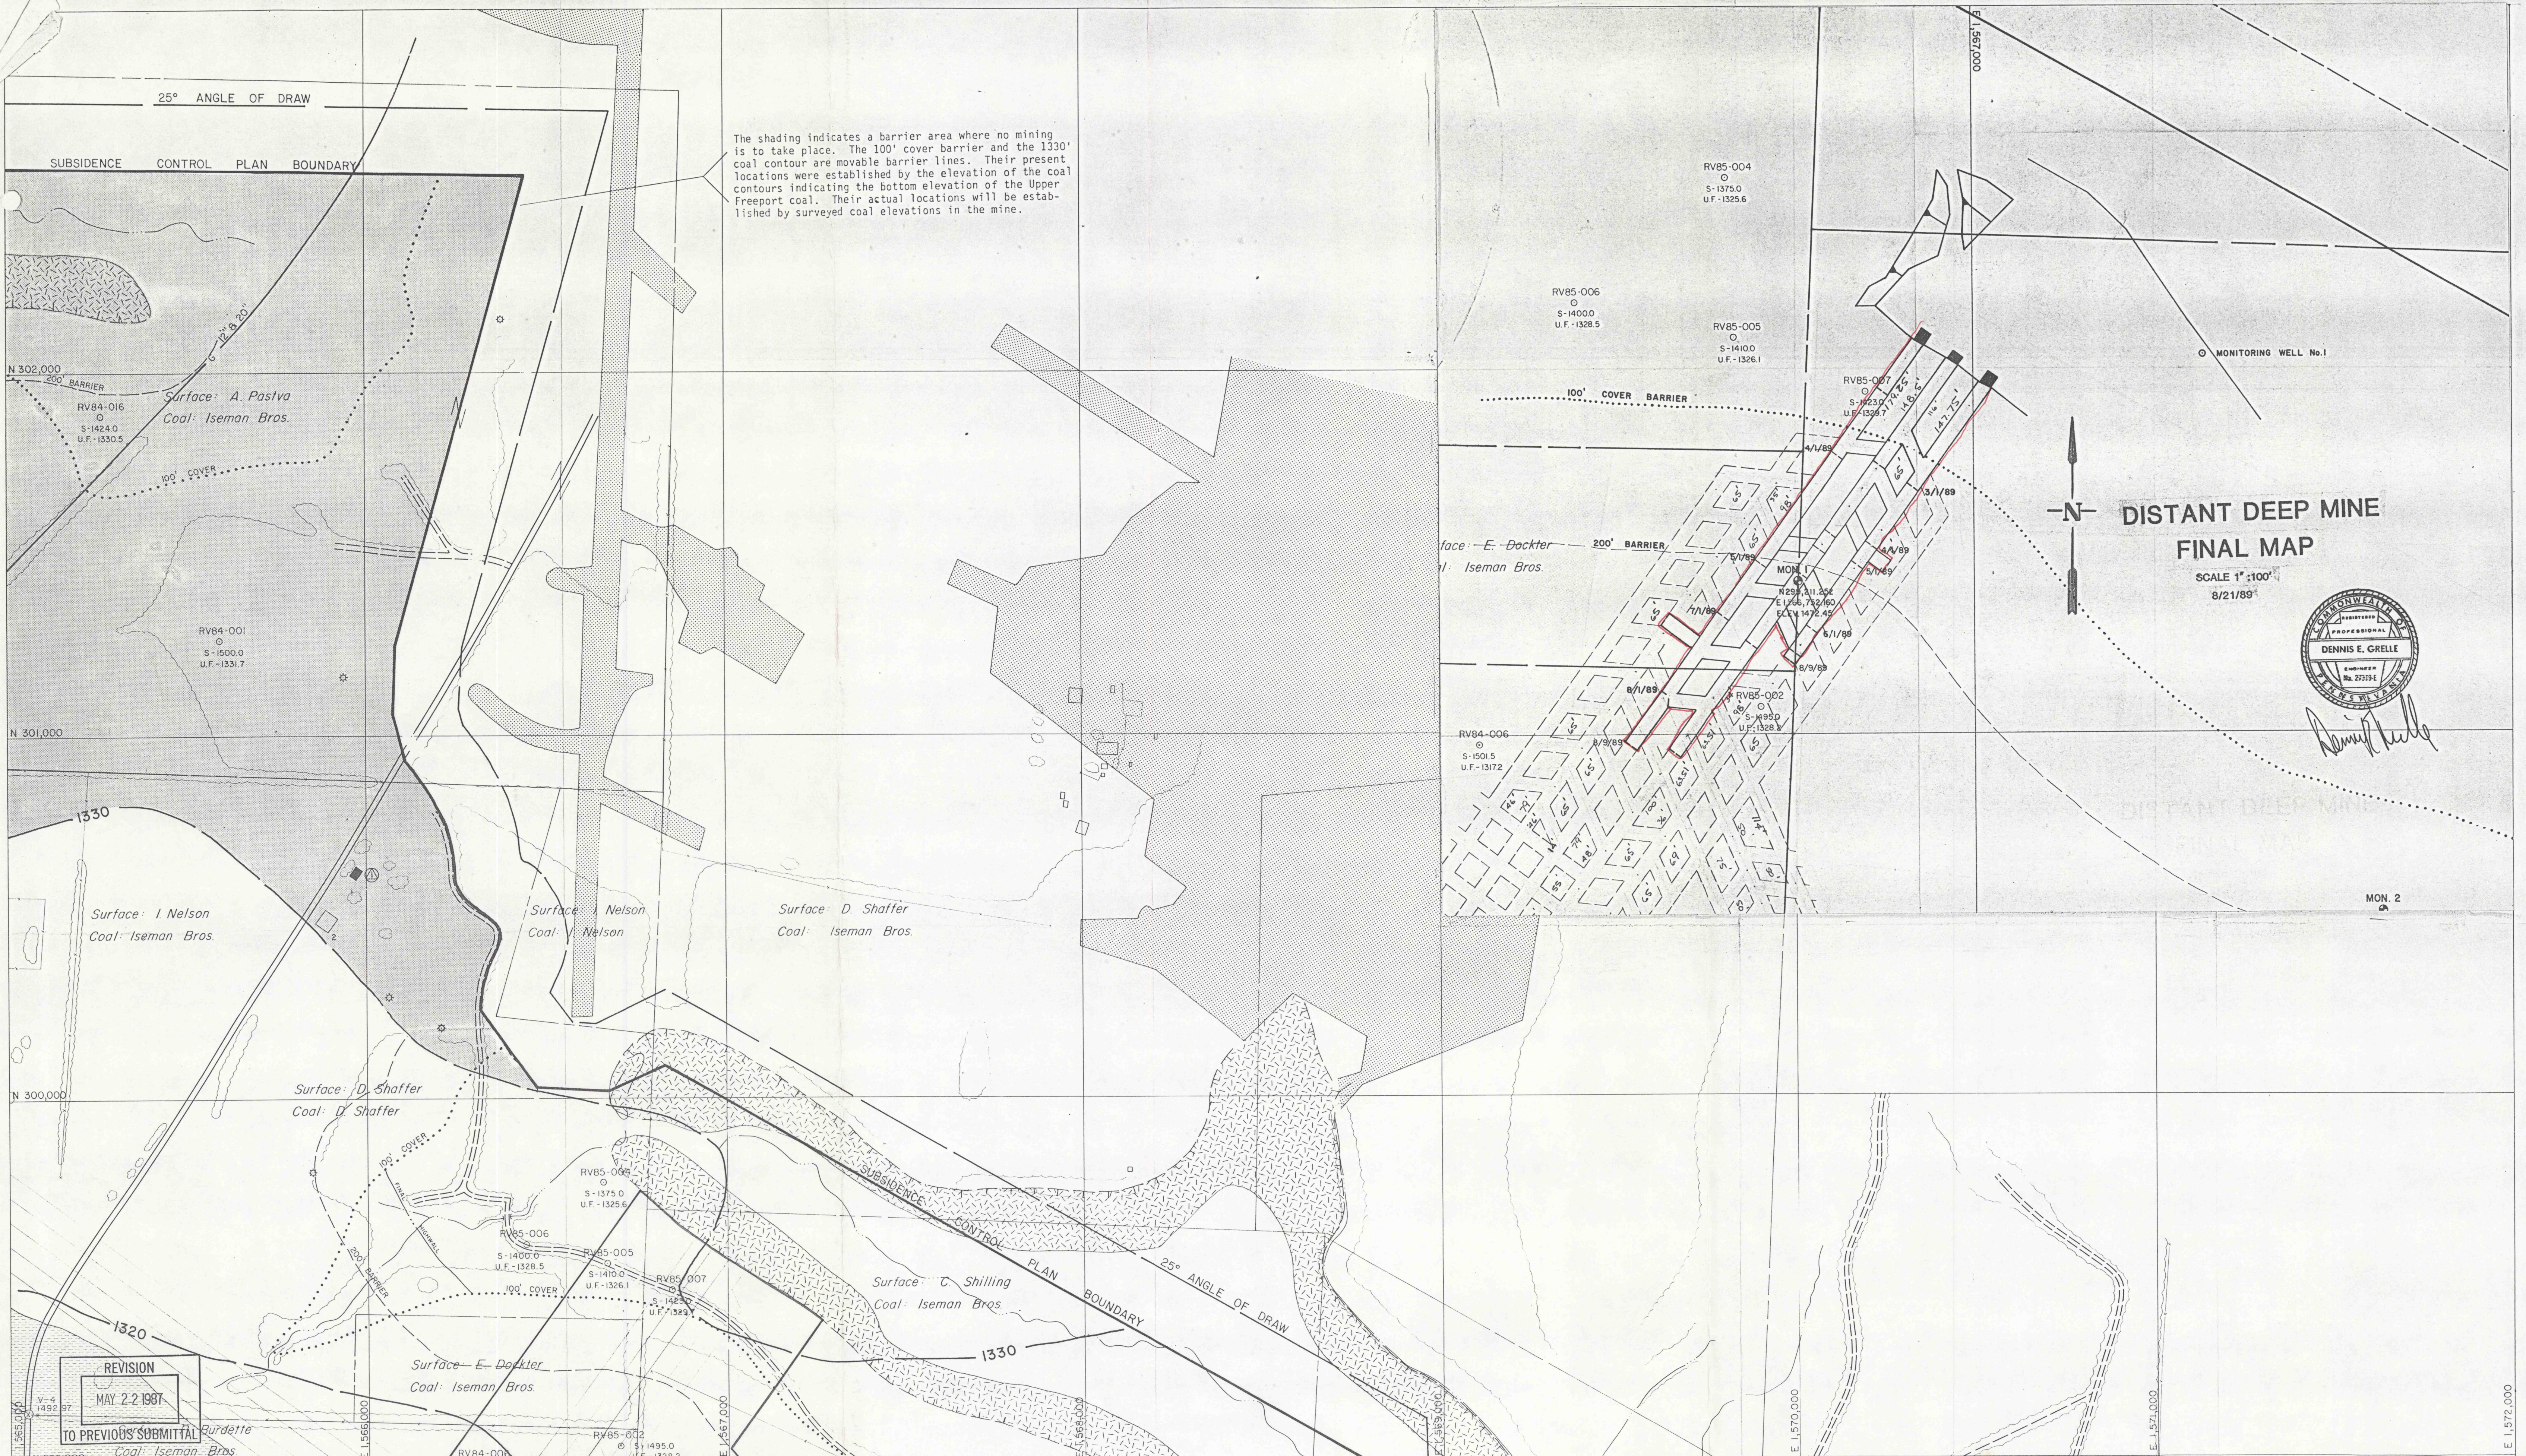

STANFORD
MAHONING TWP. ARMSTRONG CO.
DOVERSPIKE BROS. COAL CO.
R.D. 4 - BOX 271 PUNXSUTAWNEY, PA 15767

DISTANT DEEP MINE
SHEET 2 OF 6 SCALE: 1" = 200'
EXHIBIT "B"

LEGEND

PERMIT BOUNDARY	SURFACE MINE
PROPERTY LINES	GAS LINE
PRE 1966 DWELLINGS	GAS WELL
DWELLINGS	WATER WELL
PUBLIC BUILDINGS	SPRING
HISTORICAL SITE	DRILL HOLE
U.F. COAL CONTOURS	IMPOUNDMENT
U.F. COAL OUTCROP	CEMETERY
U.F. DEEP MINE	MINE OPENINGS, NOT SEALED
CANNEL COAL DEEP MINE	MINE OPENINGS, SEALED

RECEIVED
MAY 26 1987
Dept. of Environmental Resources
McMurray District Office

TO
12-1-88 6-1-89

TO PREVIOUS SUBMITTAL
MAY 22 1987
TO PREVIOUS SUBMITTAL
MAY 22 1987

DOVERSPIKE BROS. COAL CO.
DISTANT DEEP MINE
SCALE: 1" = 200'

DATE: 5/15/87

INTAKE AIR	STOPPING W/ DOOR
RETURN AIR	CHECK CURTAIN
PRIMARY ESCAPEWAY	REGULATOR
SECONDARY ESCAPEWAY	DOUBLE DOORS (Equip. doors)
BELT LINE	OVERCAST
B-E POINTS (Approved)	
B-E POINTS (Proposed)	
STOPPING	

IMAPS # 19118