


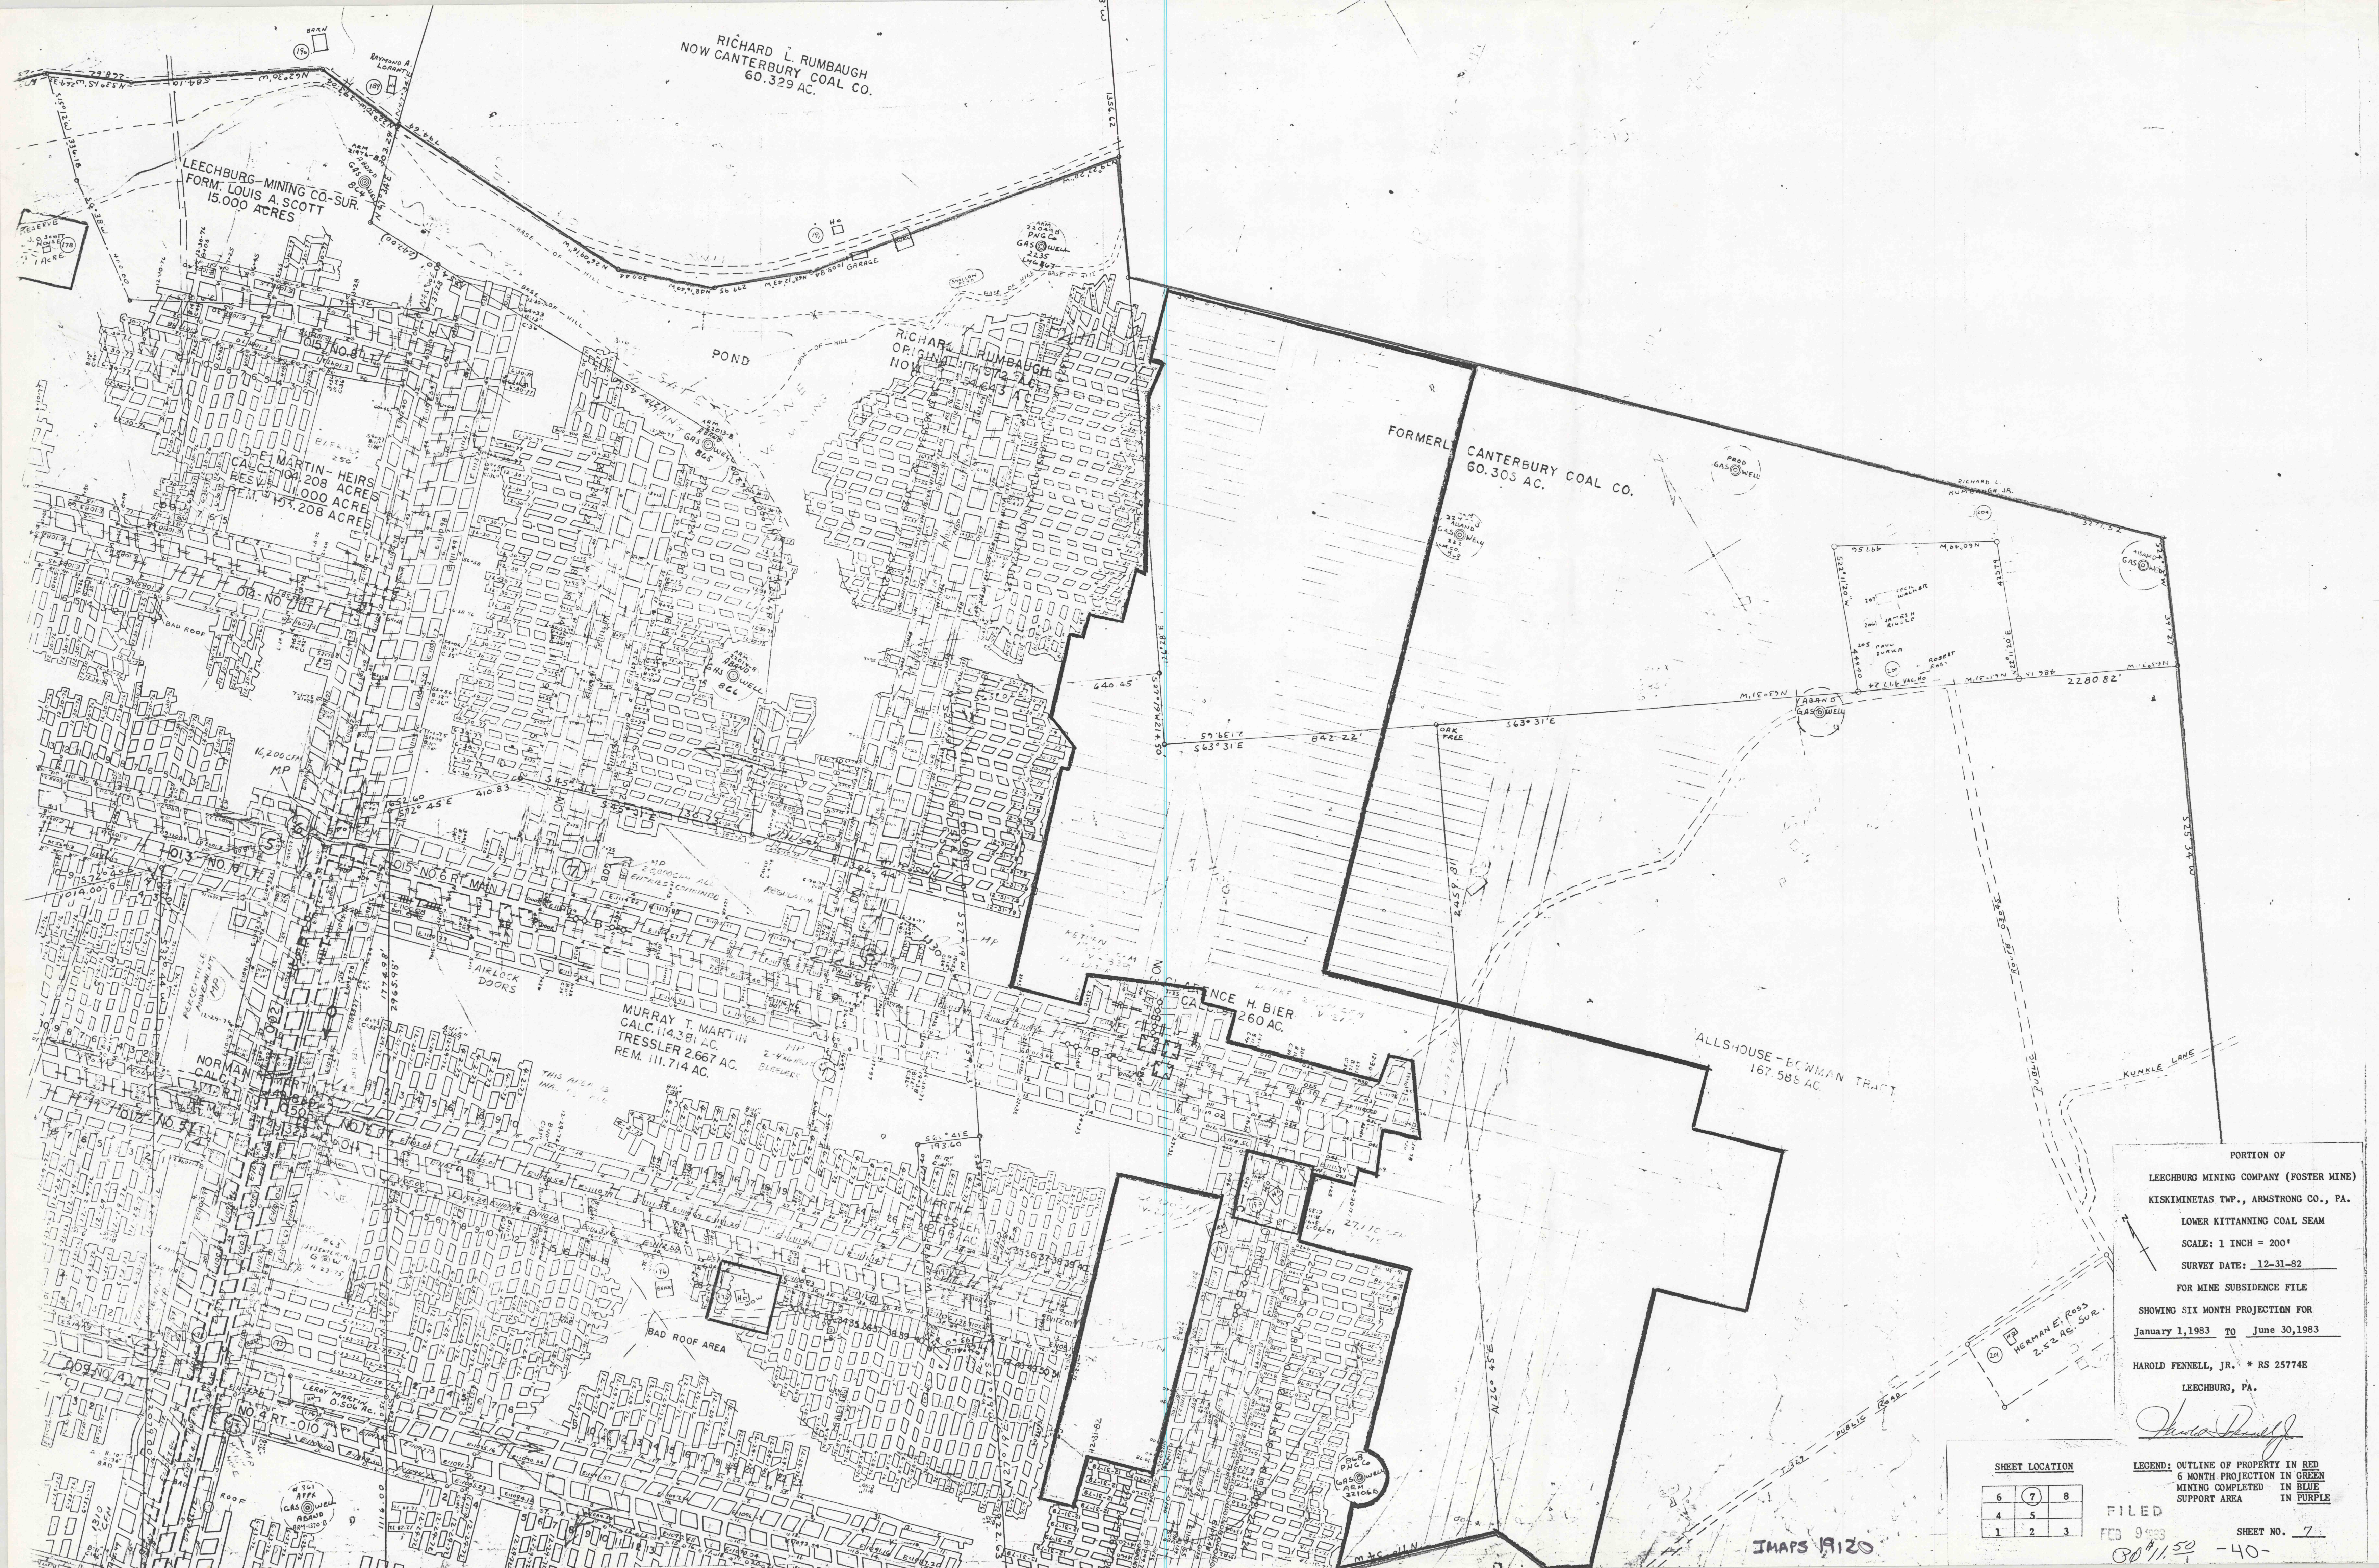

PORTION OF
LEECHBURG MINING COMPANY (FOSTER MINE)
KISKIMINETAS TWP., ARMSTRONG CO., PA.
LOWER KITTANNING COAL SEAM
SCALE: 1 INCH = 200'
SURVEY DATE: 12-31-82
FOR MINE SUBSIDENCE FILE
SHOWING SIX MONTH PROJECTION FOR
January 1, 1983 to June 30, 1983
HAROLD FENNELL, JR. * RS 25774E
LEECHBURG, PA.

SHEET LOCATION		
6	7	8
4	5	
1	2	3

LEGEND: OUTLINE OF PROPERTY IN RED
6 MONTH PROJECTION IN GREEN
MINING COMPLETED IN BLUE
SUPPORT AREA IN PURPLE

FILED
11/15/82
SHEET NO. 7
-40-